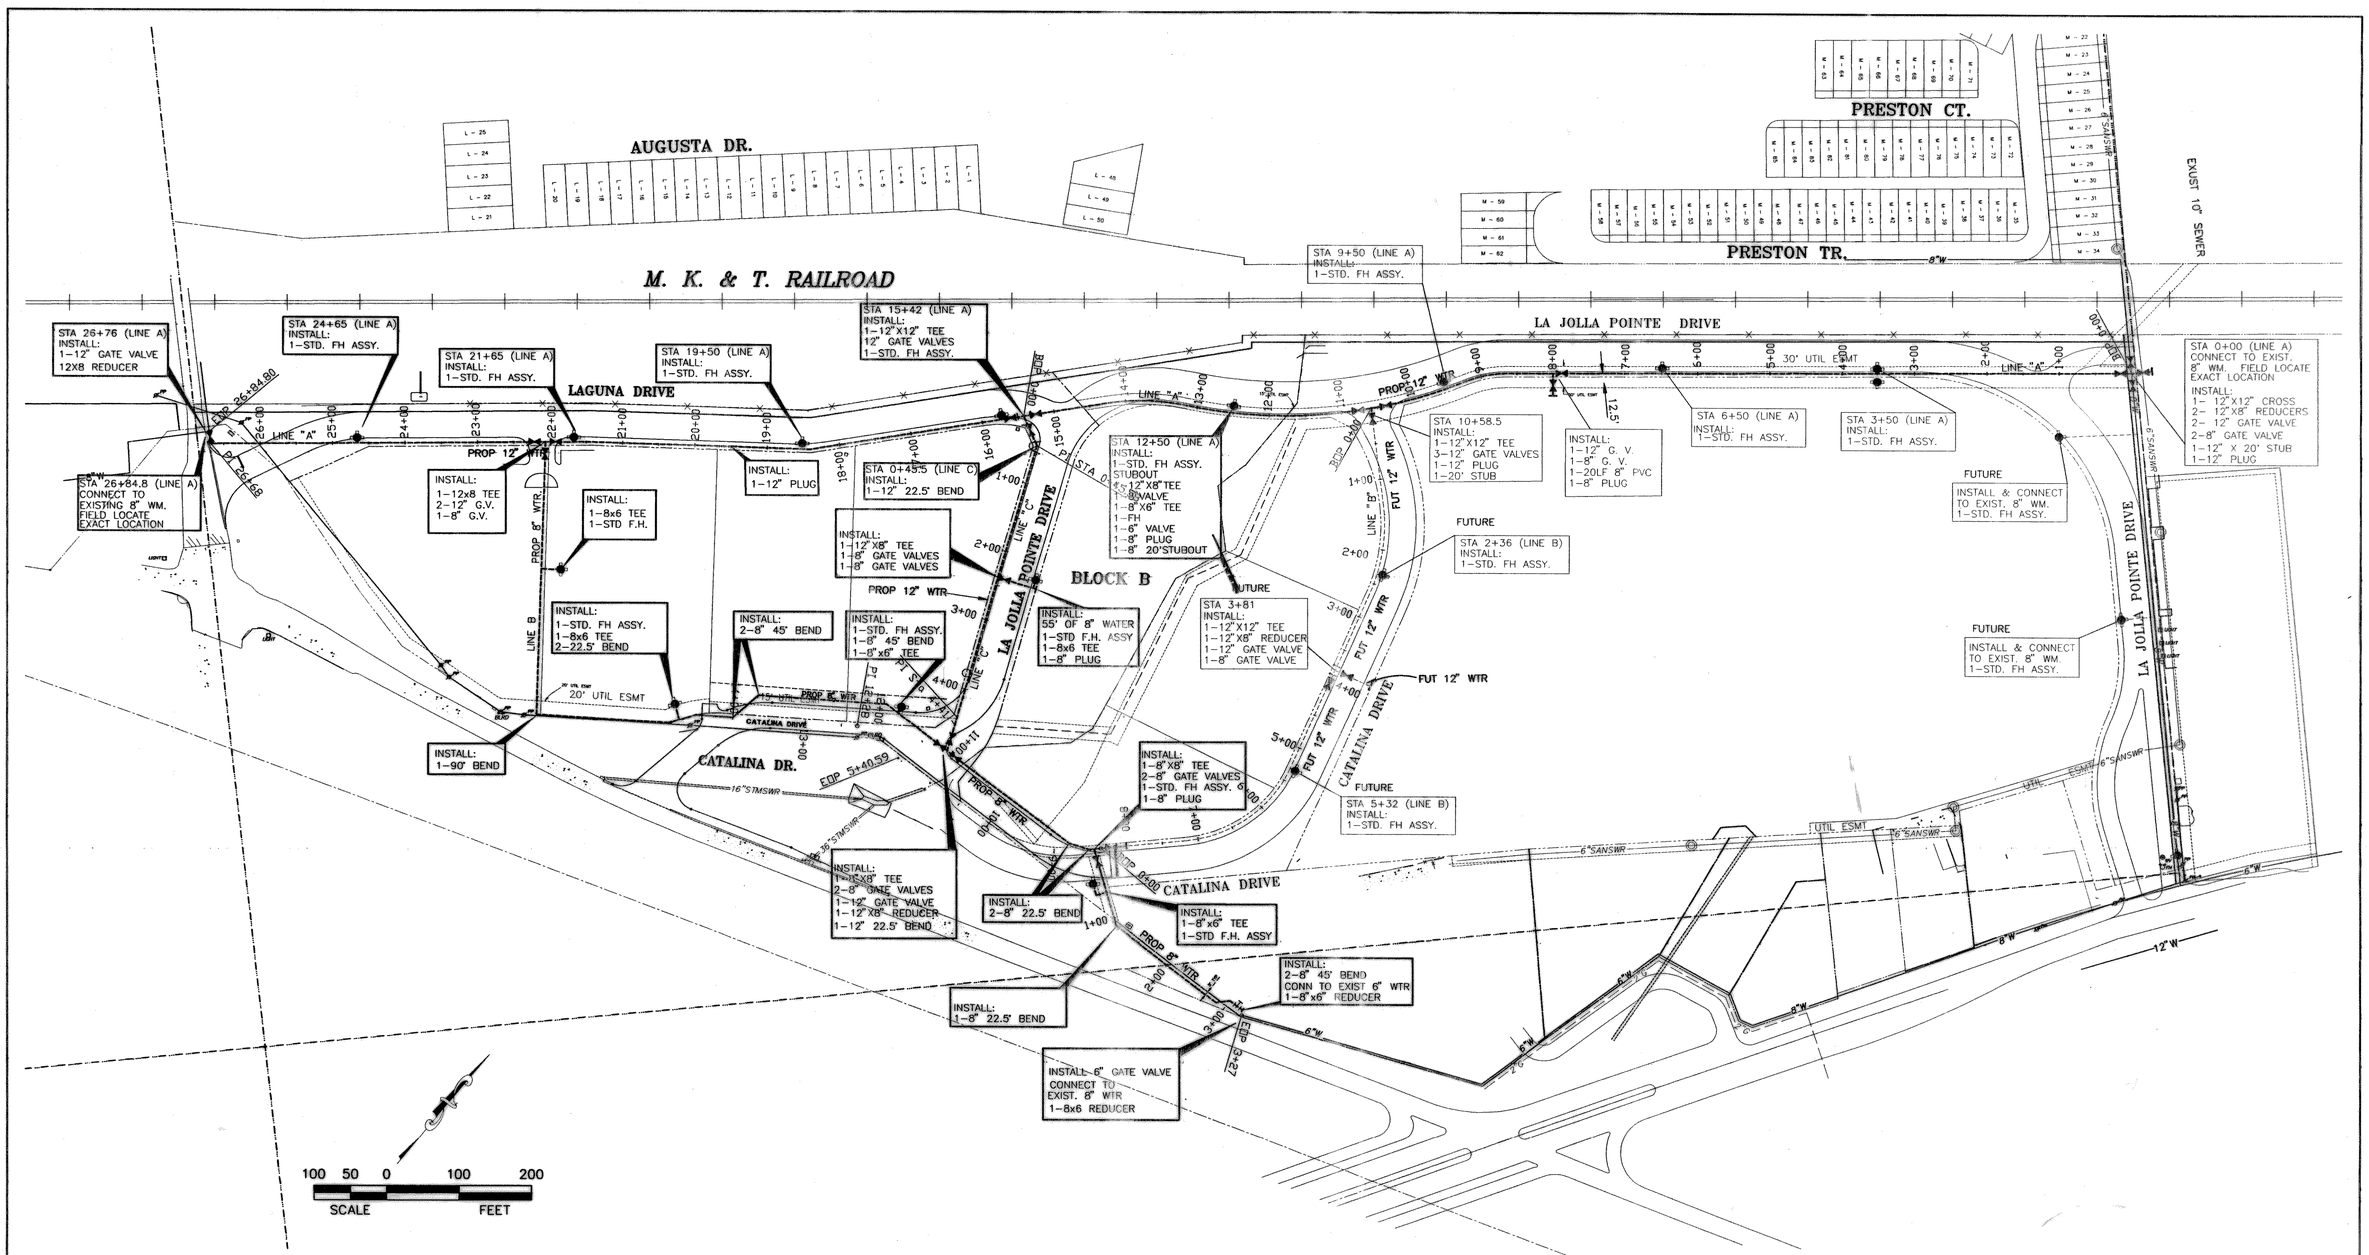

BENCH MARK(S) :

EXISTING SQUARE CUT ON TOP OF WEST CURB OF LAKESIDE DRIVE LOCATED APPROXIMATELY 120 FEET NORTH OF RAILROAD, AT THE NORTHWEST CORNER. ELEV=506.23

LEGEND :

REVISIONS

REV. NO.	DESCRIPTION	DATE	DRWN. BY

STATE OF TEXAS — PANSAK SRIBHEN — 40320 — REGISTERED PROFESSIONAL ENGINEER — 2-21-01

PSA ENGINEERING
17819 DAVENPORT RD, SUITE 215
DALLAS, TEXAS 75252
(972) 248-9651 FAX (972) 248-9681

CITY OF ROCKWALL, TEXAS
LA JOLLA POINTE ADDITION
WATER IMPROVEMENTS PLAN PHASE 1-A

DESIGN	DRAWN	DATE	SCALE	PROJ. No.	SHEET No.
PSA	MIR	2-21-01	1"=100'	2001.LJP	U-1

C:\2000\2001.LJP\CURRENT\U1ANDT-2.dwg Wed Feb 21 15:08:24 2001