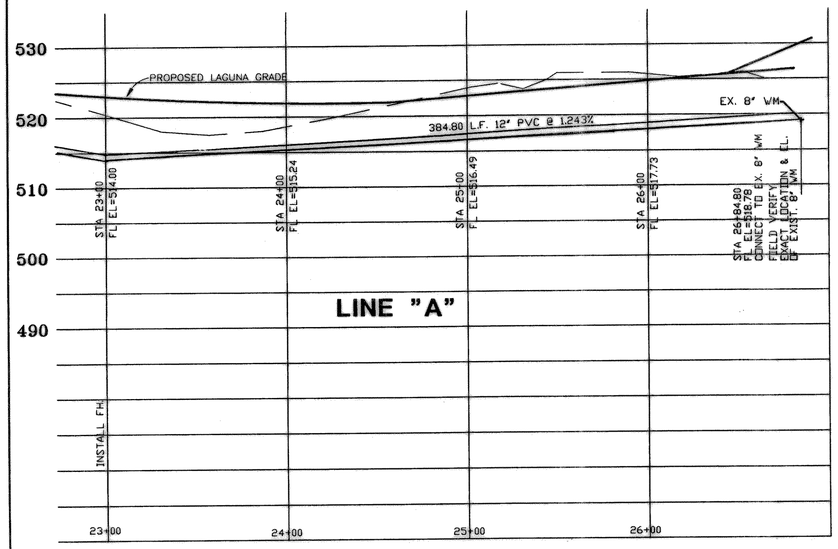

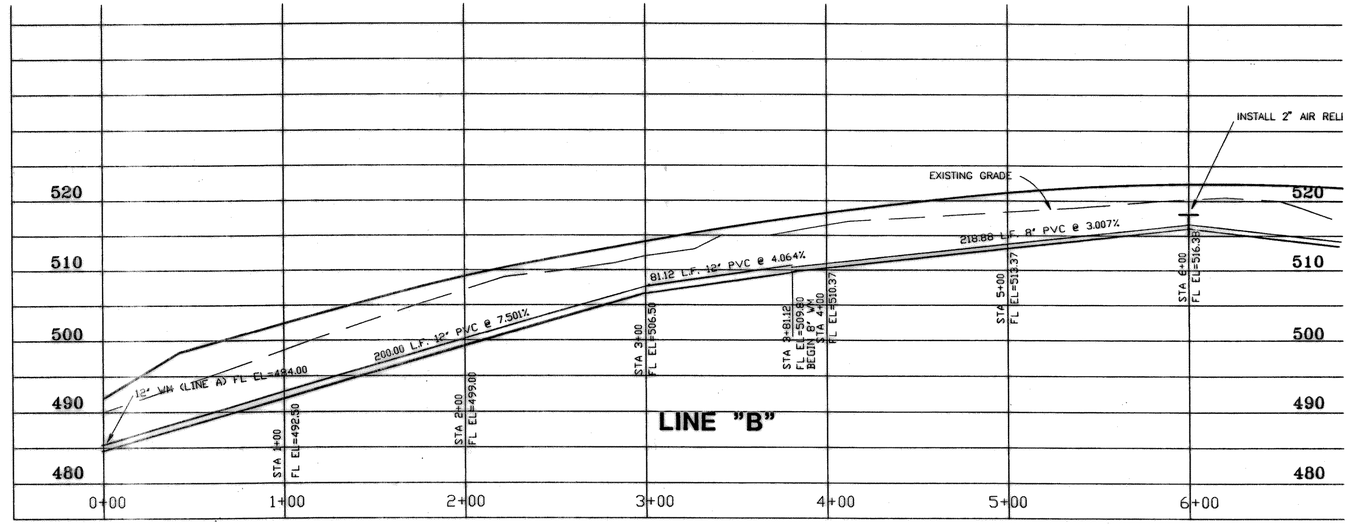

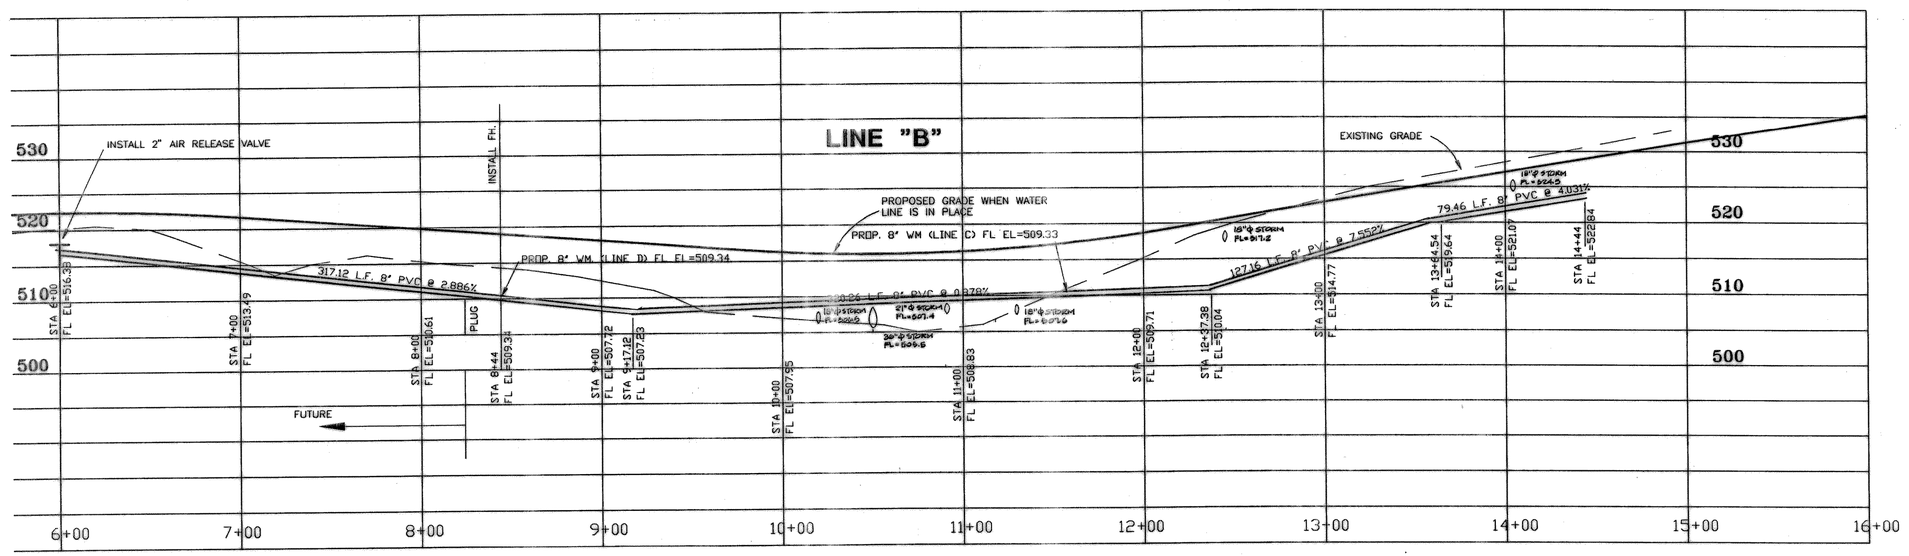

APPROVED FOR CONSTRUCTION

OCT 3 2000

City of Rockwall Engineering Dept.
City Engineer:_____

BENCH MARK(S) :

EXISTING SQUARE CUT ON TOP OF WEST CURB OF LAKESIDE DRIVE LOCATED APPROXIMATELY 120 FEET NORTH OF RAILROAD, AT THE NORTHWEST CORNER. ELEV=506.23

LEGEND :

REVISIONS

REV. NO.	DESCRIPTION	DATE	DRWN. BY

STATE OF TEXAS — PANSAK SRIDHAR 40320 — REGISTERED PROFESSIONAL ENGINEER — 9-21-00

PSA ENGINEERING
17819 DAVENPORT RD, SUITE 215
DALLAS, TEXAS 75252
(972) 248-9651 FAX (972) 248-9681

CITY OF ROCKWALL, TEXAS
LA JOLLA POINTE ADDITION

WATER IMPROVEMENTS
LINE 'A' AND LINE 'B'

DESIGN	DRAWN	DATE	SCALE	PROJ. No.	SHEET No.
PSA	PSA	9-21-00	H:1"=40' V:1"=10'	2001.LJP	U-4

C:\2000\2001.LJP\CURRENT\U:1lity-R.dwg Thu Sep 21 07:11:03 2000