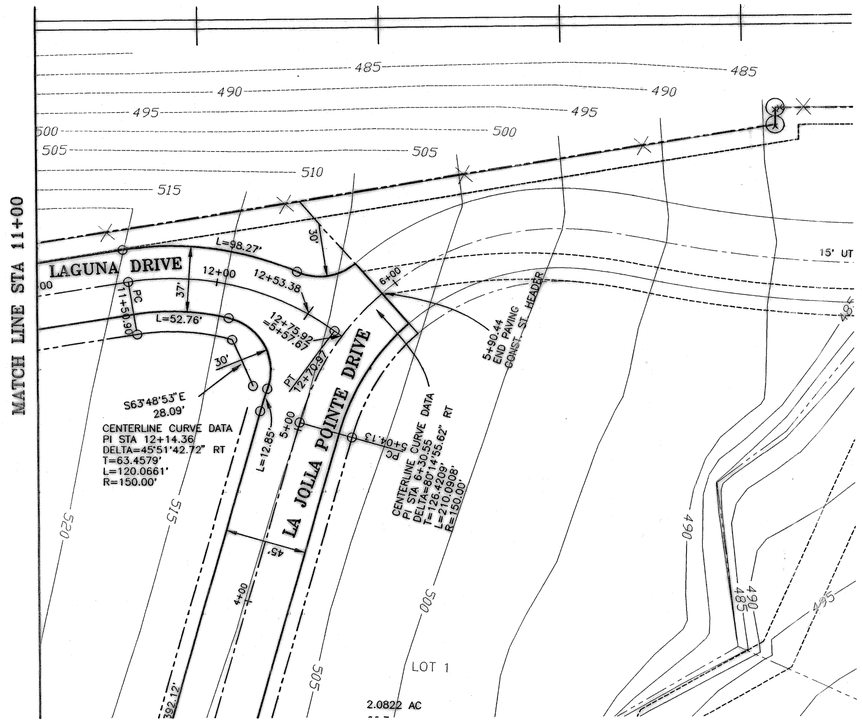

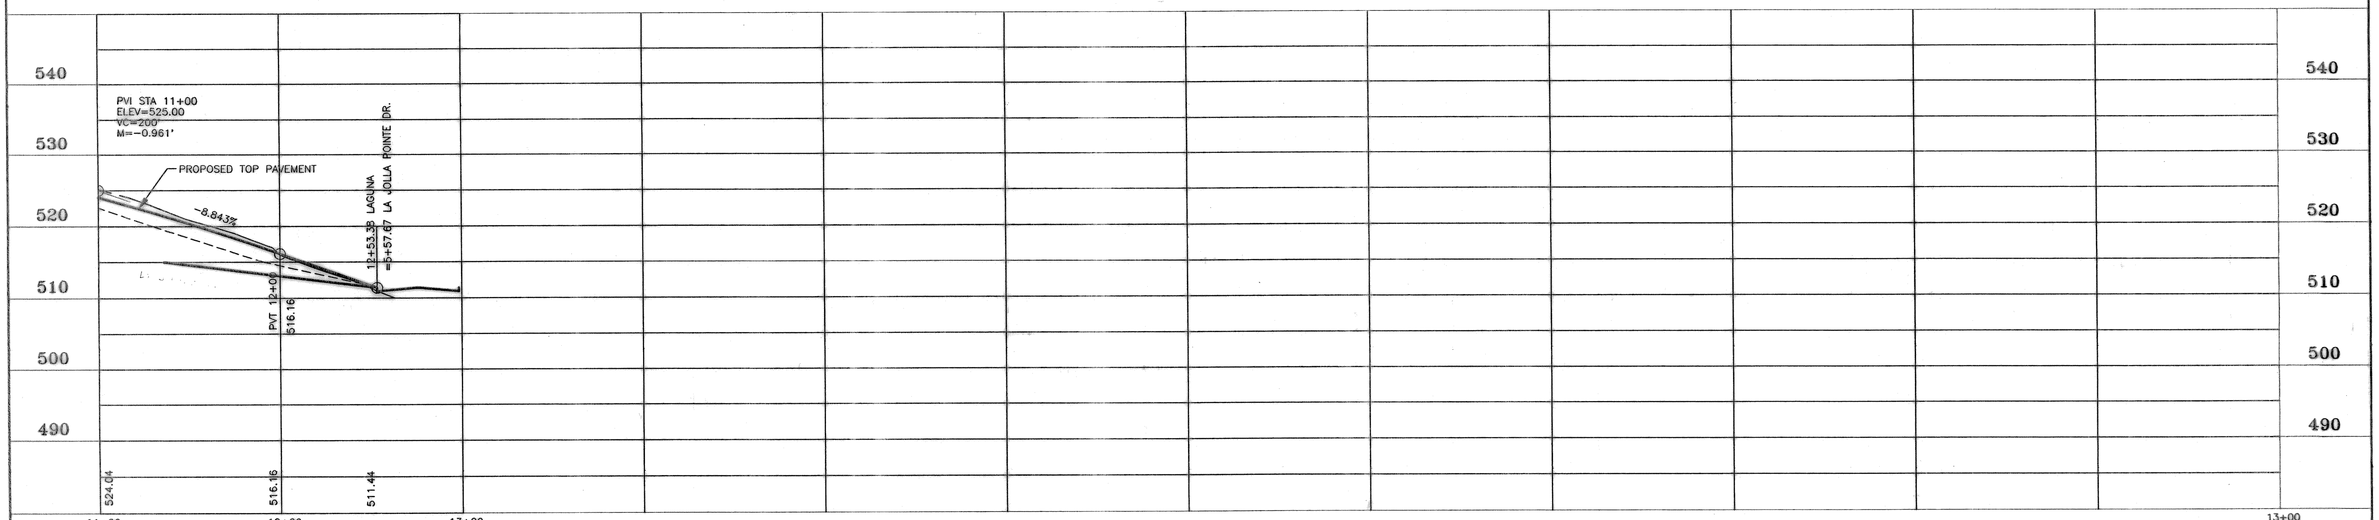

BENCH MARK(S) :

EXISTING SQUARE CUT ON TOP OF WEST CURB OF LAKESIDE DRIVE LOCATED APPROXIMATELY 120 FEET NORTH OF RAILROAD, AT THE NORTHWEST CORNER. ELEV=506.23

LEGEND :

- PROP. STM. SWR.
- EX. STM. SWR.
- PROP. SAN. SWR.
- EX. SAN. SWR.
- PROP. WATER
- EX. WATER
- FENCE
- RIGHT-OF-WAY
- LOT LINE
- DITCH FLOWLINE
- EX. GAS
- EX. BURIED TELEPHONE
- EX. BURIED ELECTRICAL
- PROP. FIRE HYDRANT
- PROP. GATE VALVE
- PROP. MANHOLE
- POWER POLE
- GUY WIRE
- PHONE BOX
- ROW-MARKER
- IRON PIN
- TRAVERSE POINT
- MAILBOX
- EXIST. FIRE HYDRANT
- EXIST. GATE VALVE
- EXIST. MANHOLE
- CLEANOUT
- WATER METER
- GAS METER
- ROAD SIGN
- BENCHMARK
- TREE

REVISIONS

REV. NO.	DESCRIPTION	DATE	DRWN. BY

STATE OF TEXAS
PANSAK SRIBHEN
40320
REGISTERED
PROFESSIONAL ENGINEER
2-21-01

PSA ENGINEERING
17819 DAVENPORT RD, SUITE 215
DALLAS, TEXAS 75252
(972) 248-9651 FAX (972) 248-9681

CITY OF ROCKWALL, TEXAS
LA JOLLA POINTE ADDITION
LAGUNA DRIVE
PAVING AND DRAINAGE IMPROVEMENTS

DESIGN	DRAWN	DATE	SCALE	PROJ. No.	SHEET No.
PSA	PSA	2-21-01	1"=40' H 1"=10' V	2001.LJP	P-4

C:\2001\2001.LJP\02-21-02\P-1.dwg Wed Feb 21 11:11:55 2001 MIRALI
HP DesignJet 1055C Hewlett-Packard HP-GL/2 driver, ADI 4.3 (v4.1) - Jul 22 1998