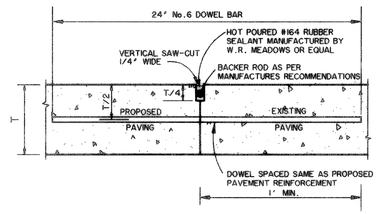

BUTT JOINT

N.T.S.

NOTES:

T = PAVEMENT THICKNESS

1. No 5 DOWEL BAR MAY BE USED IN PAVEMENT WITH 6" THICKNESS OR LESS.
2. DOWEL BARS SHALL BE DRILLED INTO PAVEMENT HORIZONTALLY BY USE OF A MECHANICAL RIG. DRILLING BY HAND IS NOT ACCEPTABLE, PUSHING DOWEL BARS INTO GREEN CONCRETE IS NOT ACCEPTABLE. SECURE DOWEL BARS IN EXISTING PAVING WITH EPOXY GROUT.

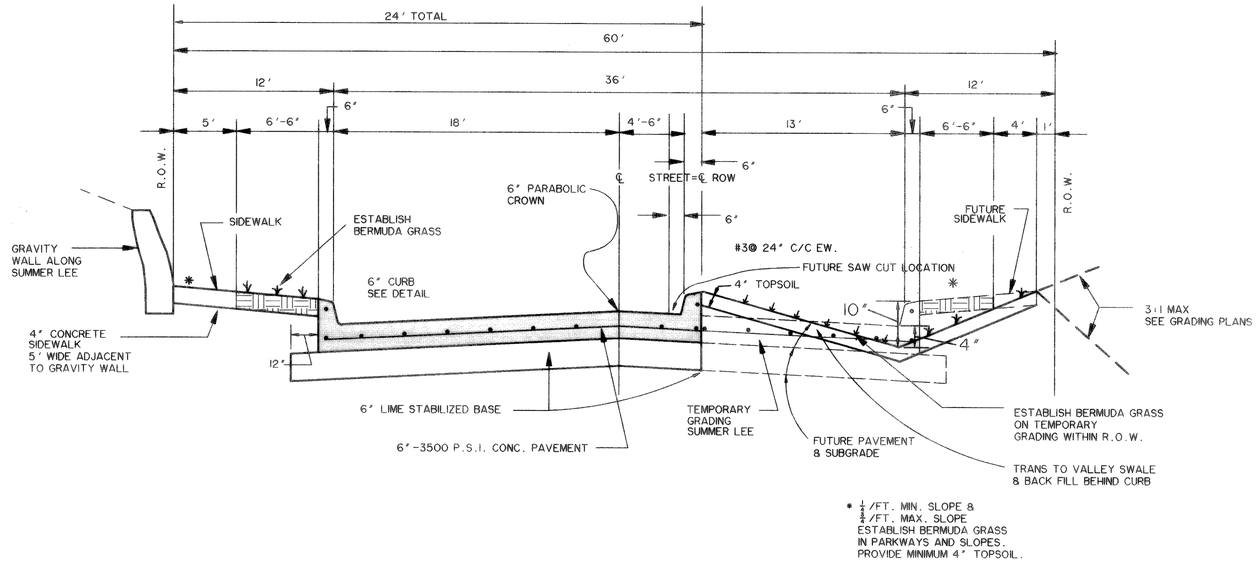

MINOR COLLECTOR

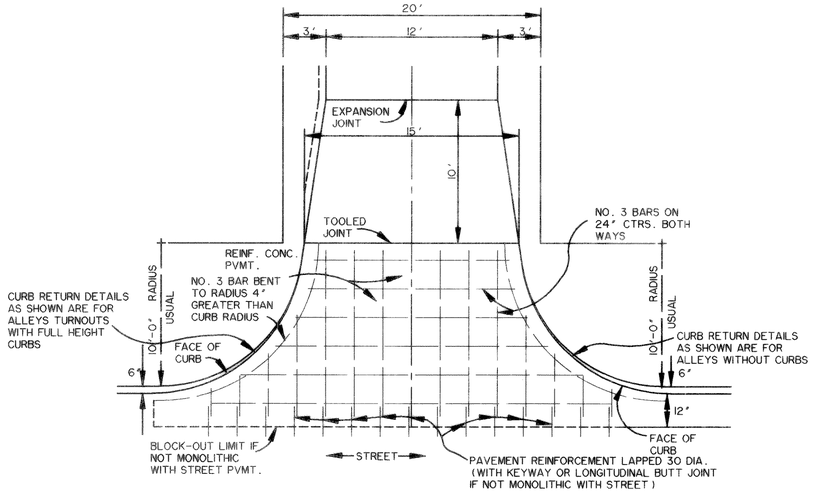

ALLEY RETURN DETAILS

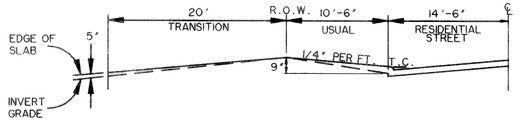

TYPE I ALLEY ENTRANCE

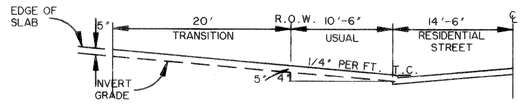

TYPE II ALLEY ENTRANCE

RECORD PLANS
12-18-95

PREPARED BY:
WIER & ASSOCIATES, INC.
ENGINEERS SURVEYORS LAND PLANNERS
4300 BELTWAY PLACE SUITE 130 ARLINGTON, TEXAS 76018 METRO (817)467-7700
3908 SOUTH FREEWAY FORT WORTH, TEXAS 76110 (817)926-0212

CITY OF ROCKWALL
ROCKWALL COUNTY, TEXAS

TYPICAL SECTION

STATE OF TEXAS
ULYS LANE III
40864
REGISTERED PROFESSIONAL ENGINEER
3.18.96

COPYRIGHT © WIER & ASSOCIATES, INC.

LAST SHEET EDIT
DATE 03-14-95
FILE PVMTSEC
WA# 93049

SHEET NO.
6