LINE "A"

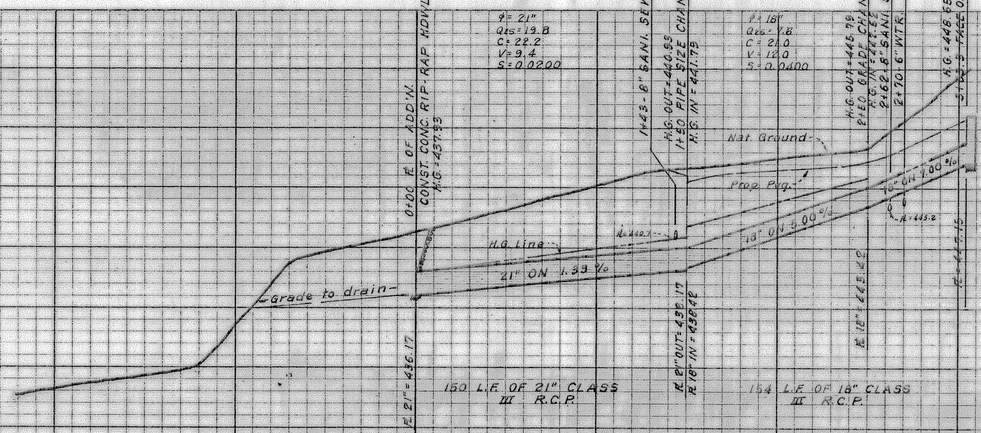

LINE "C"

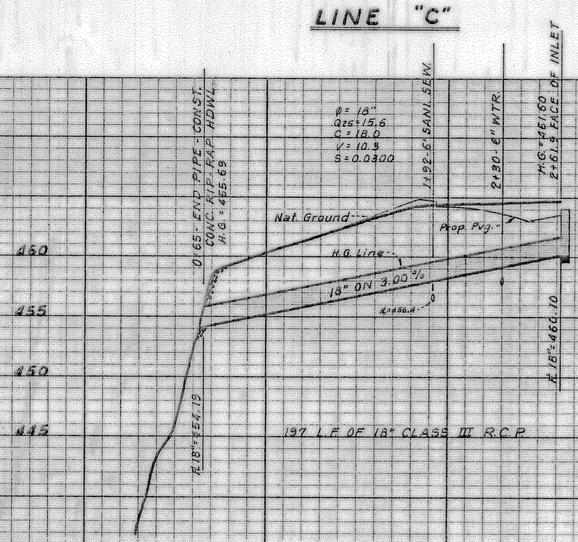

LINE "B"

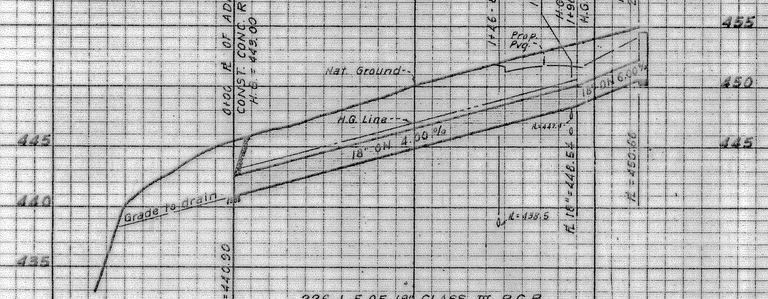

NOTE: USE CONC. CUSHION WHERE ROCK IS ENCOUNTERED.

STORM SEWER PROFILES

LAKE RIDGE PARK

ROCKWALL, TEXAS

C. L. Moon, Inc. ~ Consulting Engineers

11554 East N. W. Hwy. ~ Dallas, Texas

DESIGN	DRAWN	DATE	SCALE	NOTES	FILE	NO.
C.L. Moon Engrs.	w.p.	1972	H: 1"=40' V: 1"=6'	j.c.		9

21