


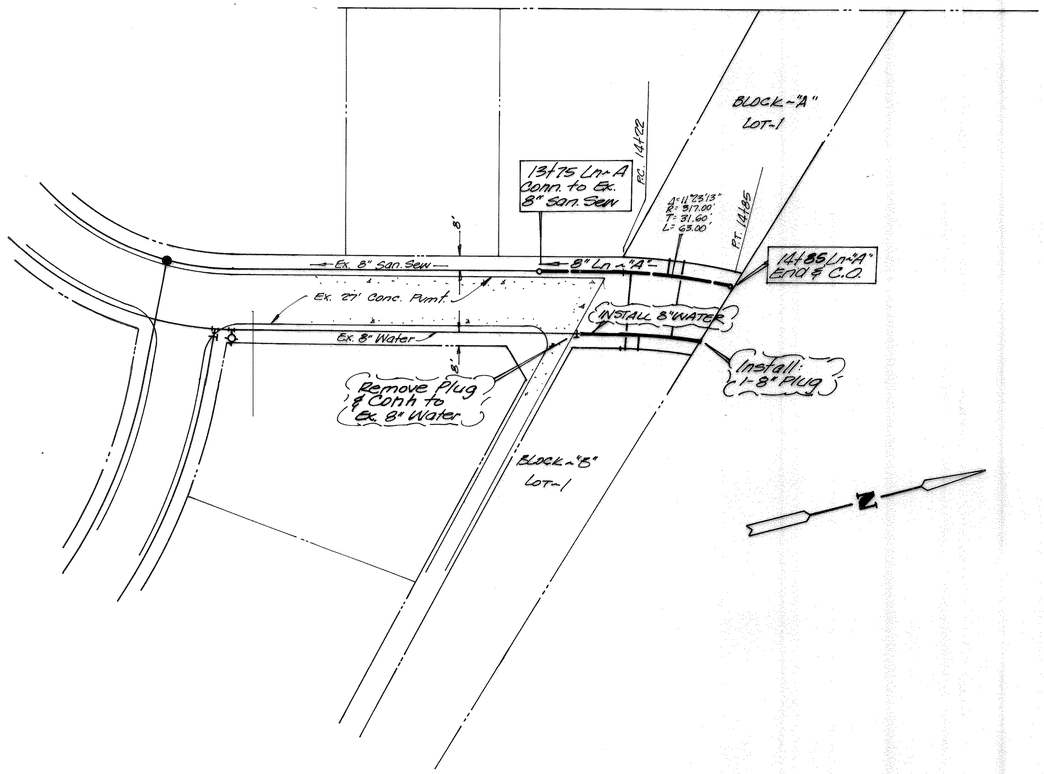





AS BUILT

3 of 3

| HAROLD L. EVANS CONSULTING ENGINEER | | |
|---|---|---|
| 2331 GUS THOMASSON RD. SUITE 102 | | |
| DALLAS, TEXAS 75228 | | |
| PHONE (214) 328-8133 | | |
| SCALE | DATE | JOB NO. |
| 1"=40'H/1"=6'V | 10-9-84 | 84227 |

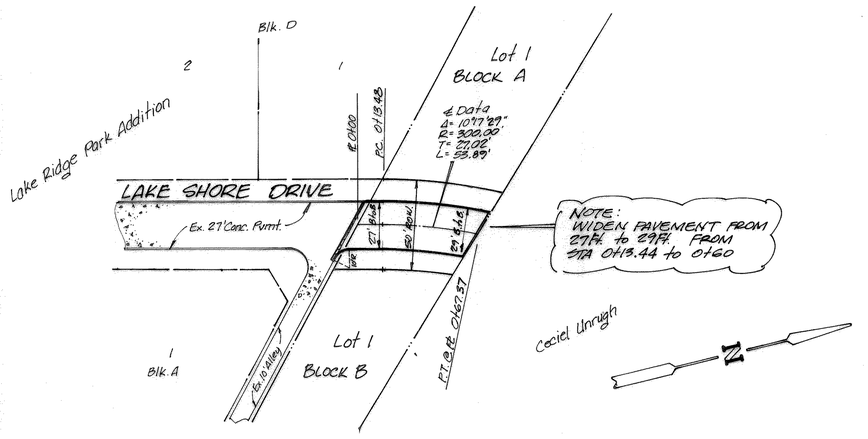Rev. 11-16-84

# PAVING & UTILITY PLAN

LAKE SHORE DRIVE

LAKE RIDGE PARK - BOTO ADDITION

CITY OF ROCKWALL, ROCKWALL COUNTY, TEXAS