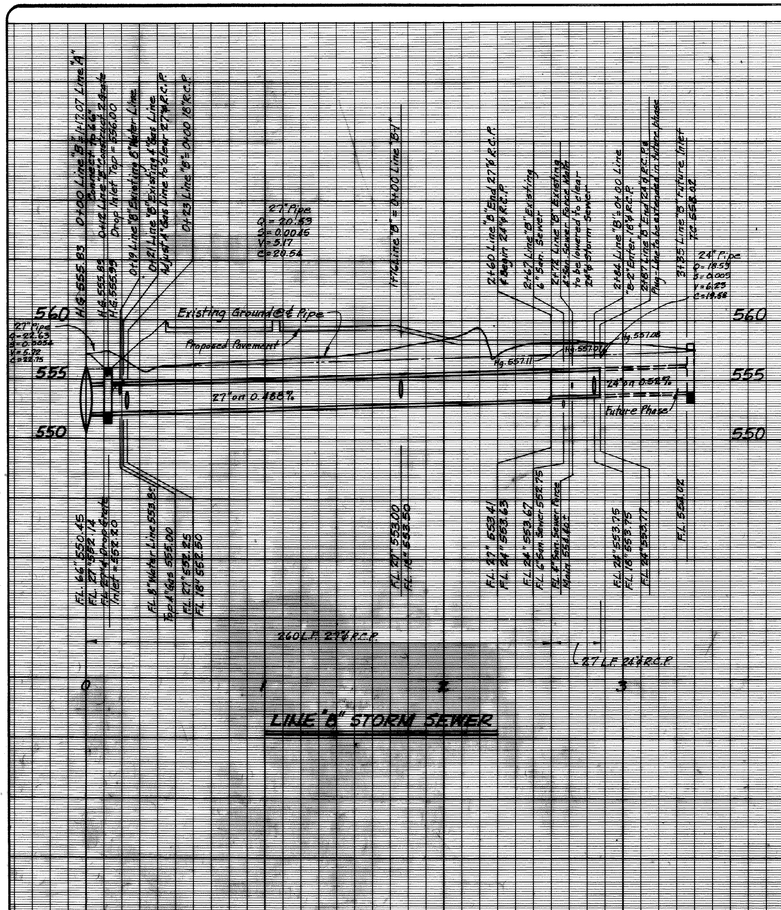

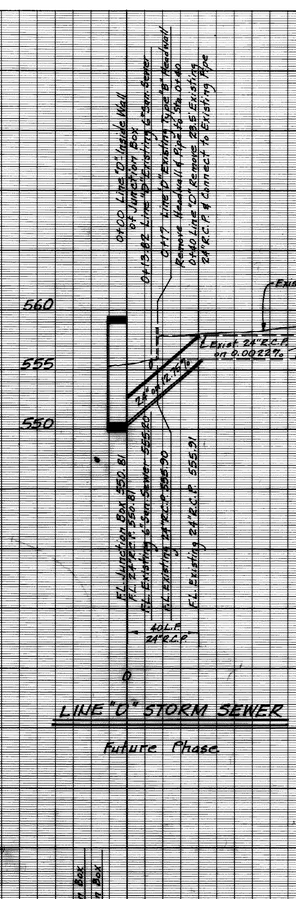

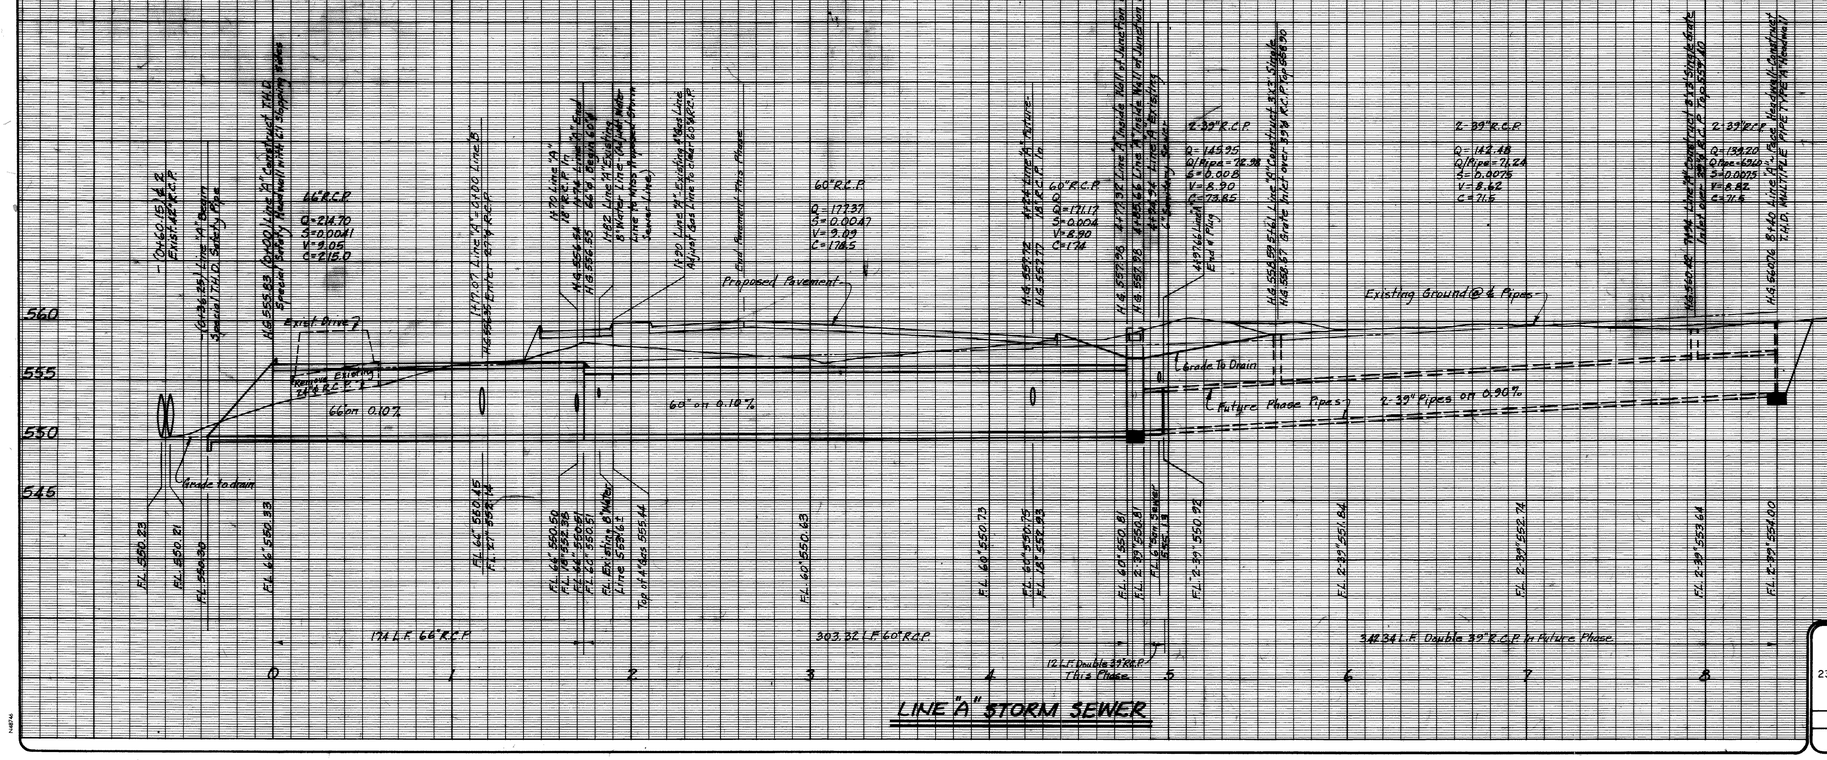

AS-BUILT

7/7

HAROLD L. EVANS CONSULTING ENGINEER		
2331 GUS THOMASSON RD. SUITE 102 DALLAS, TEXAS 75228 PHONE (214) 328-8133		
SCALE	DATE	JOB NO.
1"=40'H 1"=6'V.	4-13-90	85107

Rev. 4-23-90
Rev. 5-31-90
Rev. 6-13-90
Rev. 6-29-90

DRAINAGE PROFILES

GRADY ADDITION

CITY OF ROCKWALL, ROCKWALL COUNTY, TEXAS