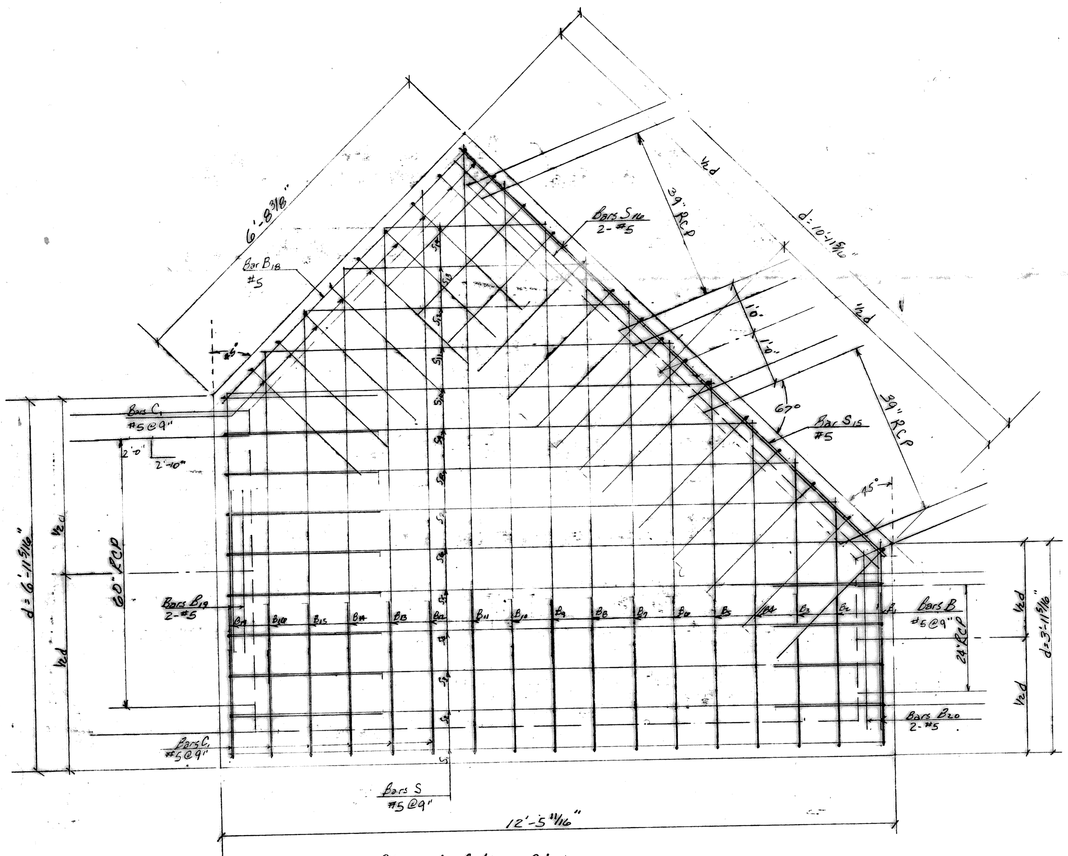


Plan of Bottom Slab

3/4"=1'

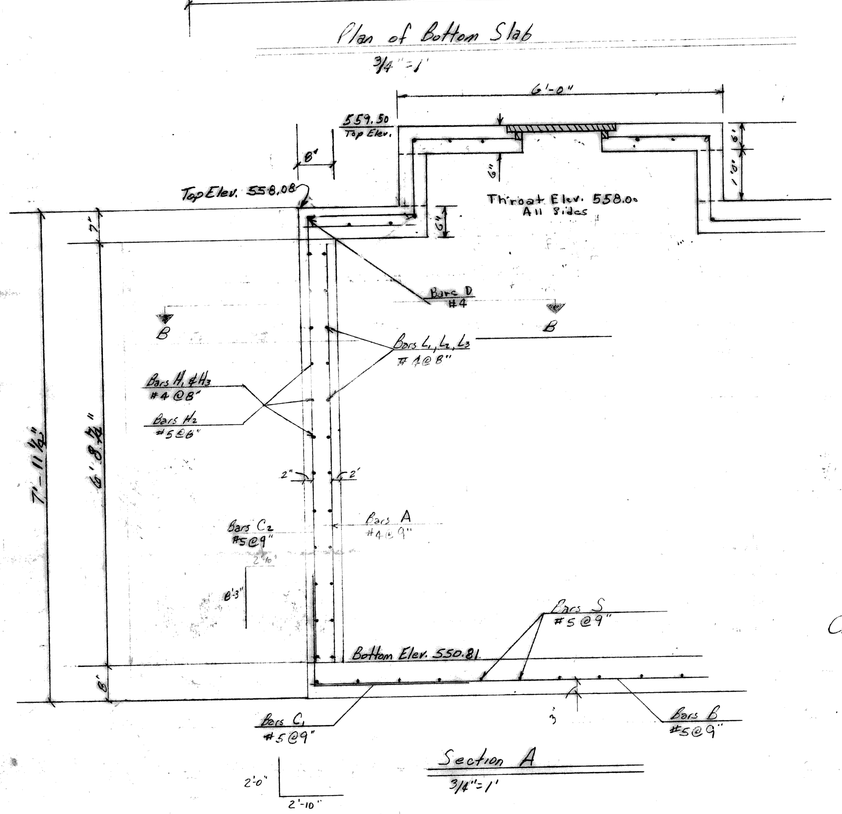


Section A

3/4"=1'

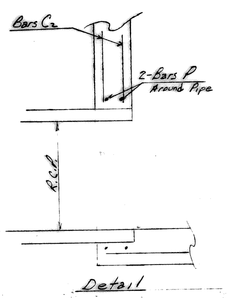


STORM SEWER
JUNCTION BOX
LAKESIDE CHEVROLET
CITY OF ROCKWALL, ROCKWALL COUNTY, TEXAS
SCALE: AS NOTED. DATE: 3-1-89

Plan of Top Slab

3/4"=1'

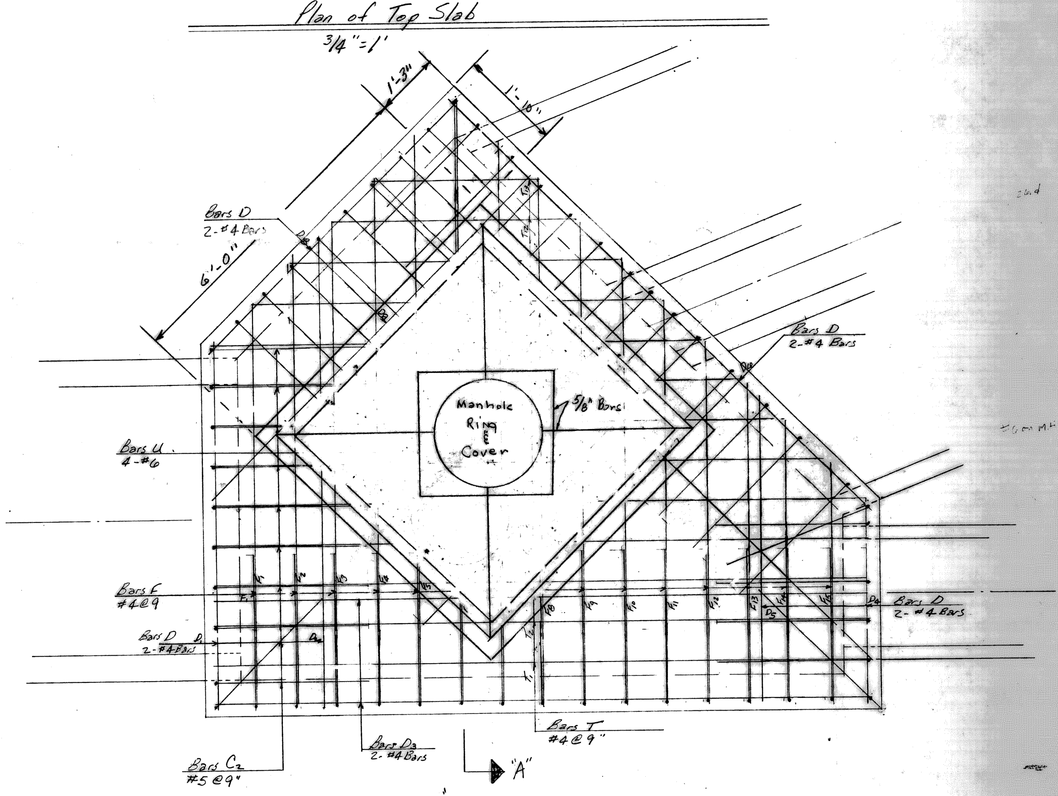


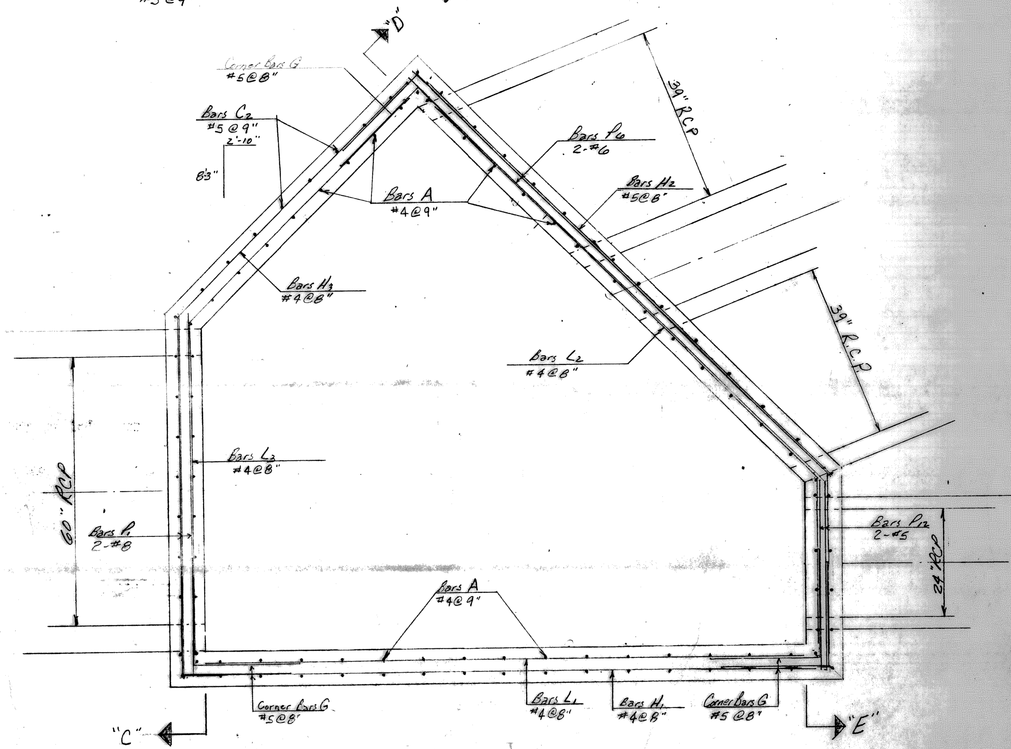


Section B-B

Horizontal Section Thru Walls

3/4"=1'

AS-BUILT

REGISTERED PROFESSIONAL ENGINEER HAROLD L. HAMM 23155

Revised 7-12-90
Added Wye Inlet

85107