NOTE: THIS PLAN HAS BEEN REVISED FROM ITS ORIGINAL FORM ON THE CONSTRUCTION DOCUMENTS ISSUED JULY 22, 2004. DIMENSIONS, CONTOURS, AND SPOT ELEVATIONS ALONG LINE "C" AND THE DRAINAGE SWALE CORRESPONDING TO LINE "C" HAVE BEEN MODIFIED.

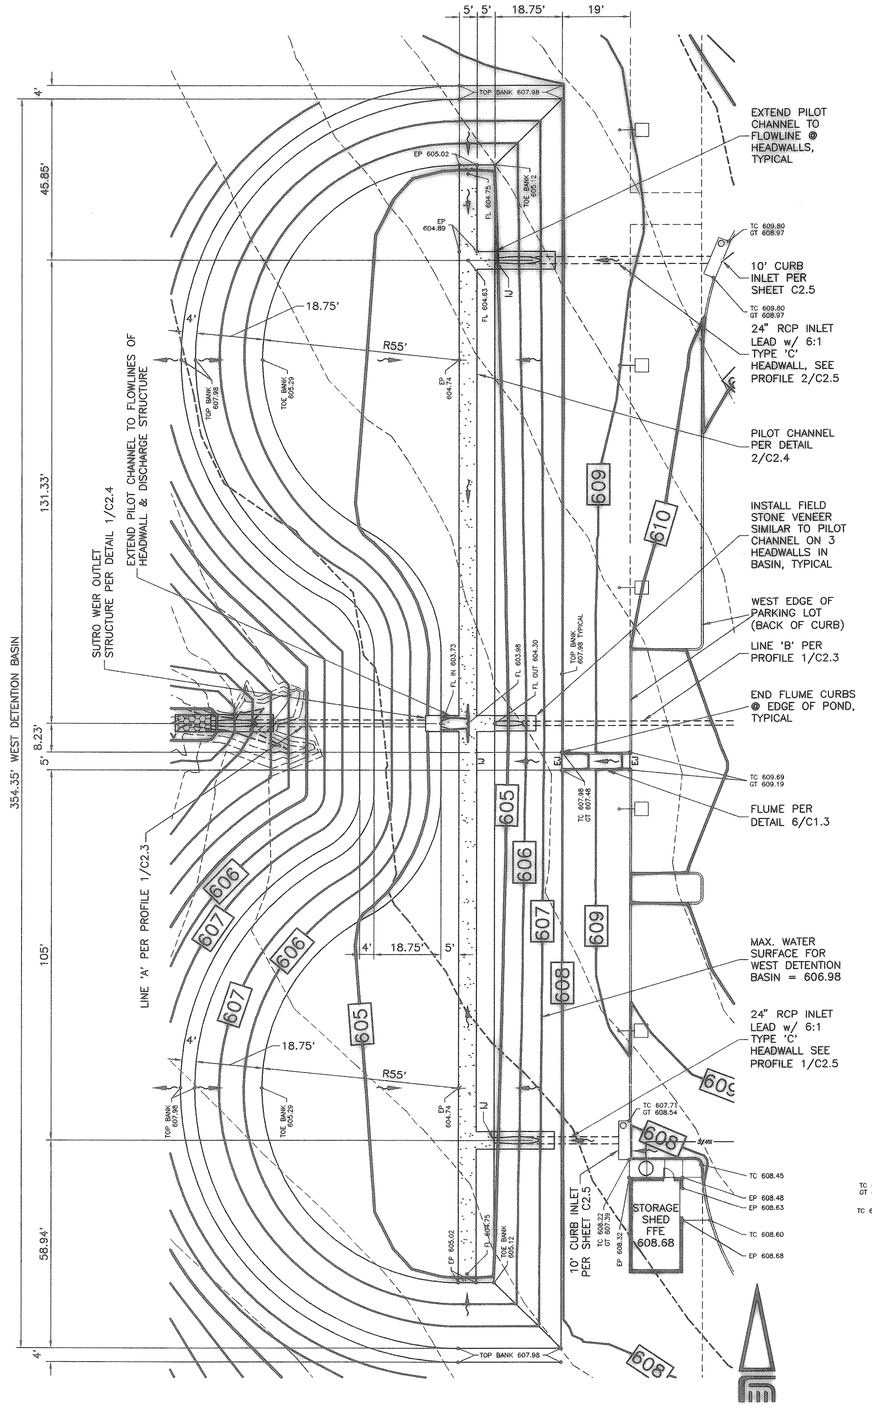

1 PLAN DETAIL - GRADING @ WEST DETENTION BASIN
1"=20'

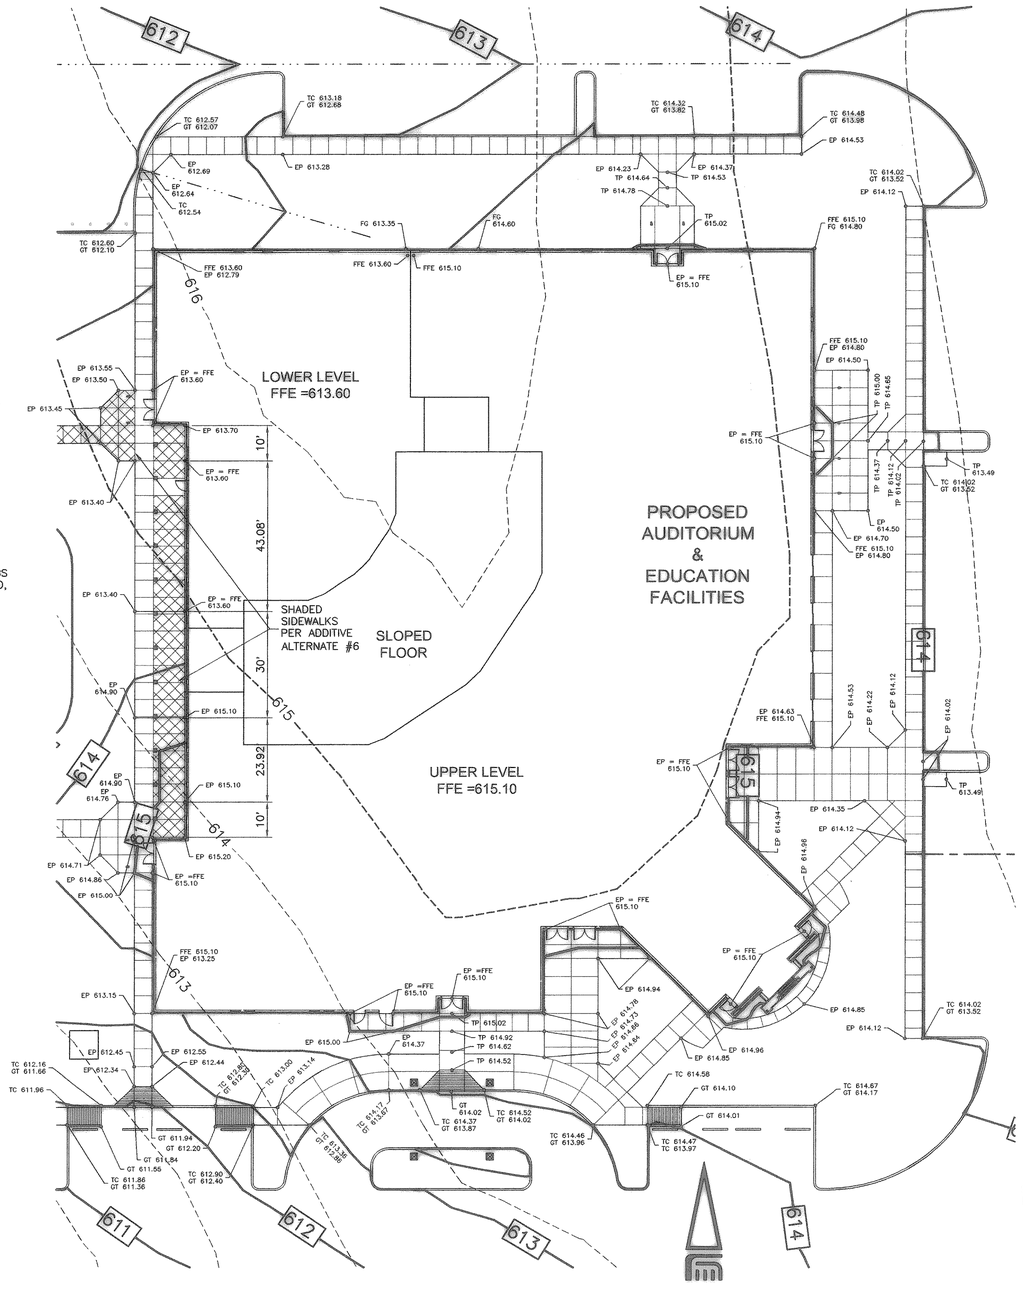

2 PLAN DETAIL - GRADING @ BUILDING PERIMETER
1"=20'

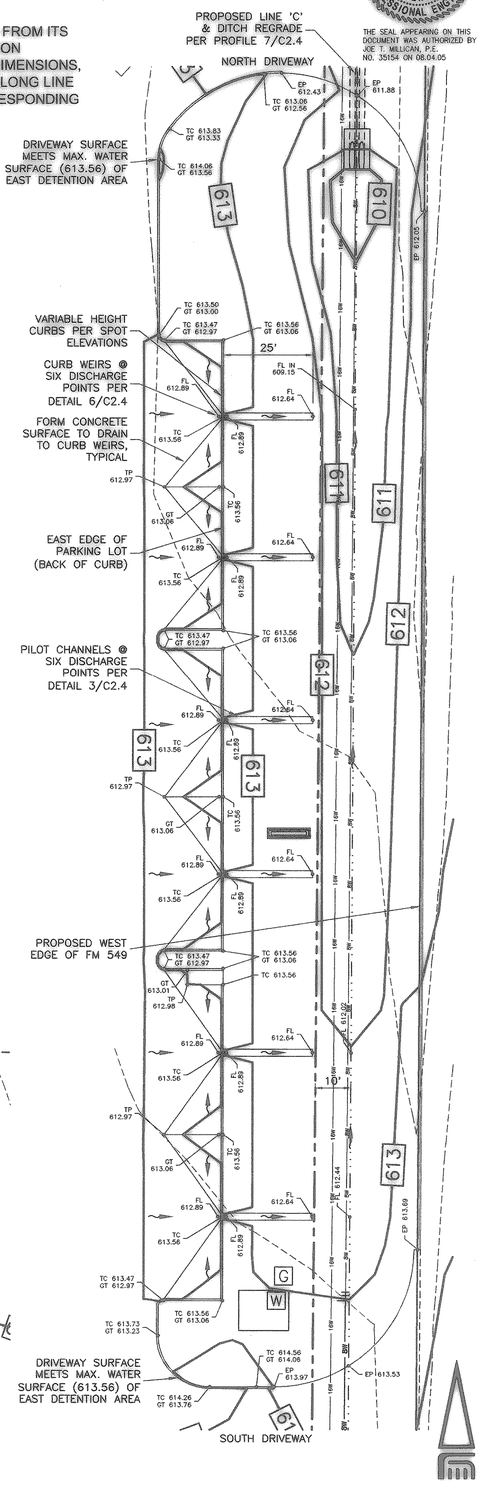

3 PLAN DETAIL - GRADING @ EAST DETENTION AREA
1"=20'

Copyright 2004 By Hallum Architects, Inc.

THE SEAL APPEARING ON THIS DOCUMENT WAS AUTHORIZED BY JOE T. MILLICAN, P.E. NO. 35154 ON 08.04.05

Revisions:
⚠ REGRADE LINE "C" ISSUED 04/26/2005.

HALLUM ARCHITECTS, INC.
2501 PARKVIEW DRIVE SUITE 430
FORT WORTH, TEXAS 76102
PHONE: 817.332.2422 FAX: 817.338.1949
email: info@hallumarch.com

Rockwall Lakeside Church of Christ
New Auditorium and Education Facilities
485 North FM 549, Rockwall, Texas 75087

GRADING PLAN DETAILS

RECORD DRAWING
(ALL REVISIONS ARE BASED UPON NOTES AND COMMENTS SUBMITTED BY FRANK DALE CONSTRUCTION CO., LTD)

Date: 8-4-2005
Scale: 1"=20'
Drawn: JDG
Job: 2002-10

Sheet Number:
C2.2