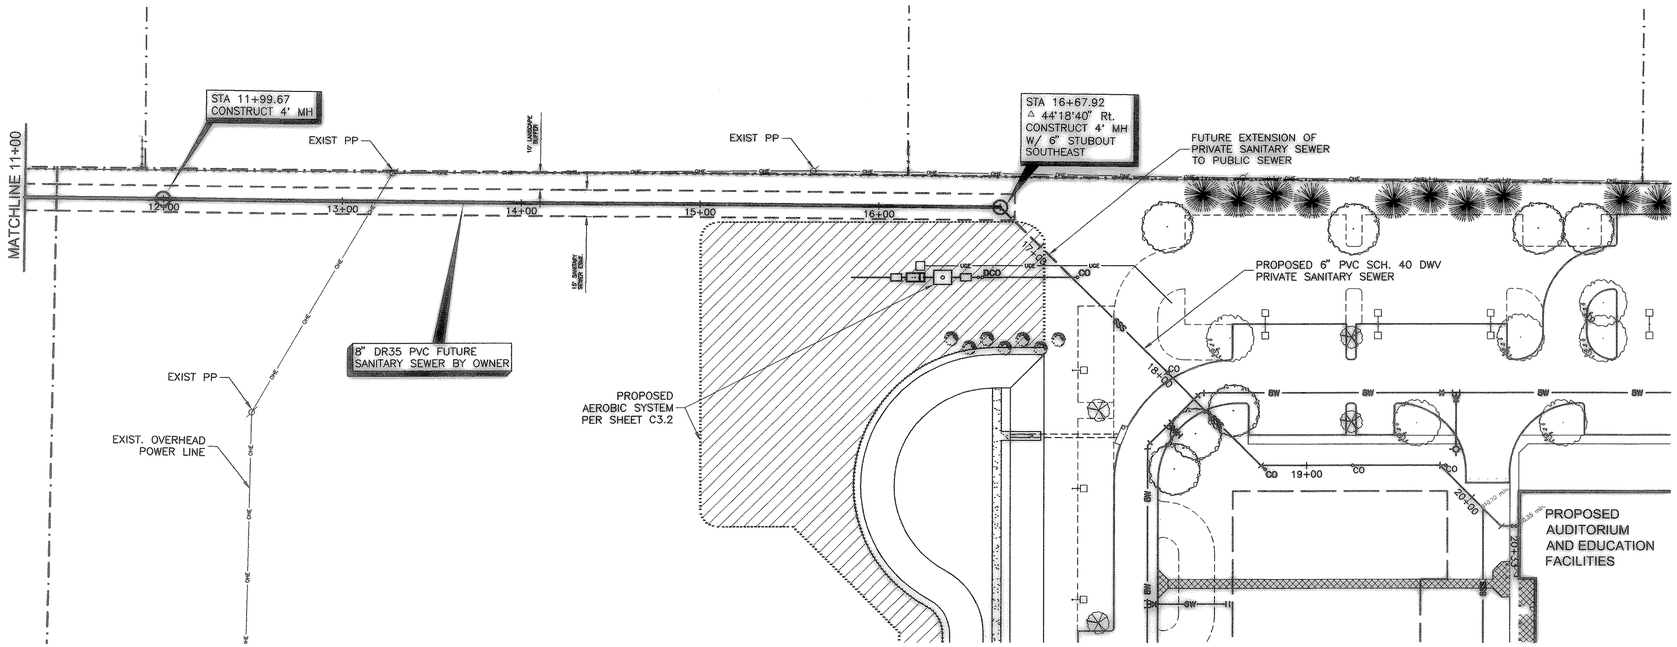

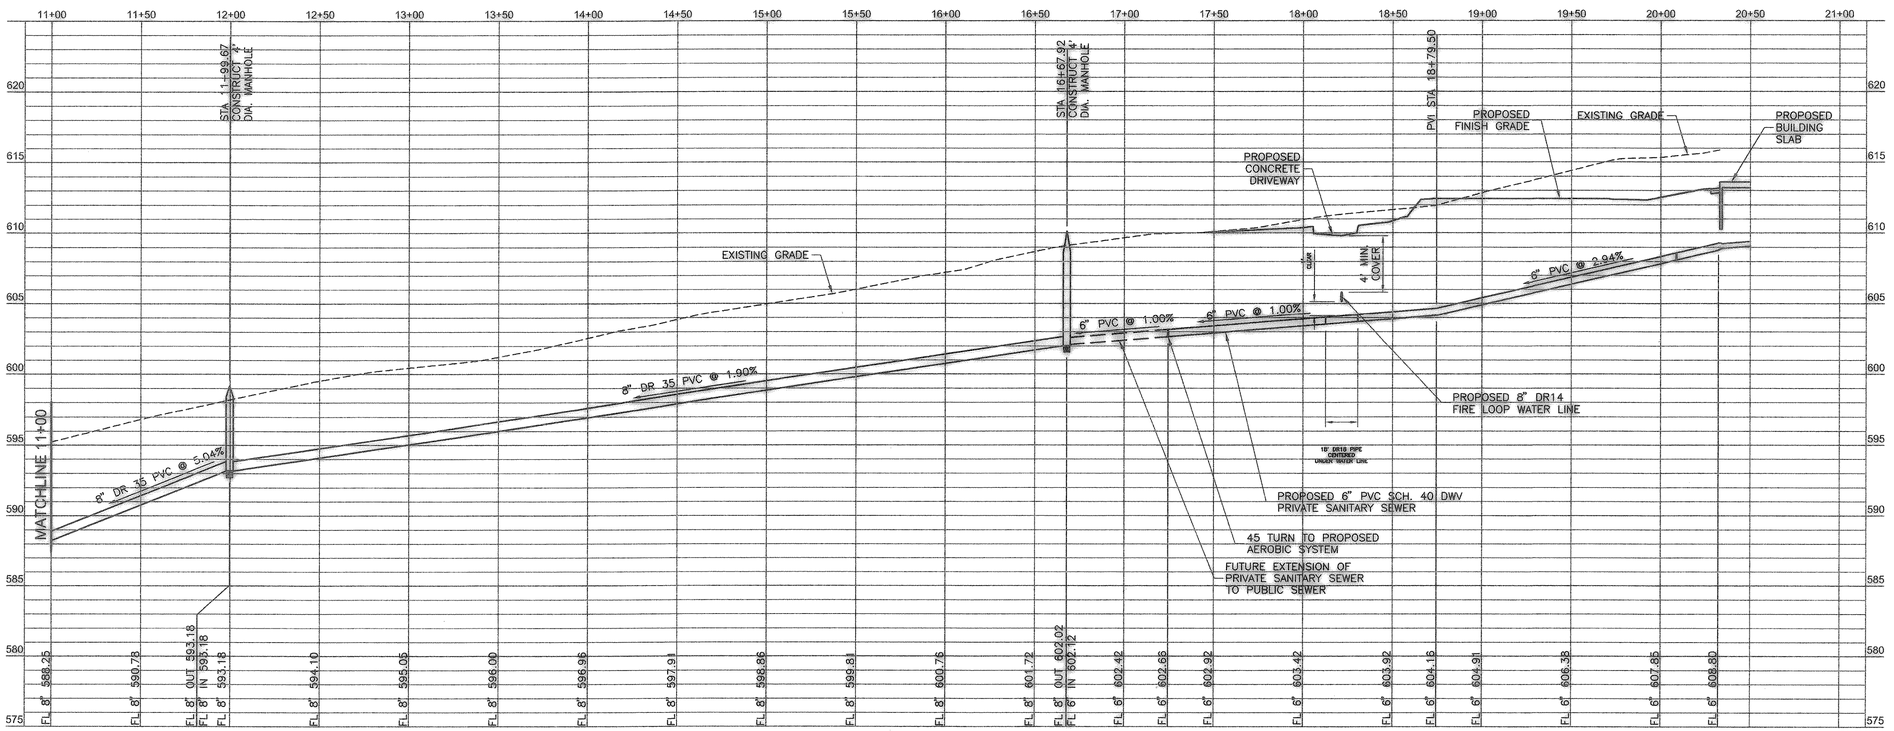

BENCHMARKS BY BIRKHOFF, HENDRICKS & CONWAY:

T.B.M. 346
SANITARY SEWER MANHOLE RIM AT
SAN. SEW. LINE "SS1" STA. 0+00
N 7024055.4568, E 2601761.3699
ELEV. 559.52

T.B.M. 101
60D NAIL ON NORTH SIDE OF AIRPORT ROAD,
SAN. SEW. LINE "SS1" STA. 39+24.9, 38.30' LT.
N 7025851.5998, E 2604704.5991
ELEV. 589.49

T.B.M. 100
S.W.B. MANHOLE RIM NORTH SIDE OF AIRPORT ROAD,
SAN. SEW. LINE "SS1" STA. 64+33.53, 47.06' LT.
N 7025890.6370, E 2607135.2857
ELEV. 589.49

Copyright 2004 By Hallum Architects, Inc.

STATE OF TEXAS
JOE T. MILLICAN
35154
PROFESSIONAL ENGINEER

THE SEAL APPEARING ON THIS DOCUMENT WAS AUTHORIZED BY JOE T. MILLICAN, P.E. NO. 35154 ON 08.04.05

Revisions:

HALLUM ARCHITECTS, INC.
2501 PARKVIEW DRIVE SUITE 430
FORT WORTH, TEXAS 76102
PHONE: 817.332.2422 FAX: 817.338.1949
email: info@hallumarch.com

Rockwall Lakeside Church of Christ
New Auditorium and Education Facilities
485 North FM 549, Rockwall, Texas 75087

FUTURE SANITARY SEWER PLAN & PROFILES

RECORD DRAWING
(ALL REVISIONS ARE BASED UPON NOTES AND COMMENTS SUBMITTED BY FRANK DALE CONSTRUCTION CO., LTD)

Date: 8-4-2005
Scale: H:1"=40' V:1"=5'
Drawn: AC
Job: 2002-10

Sheet Number:
C3.4