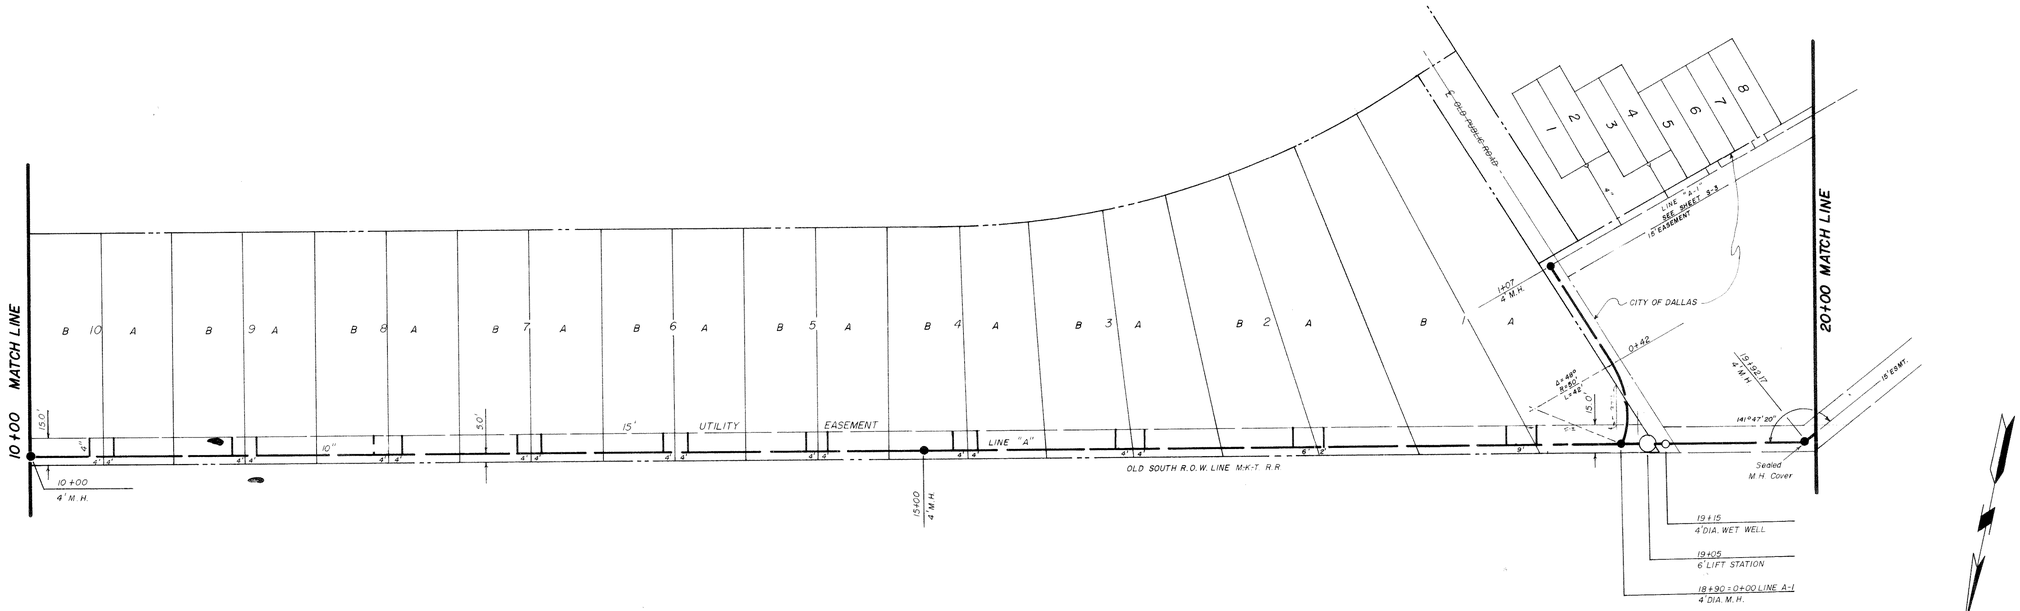

SCALE:
1" = 40' HORIZONTAL
1" = 6' VERTICAL

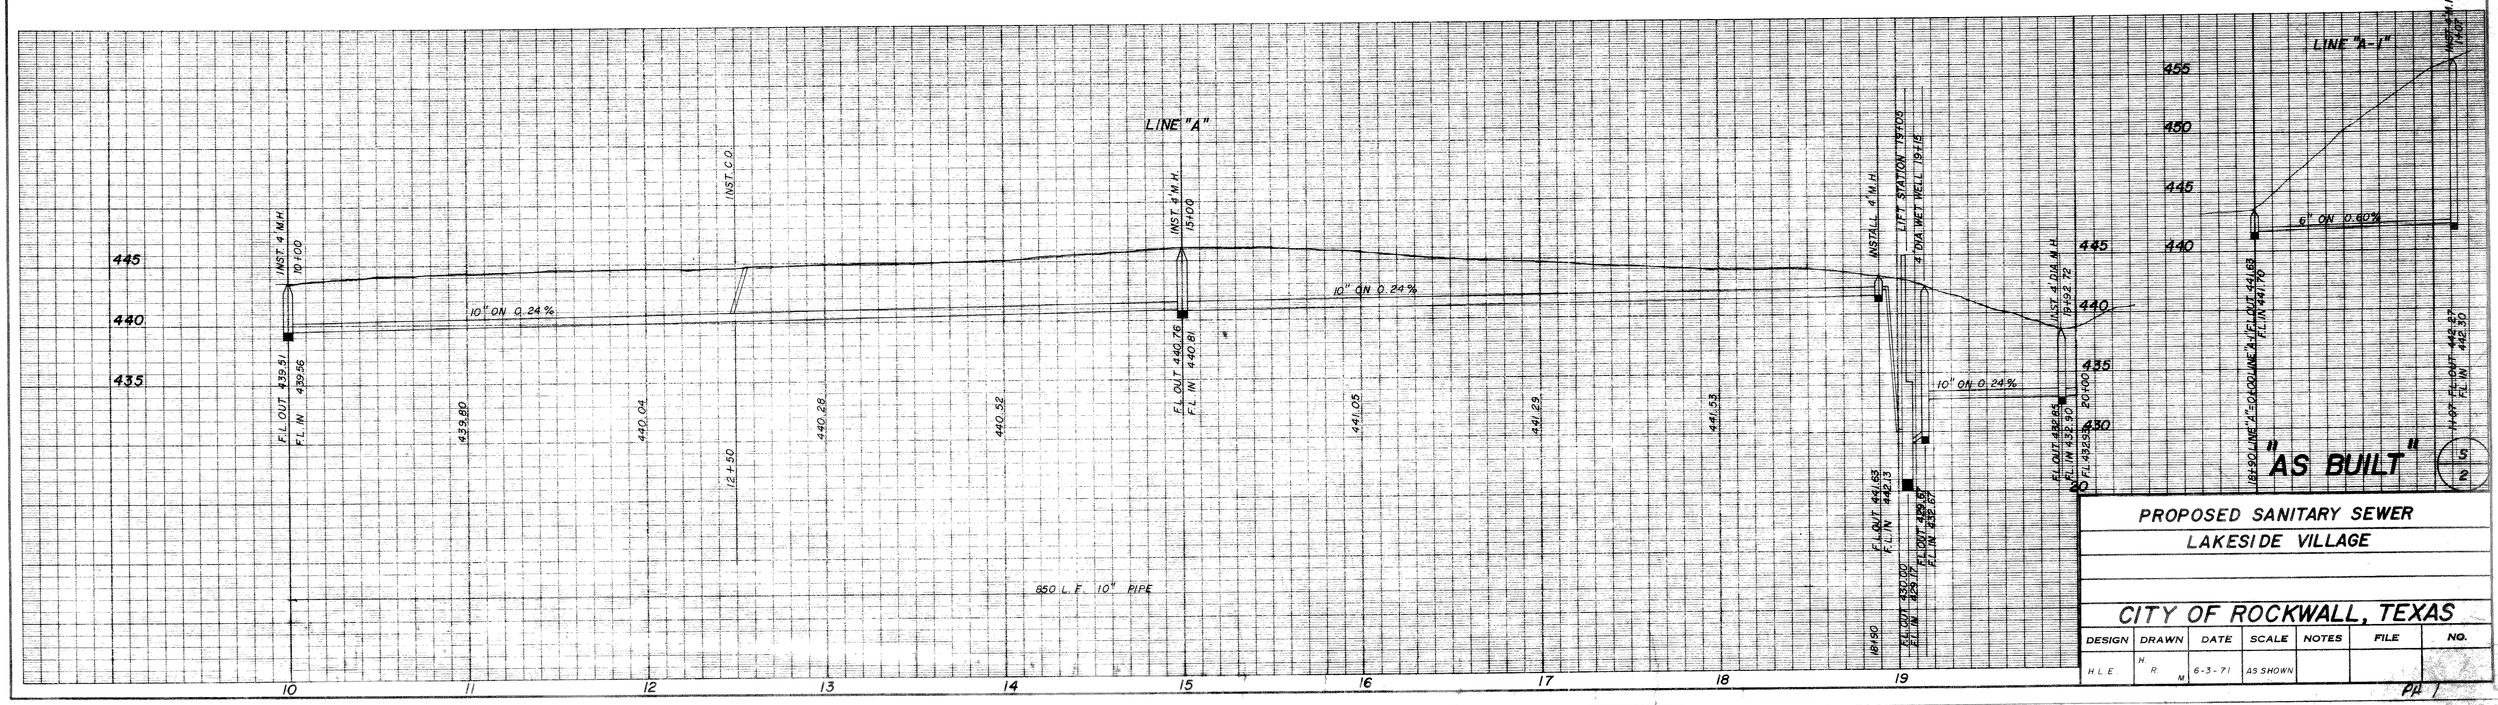

"AS BUILT"

PROPOSED SANITARY SEWER
LAKESIDE VILLAGE

CITY OF ROCKWALL, TEXAS

DESIGN	DRAWN	DATE	SCALE	NOTES	FILE	NO.
H.L.E.	H. R. M.	6-3-71	AS SHOWN			

5 of 20

PP 1