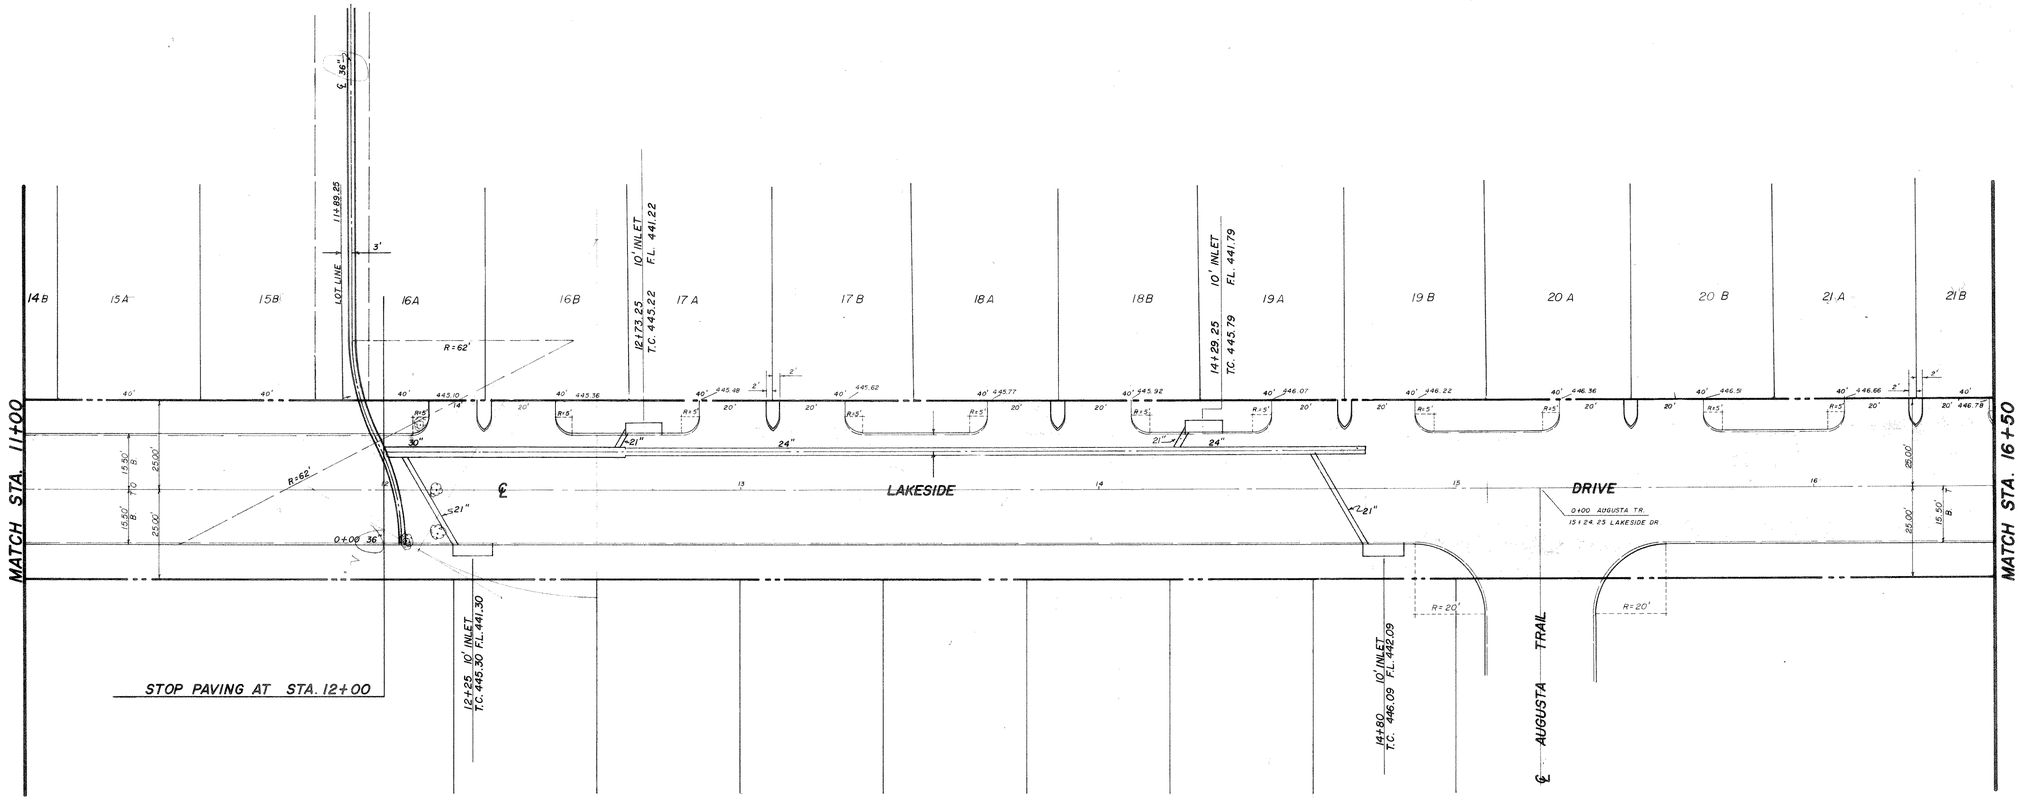

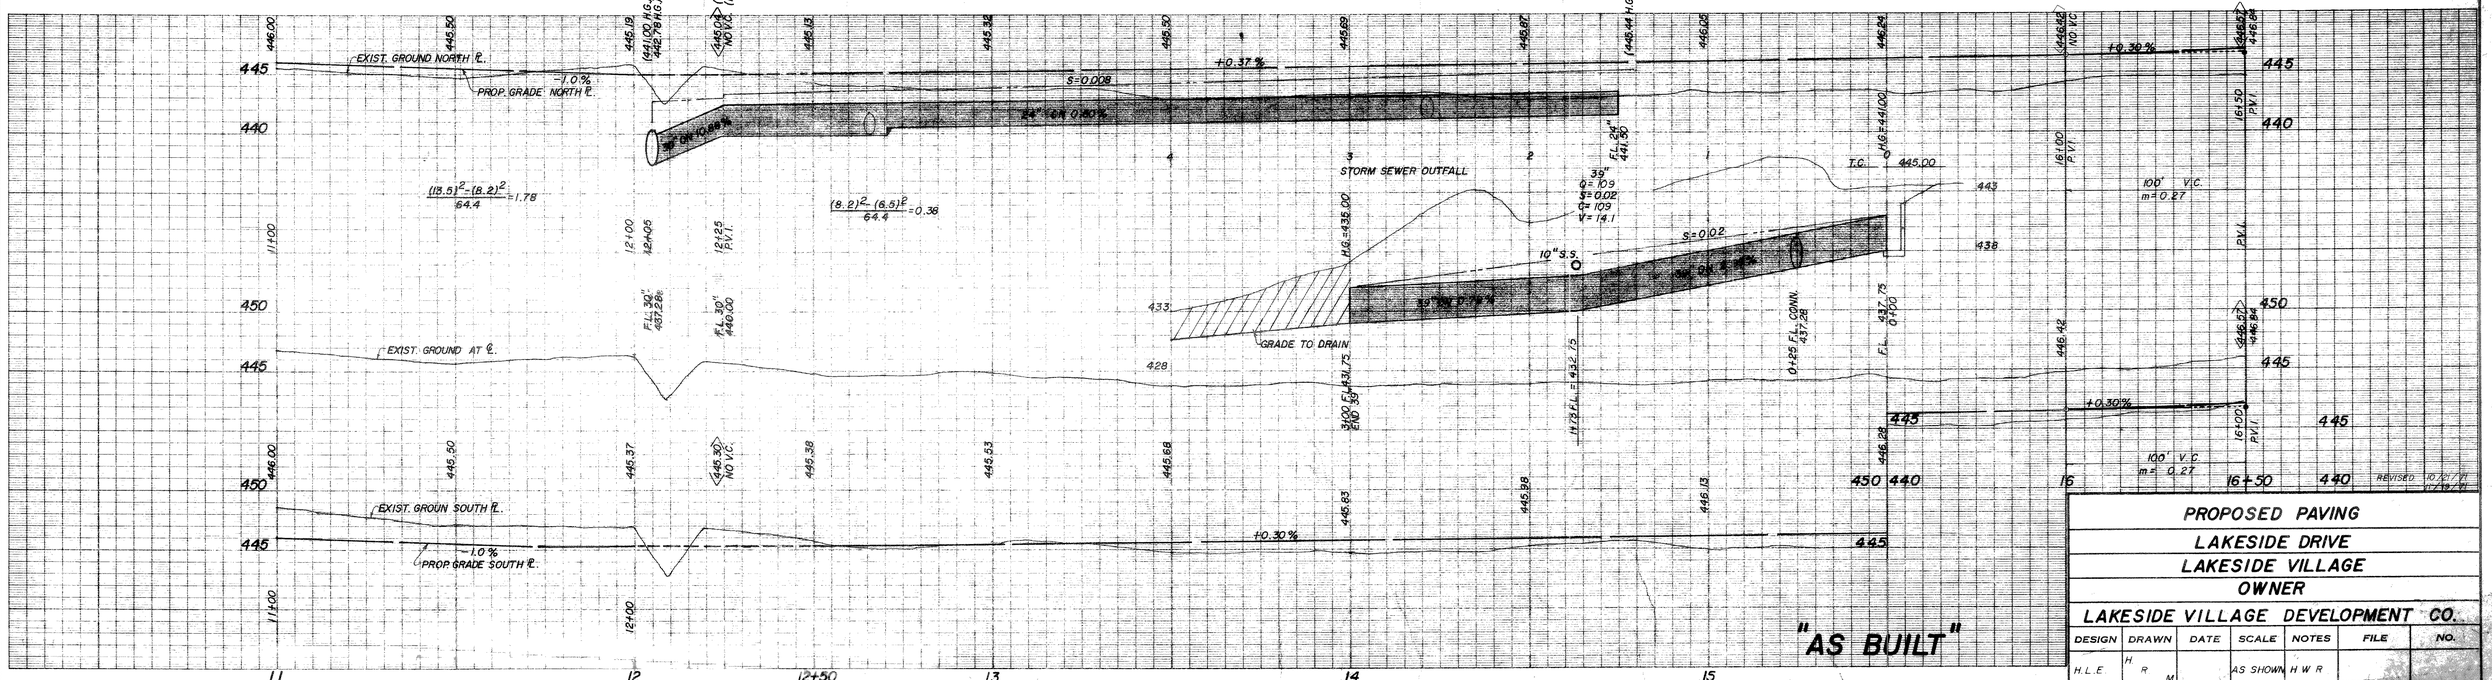

"AS BUILT"

PROPOSED PAVING						
LAKESIDE DRIVE						
LAKESIDE VILLAGE						
OWNER						
LAKESIDE VILLAGE DEVELOPMENT CO.						
DESIGN	DRAWN	DATE	SCALE	NOTES	FILE	NO.
H.L.E.	H. R. M.		AS SHOWN	H W R		

PP 1