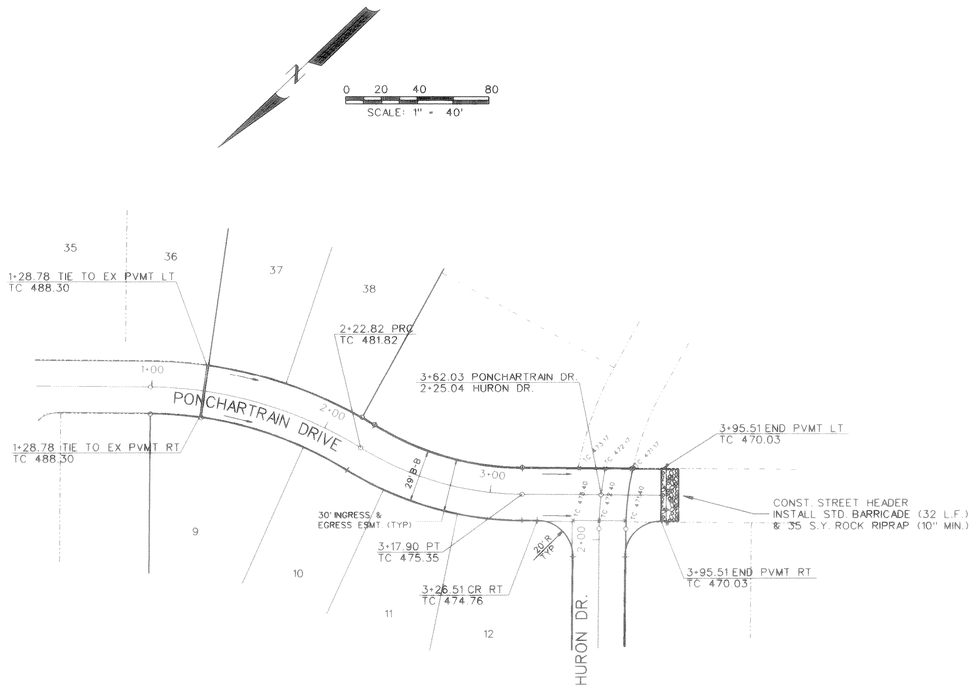

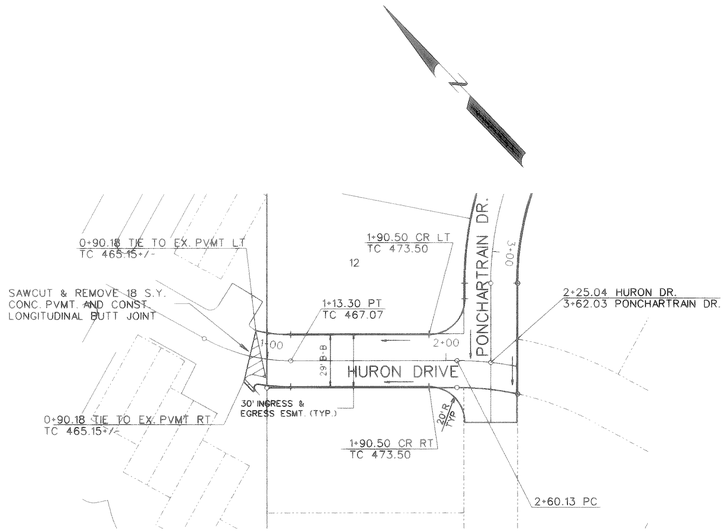

BENCHMARKS:

"□" found on the top of curb of the northwest corner of railroad brige @ Lakeside Drive.

ELEVATION = 506.23

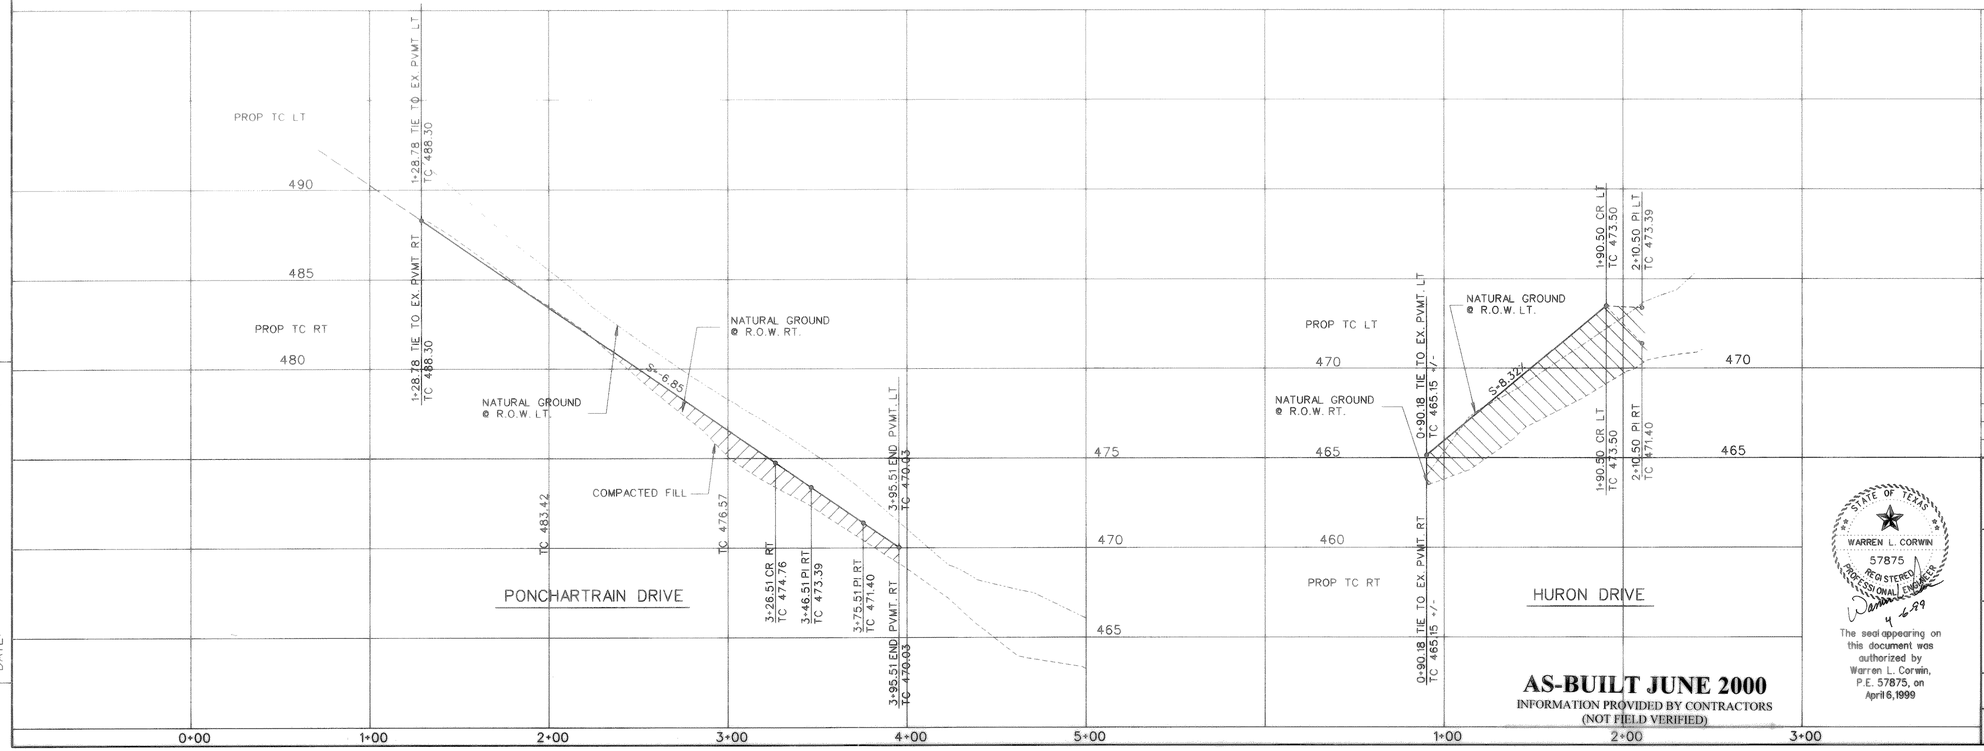

AS-BUILT JUNE 2000
INFORMATION PROVIDED BY CONTRACTORS
(NOT FIELD VERIFIED)

STATE OF TEXAS
WARREN L. CORWIN
57875
REGISTERED
PROFESSIONAL ENGINEER
4-6-99

The seal appearing on this document was authorized by Warren L. Corwin, P.E. 57875, on April 6, 1999

NO.	REVISIONS	BY	DATE
1	PER CITY COMMENTS	RDS	4-6-99

CORWIN ENGINEERING, INC.
8131 LBJ FREEWAY, SUITE 333
DALLAS, TEXAS 75251 (972) 480-0305

DEVELOPMENT PLANS FOR
LAKESIDE VILLAGE
PHASE V-B
ROCKWALL, TEXAS

PONTCHARTRAIN DRIVE
HURON DRIVE

DRAWN BY	DESIGNED BY	CHECKED BY	SHEET NO.
RDS	CEI	CEI	
JOB NUMBER	DATE	SCALE: 1"=4' V	
9853	OCTOBER 1998	1"=40' H	4 OF 10

PF:
FILE:
REF. FILE:
VIEW:
DATE: