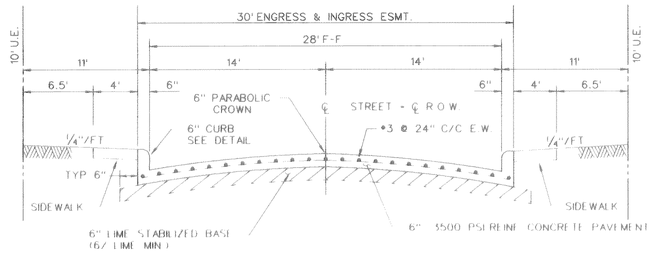

LOCAL RESIDENTIAL

N.T.S.

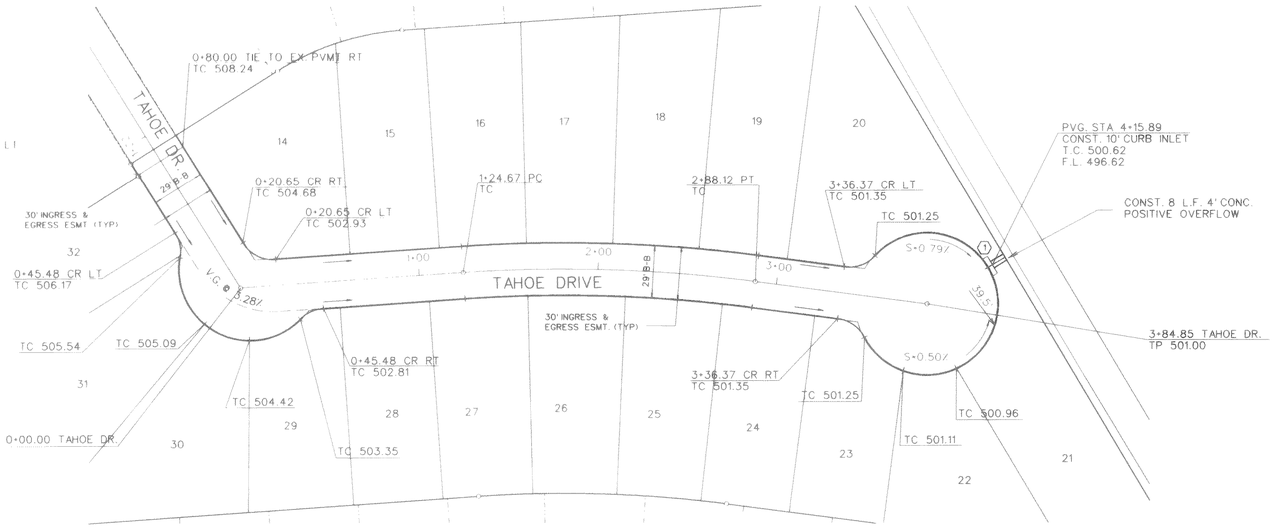

BENCHMARKS:

"□" found on the top of curb of the northwest corner of railroad brige @ Lakeside Drive.

ELEVATION = 506.23

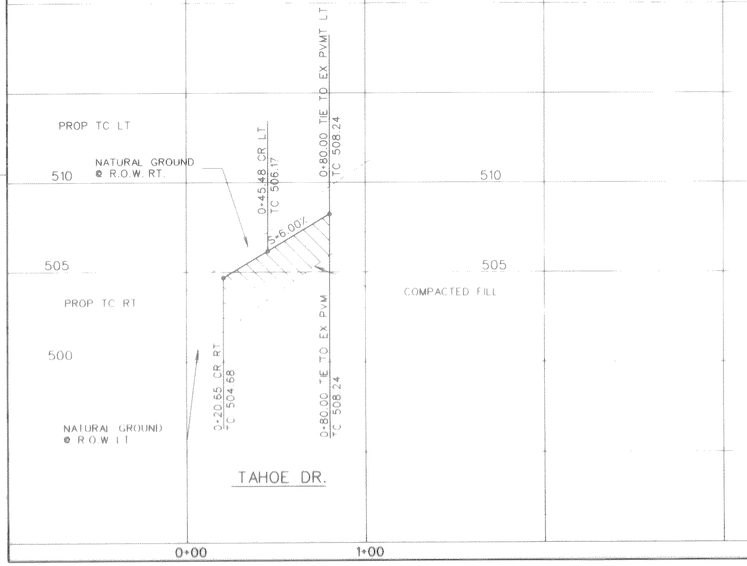

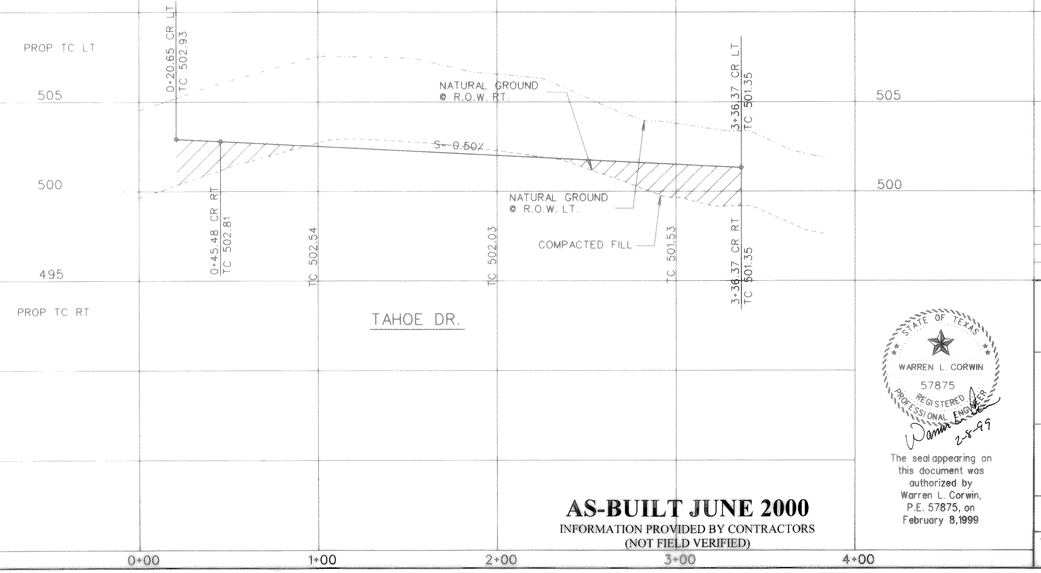

AS-BUILT JUNE 2000

INFORMATION PROVIDED BY CONTRACTORS (NOT FIELD VERIFIED)

STATE OF TEXAS
WARREN L. CORWIN
57875
REGISTERED
PROFESSIONAL ENGINEER
2-5-99

The seal appearing on this document was authorized by Warren L. Corwin, P.E. 57875, on February 8, 1999

NO.	REVISIONS	BY	DATE

CORWIN ENGINEERING, INC.
8131 LBJ FREEWAY, SUITE 333
DALLAS, TEXAS 75251 (972) 480-0305

DEVELOPMENT PLANS FOR
LAKESIDE VILLAGE
PHASE V-B
ROCKWALL, TEXAS

TAHOE DRIVE

DRAWN BY	DESIGNED BY	CHECKED BY	SHEET NO.
RDS	CEI	CEI	5 OF 10
JOB NUMBER	DATE	SCALE: 1"=4' V, 1"=40' H	
9853	OCTOBER 1998		