GRAPHIC SCALE

100 0 50 100 200 400

(IN FEET)
1 inch = 100 ft.

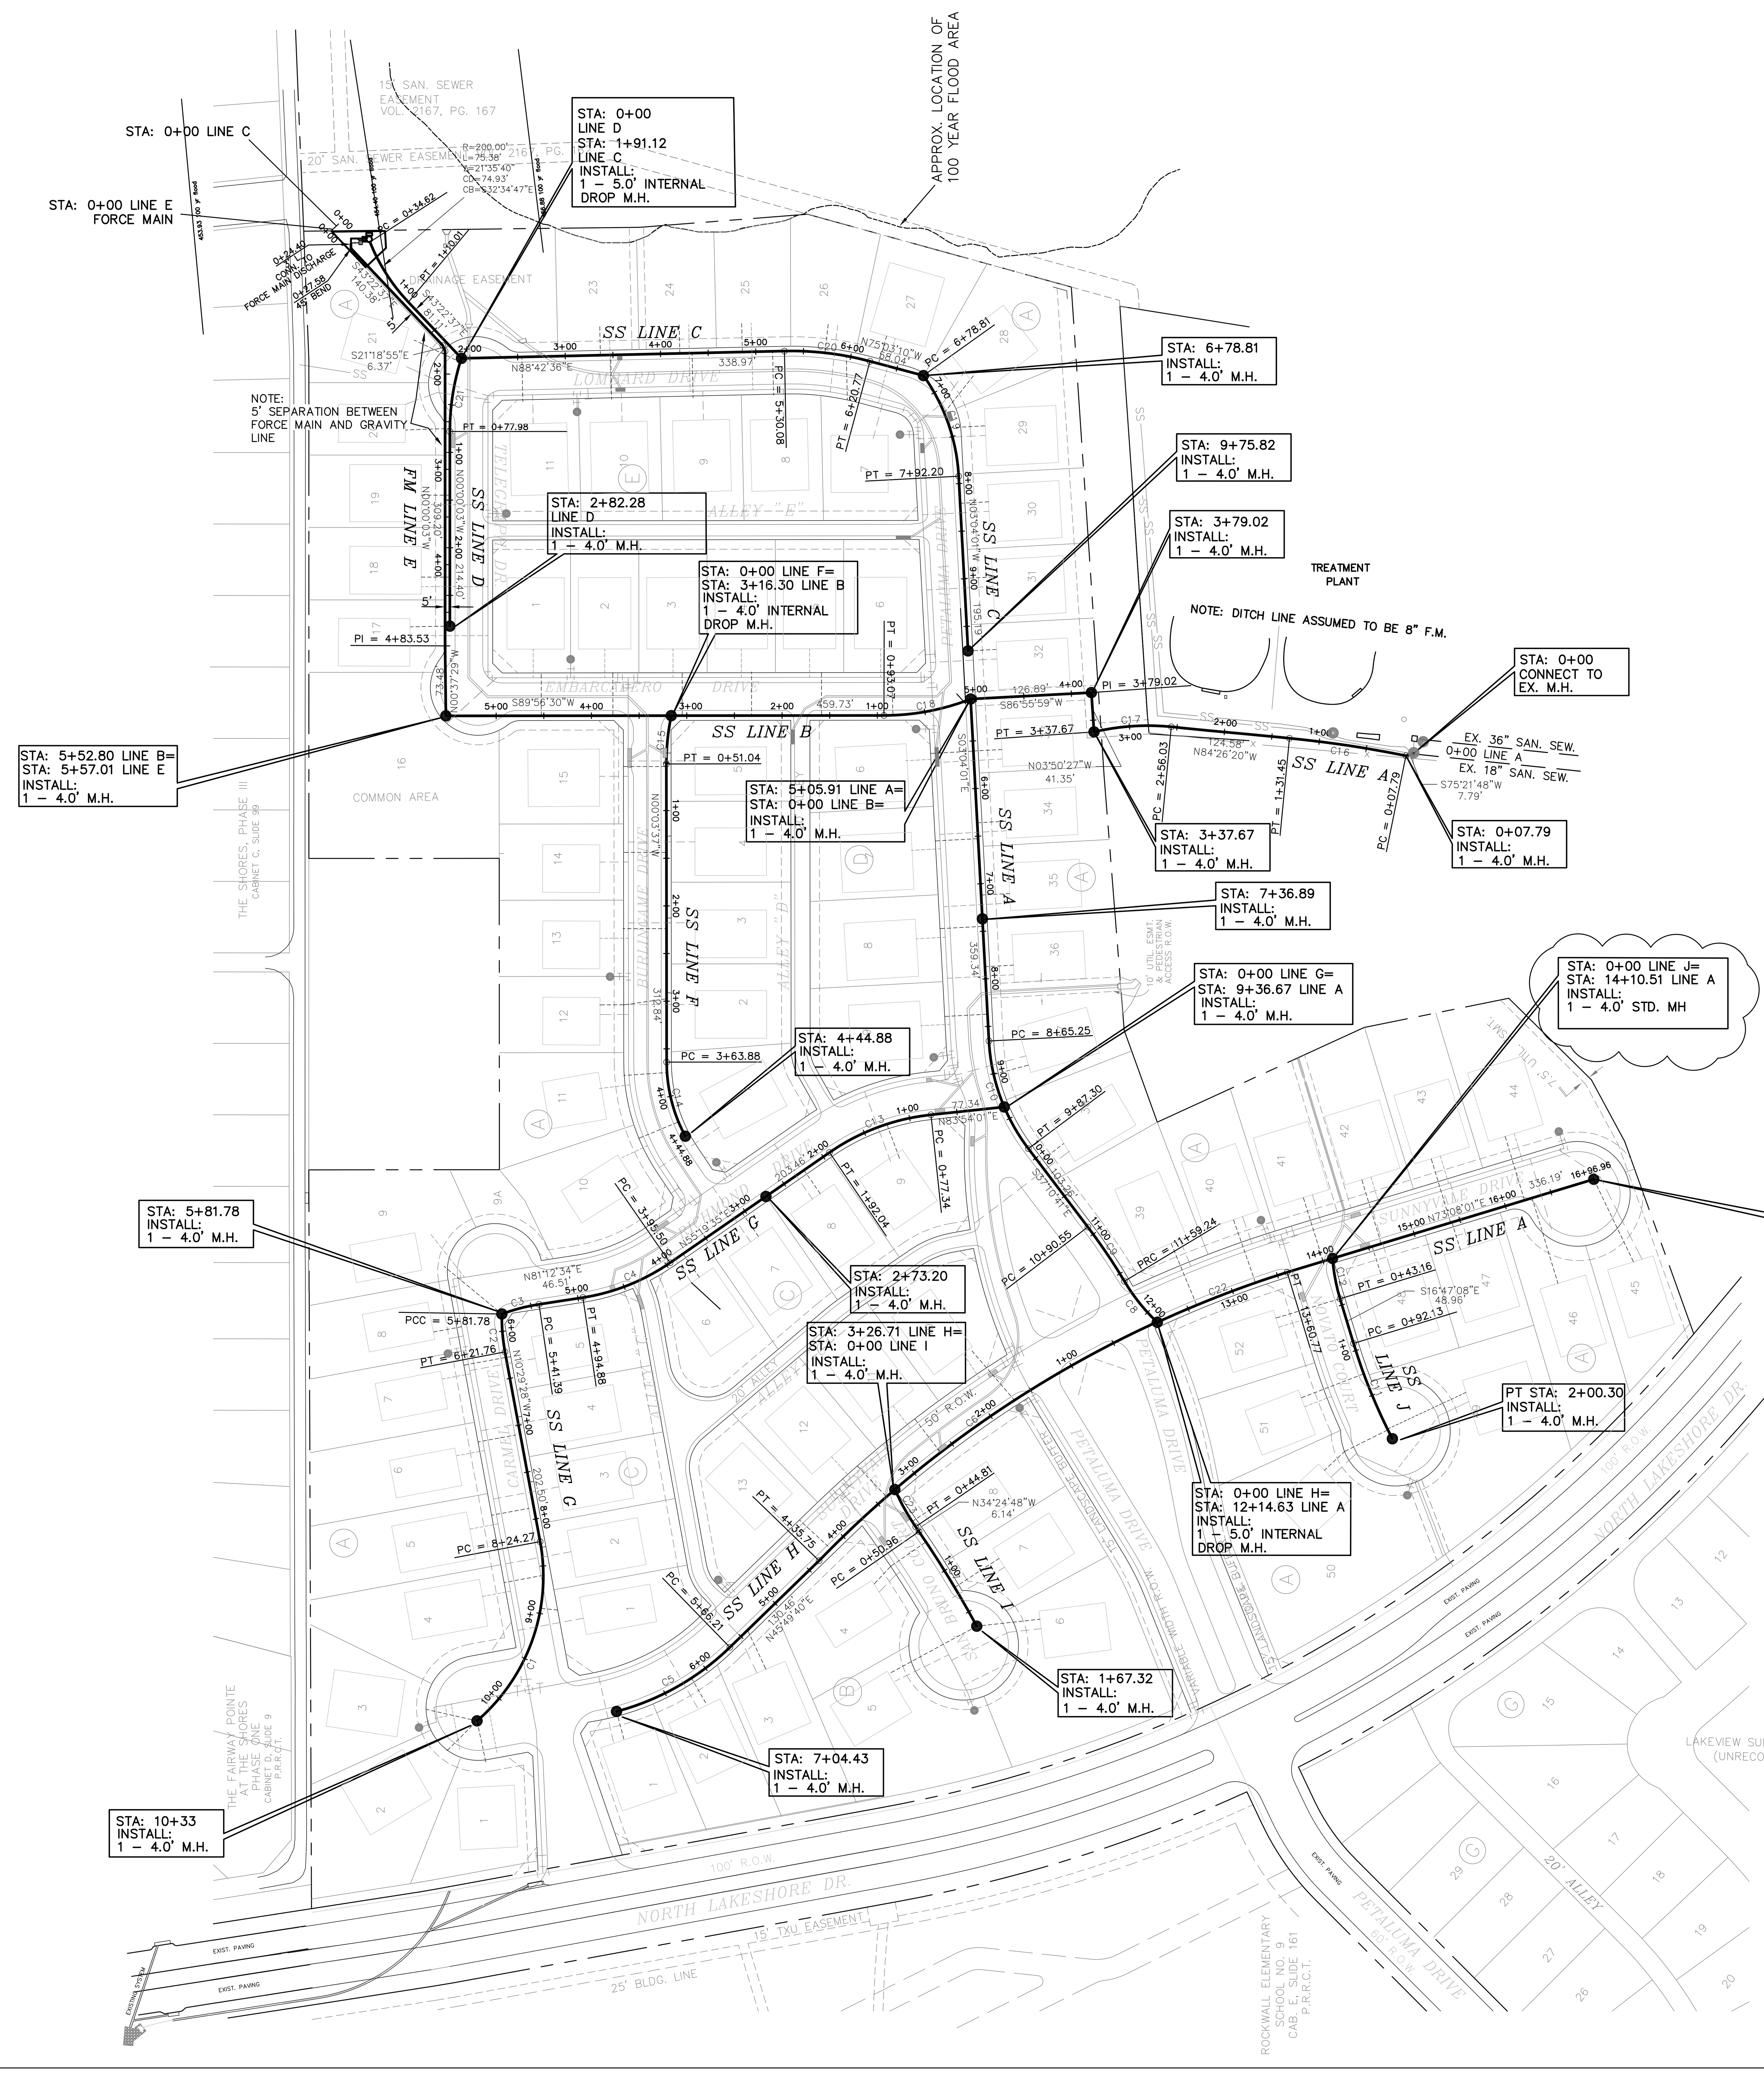

CURVE TABLE					
CURVE	LENGTH	RADIUS	DELTA	CD	CB
C1	248.76	200.00	71°15'54"	233.03	N25°08'29"E
C2	39.98	200.00	11°27'16"	39.92	S04°45'50"E
C3	40.39	200.00	11°34'14"	40.32	S75°25'28"W
C4	99.38	220.00	25°52'59"	98.54	N68°16'05"E
C5	158.72	270.00	33°40'53"	156.44	N62°40'06"E
C6	435.75	1180.50	21°08'57"	433.28	S54°44'04"W
C7	216.97	1110.73	11°11'31"	216.62	N28°49'02"W
C8	55.39	200.00	15°52'04"	55.21	S38°42'26"E
C9	68.69	614.50	6°24'17"	68.65	N33°58'32"W
C10	122.05	205.00	34°06'39"	120.25	S20°07'21"E
C11	108.17	585.97	10°34'37"	108.02	S22°11'16"E
C12	43.16	200.00	12°21'56"	43.08	S10°36'59"E
C13	114.70	230.00	28°34'26"	113.52	S69°36'48"W
C14	93.17	165.00	32°21'16"	91.94	S16°14'15"E
C15	51.04	250.00	11°41'51"	50.95	S05°47'18"W
C16	123.66	1189.75	5°57'18"	123.60	N81°27'41"W
C17	81.64	250.00	18°42'34"	81.27	S86°12'23"W
C18	93.07	250.00	21°19'46"	92.53	N79°16'37"E
C19	113.39	200.00	32°28'59"	111.87	N19°18'31"W
C20	90.69	320.00	16°14'14"	90.38	N83°10'17"W
C21	77.98	250.00	17°52'22"	77.67	S08°56'08"W
C22	146.14	1180.00	7°05'45"	146.05	S68°54'22"W
C23	44.81	250.00	10°16'14"	44.75	S29°16'41"E

LEGEND

TYPICAL 4" SERVICE LINE

NOTE:

ALL MAN HOLES IN PROPOSED STREETS SHALL BE SEALED AND RAVEN LINED OR APPROVED EQUAL.

REVISIONS:
1. 4–19–15 SHORTENED LINE G 40.03'
2. 4–22–15 SHORTENED LINE D 10.10'
3. 4–23–15 SHORTENED LINE C 11.57'
4. 4–23–15 SHORTENED LINE I 28.64'
5. 4–23–15 SHORTENED LINE H 20.50'
6. 4–24–15 SHORTENED LINE F 12.17'
7. ADJUST SEWER SERVICE LOCATIONS TO ACCOMMODATE DRIVEWAYS
8. 9–17–15 CHANGED DROP MH TO STD 4' DIA MH STA 14+10.51 LINE A
9. 9–24–15 REVISED TOP OF M.H. ELEVATIONS

BENCHMARKS:

BRASS CAP MONUMENT NO. 10 SET IN CONCRETE IN THE CENTER OF GRASS MEDIAN IN MASTERS DRIVE BETWEEN NORTH LAKESHORE & SHORES BLVD.

N 7032464.6317, E 2589554.1518
ELEV. = 524.62

STATE OF TEXAS
W.L. DOUPHRATE II
60102
REGISTERED PROFESSIONAL ENGINEER

THE SEAL APPEARING ON THIS DOCUMENT WAS AUTHORIZED BY W.L. DOUPHRATE II TEXAS P.E. NO. 60102, F–886, ON DATE: OCT. 3, 2014

DOUPHRATE & ASSOCIATES, INC.
ENGINEERING • PROJECT MANAGEMENT • SURVEYING
2235 RIDGE RD., # 200 ROCKWALL, TEXAS 75087
PHONE: (972)771–9004 FAX: (972)771–9005

SANITARY SEWER PLAN
LAKEVIEW SUMMIT
PHASE 4
CITY OF ROCKWALL, ROCKWALL COUNTY, TEXAS

REVISION

S.A.H.
CHECKED

D.L.B.
DRAWN

10/14
DATE

9919-4-SS
PROJECT

10
OF