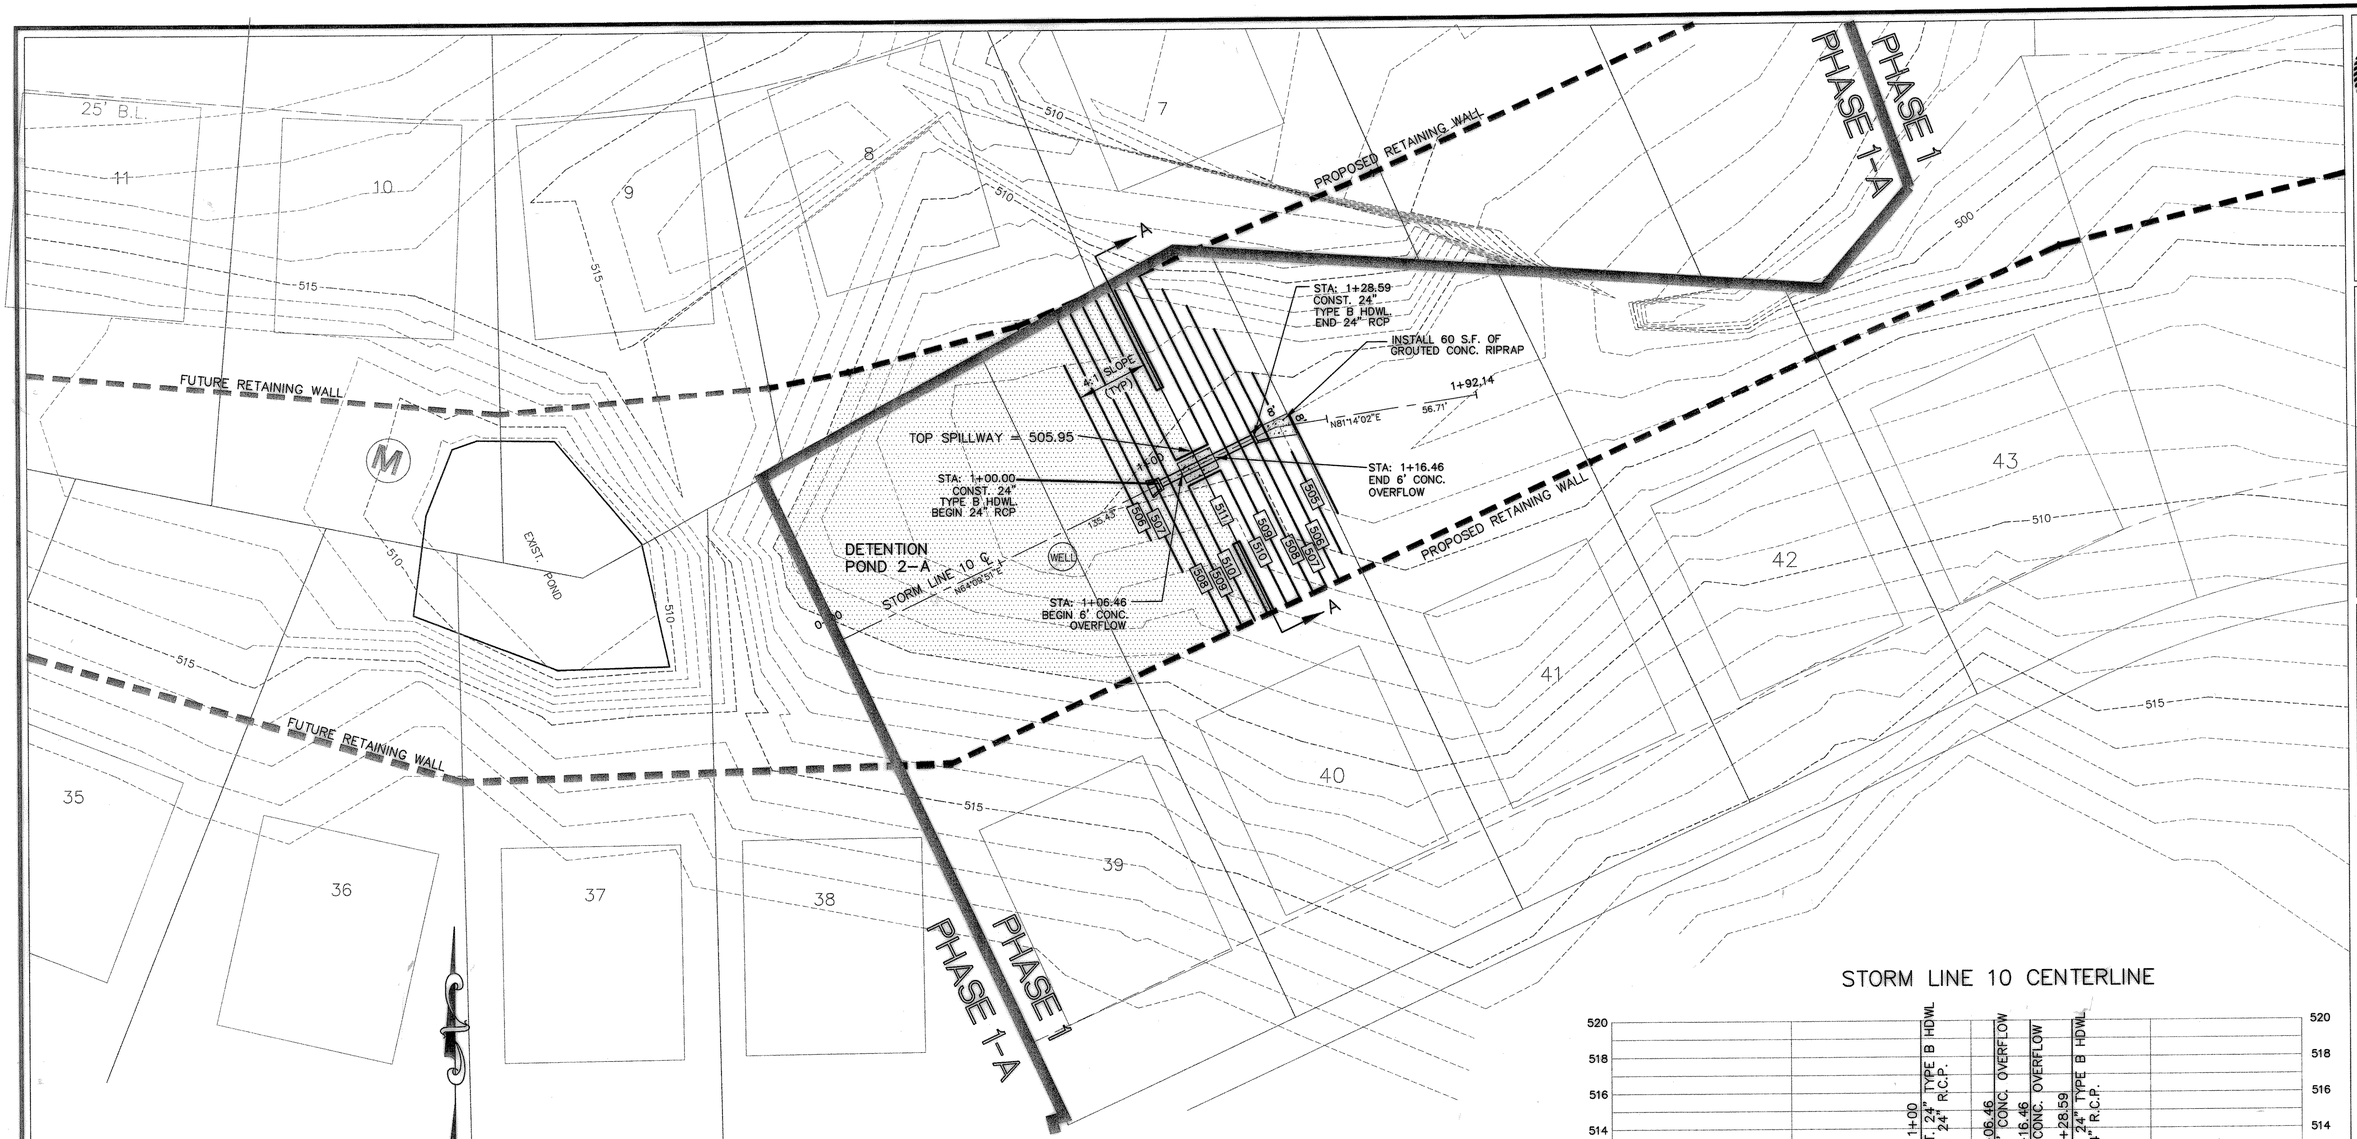

GRAPHIC SCALE

20 0 10 20 40 60

(IN FEET)
1 inch = 20 ft.
1"=4'VERT

SEE TR-20 DATA OF LAKE VIEW SUMMIT PHASE 1 REPORT PREPARED BY NWRS FOR CITY OF ROCKWALL

SECTION A-A

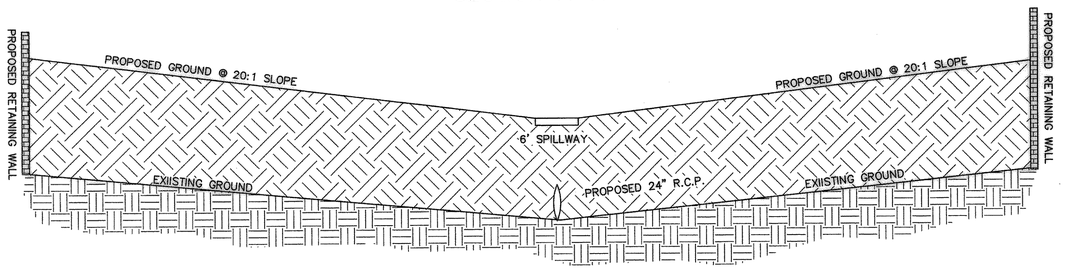

STORM LINE 10 CENTERLINE

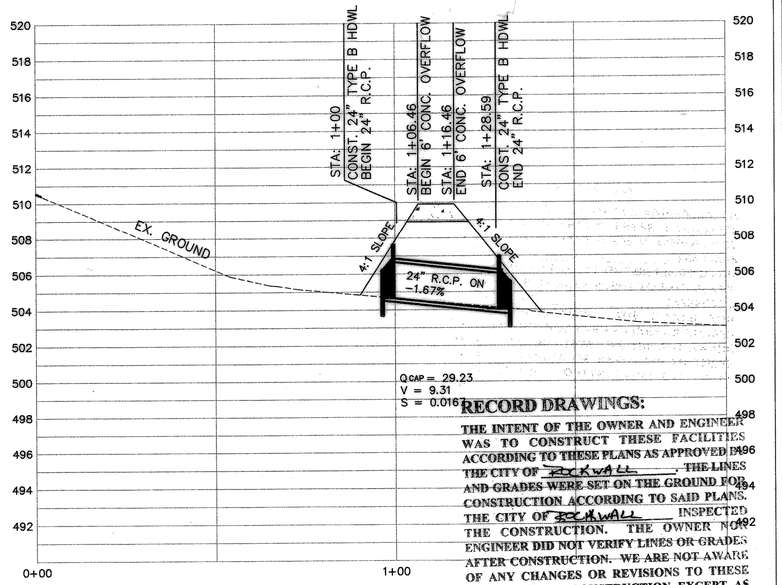

RECORD DRAWINGS:

THE INTENT OF THE OWNER AND ENGINEER WAS TO CONSTRUCT THESE FACILITIES ACCORDING TO THESE PLANS AS APPROVED BY THE CITY OF ~~ROCKWALL~~, THE LINES AND GRADES WERE SET ON THE GROUND FOR CONSTRUCTION ACCORDING TO SAID PLANS. THE CITY OF ~~ROCKWALL~~ INSPECTED THE CONSTRUCTION. THE OWNER ~~AND~~ ENGINEER ~~DID NOT~~ VERIFY LINES OR GRADES AFTER CONSTRUCTION. ~~WE ARE NOT~~ AWARE OF ANY CHANGES OR REVISIONS TO THESE PLANS DURING CONSTRUCTION EXCEPT AS NOTED 4/18/02

THE SEAL APPEARING ON THIS DOCUMENT WAS AUTHORIZED BY W.L. DOUPHRATE P.E. 60102 ON 4/4/01

DOUPHRATE & ASSOCIATES, INC.
ENGINEERING • PROJECT MANAGEMENT • SURVEYING
2235 RIDGE RD., # 200 ROCKWALL, TEXAS 75087
PHONE: (972)771-9004 FAX: (972)771-9005

DETENTION POND 2-A
LAKEVIEW SUMMIT, PHASE 1-A
CITY OF ROCKWALL
COUNTY OF ROCKWALL

REVISION	
W.L.D.	CHECKED
K.E.B.	DRAWN
12/00	DATE
9919-1ASTM7	PROJECT
42-A	OF