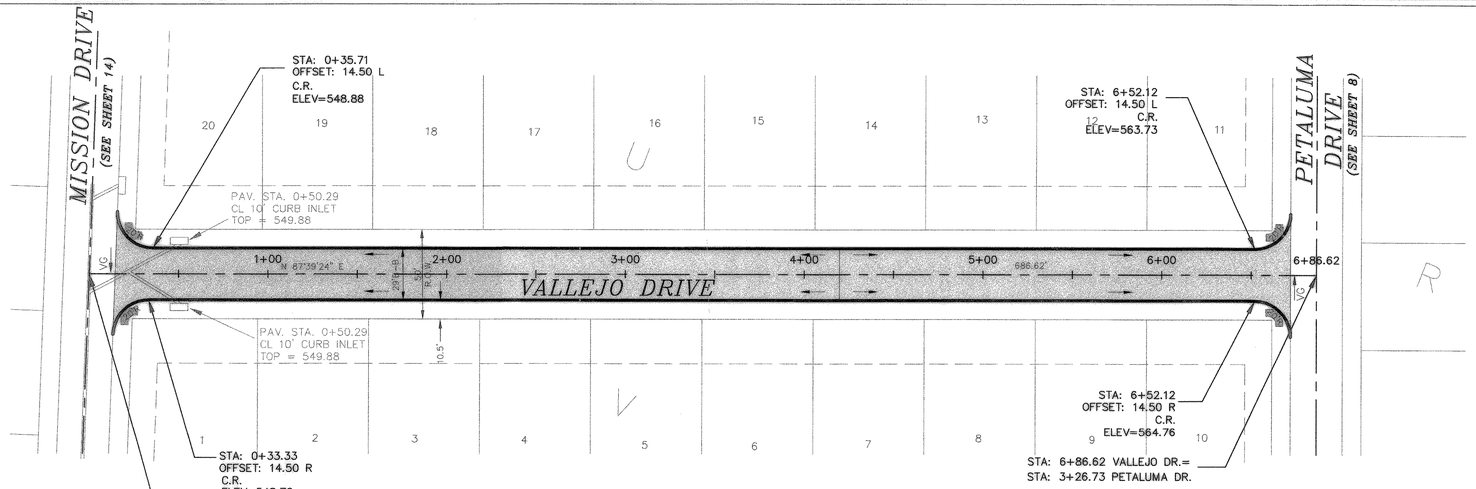

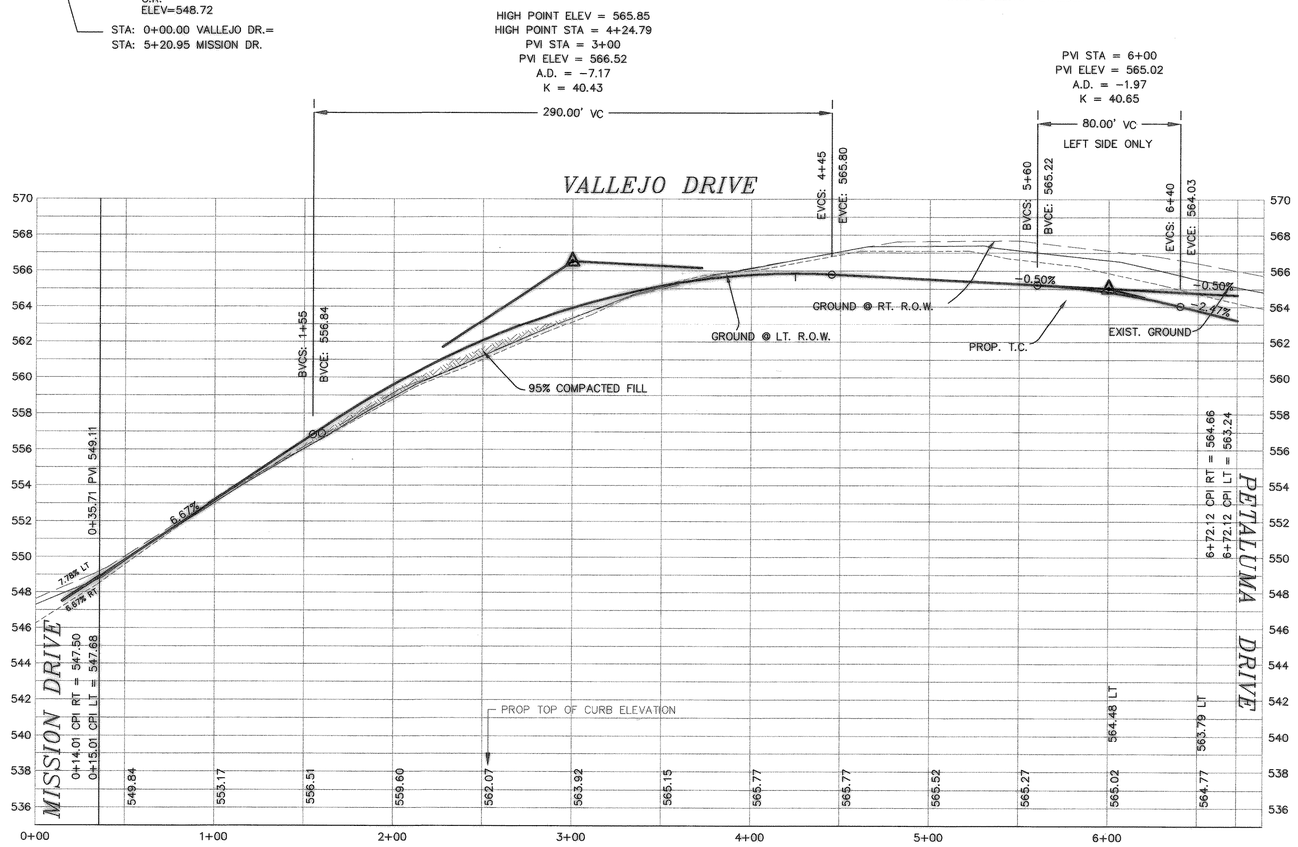

GRAPHIC SCALE

40 0 20 40 80 160

(IN FEET)
1 inch = 40 ft.
1"=4'VERT

BENCHMARK:

BRASS CAP MONUMENT NO. 10 SET IN CONCRETE IN THE CENTER OF GRASS MEDIAN IN MASTERS DRIVE BETWEEN NORTH LAKESHORE & SHORES BLVD.
N 7032464.6317, E 2589554.1518
ELEV. = 524.62

REVISED TO CONFORM TO CONSTRUCTION RECORDS.

DATE: 11/4/02

THE SEAL APPEARING ON THIS DOCUMENT WAS AUTHORIZED BY W.L. DOUPHRATE II TEXAS P.E. NO. 60102 ON 1/4/02

DOUPHRATE & ASSOCIATES, INC.
ENGINEERING • PROJECT MANAGEMENT • SURVEYING
2235 RIDGE RD., # 200 ROCKWALL, TEXAS 75087
PHONE: (972)771-9004 FAX: (972)771-9005

PAVING PLAN & PROFILE
VALLEJO DRIVE
LAKEVIEW SUMMIT, PHASE 2
CITY OF ROCKWALL, ROCKWALL COUNTY, TEXAS

REVISION
- REVISIONS PER CITY COMMENTS 2/6/02

CHECKED	W.L.D.
DRAWN	K.E.B.
DATE	01/02
PROJECT	9919-2PV4

11

M:\projects\9919-2\9919-2PV4.dwg 02/21/02 01:28:10 PM CST