DATE	BY	APPR

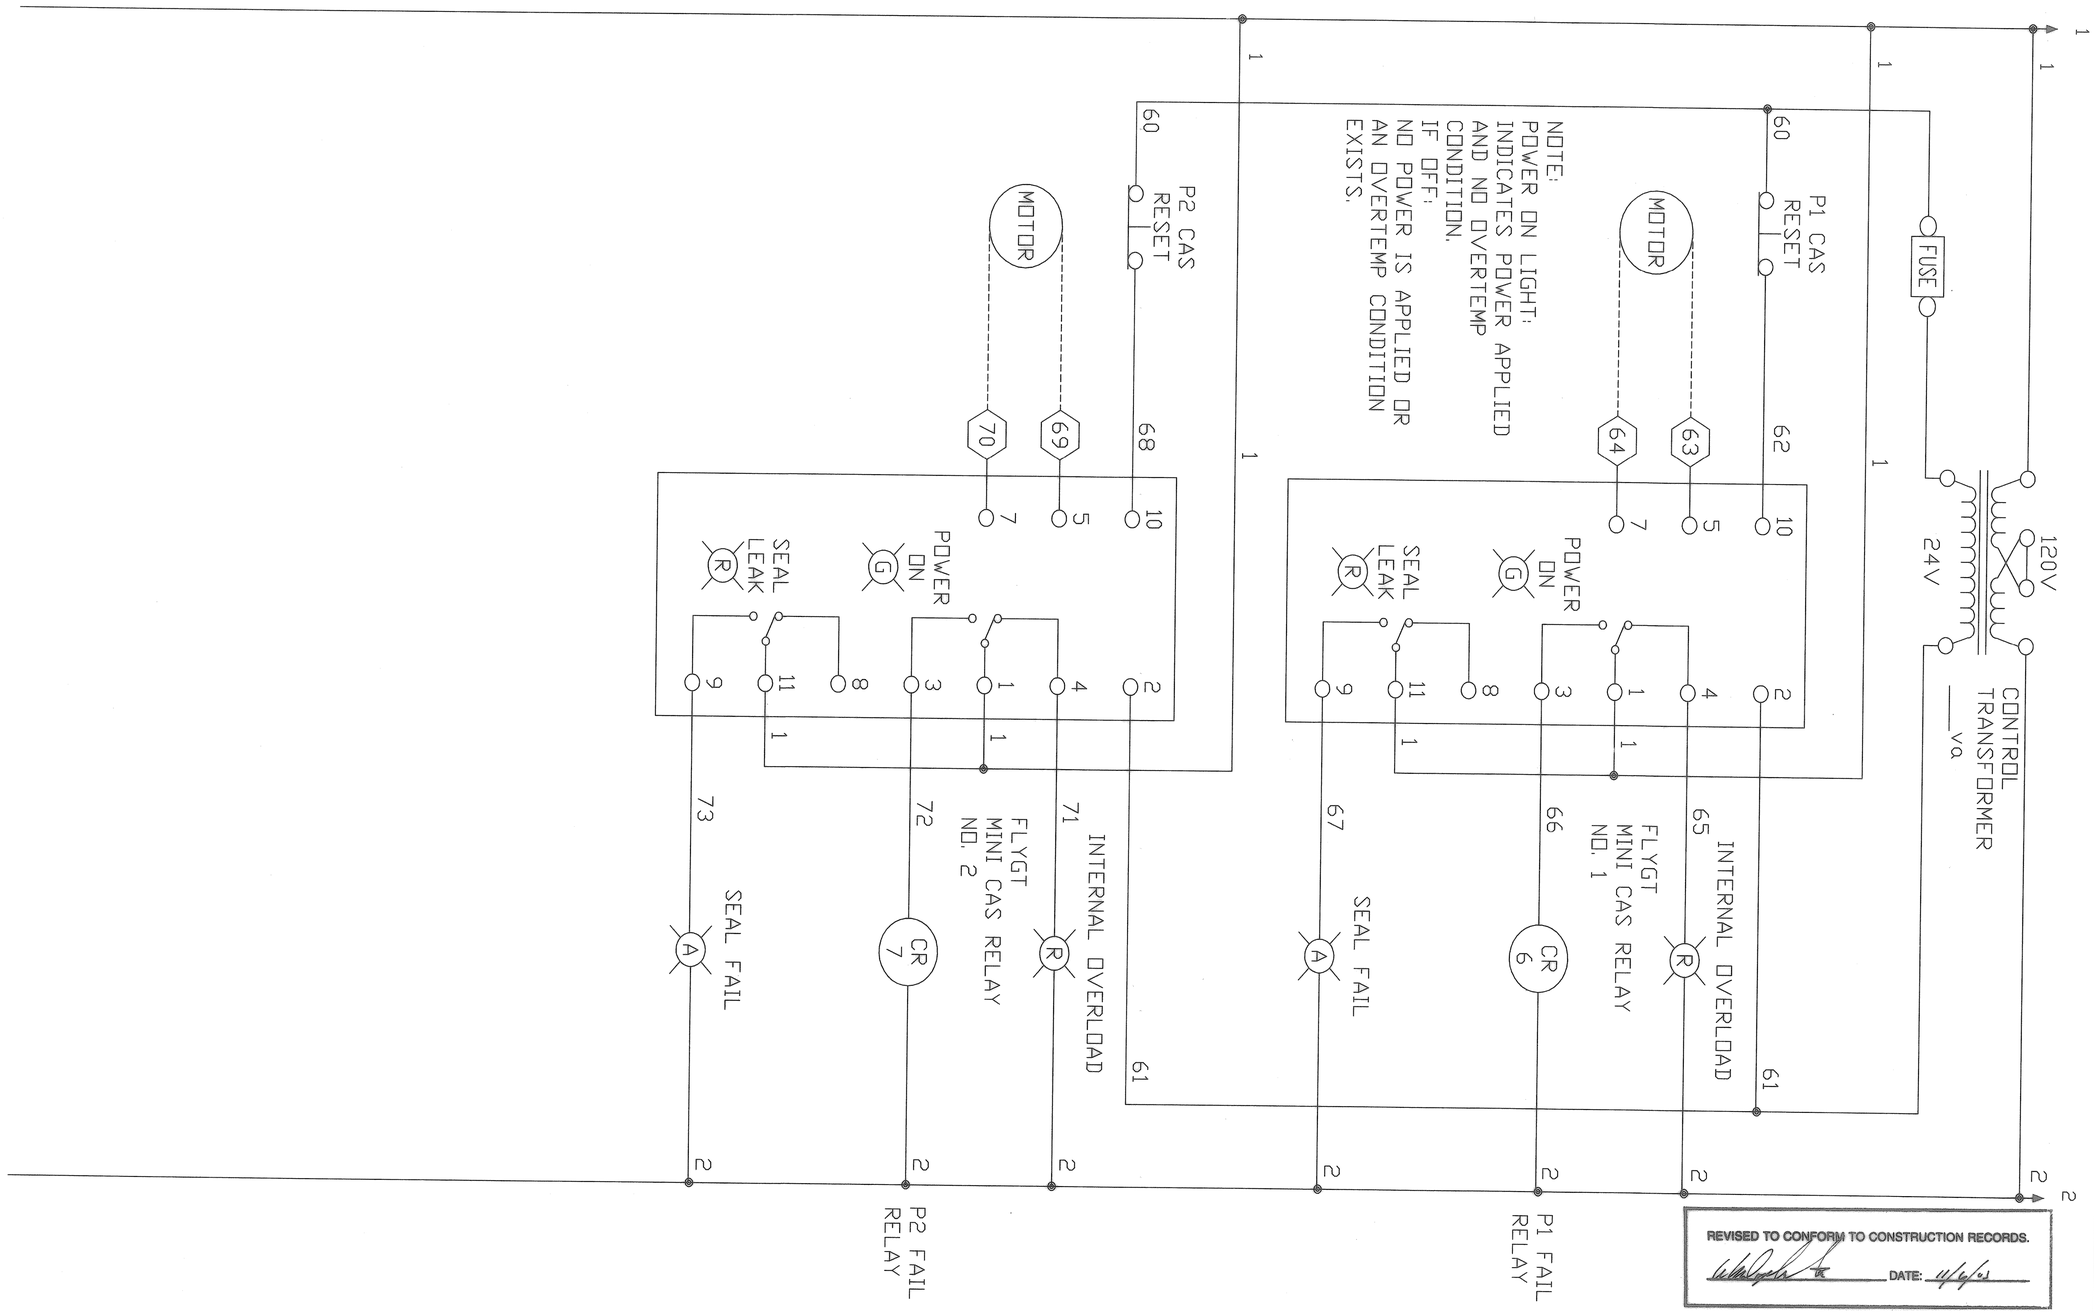

REVISED TO CONFORM TO CONSTRUCTION RECORDS.

DATE: 4/9/03

ITEM NO	QTY REQD	PART NUMBER OR DRAWING NUMBER	DESCRIPTION
NA-4			
NA-3			
NA-2			
NA-1			
NEXT ASSEMBLY			

LIST OF MATERIALS

TOLERANCES
(UNLESS NOTED OTHERWISE)
.X ± .02
.XX ± .010
.XXX ± .005
FRACTIONAL ± 1/16
ANGULAR ± 1/2°
SURFACE FINISH 125
DEBURR & REMOVE SHARP EDGES

DO NOT SCALE

PLOTTED

MAC CONTROLS
ROWLETT, TEXAS

DESCRIPTION
CITY-OF-ROCKWALL-DUPLEX-CONTROL-PANEL

PRODUCT
LAKEVIEW-SUMMITT-PHASE-II

DATE 03-19-02	SCALE SCALE
DRAWN WDB	
CHECK CHECKER	
ENGR JSMITH	
WT WEIGHT	
SHT 37	REV 1
DWG. NO. ROCK-3	