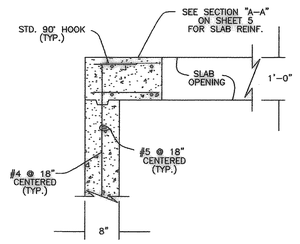

DETAIL "A"

N.T.S.

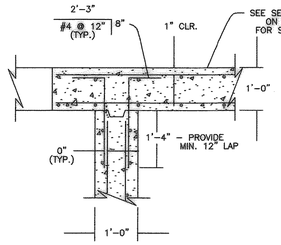

DETAIL "B"

N.T.S.

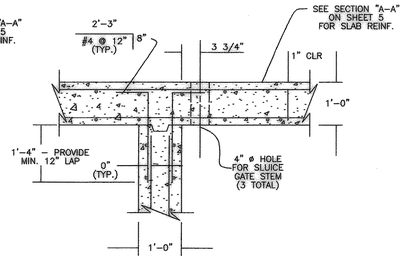

DETAIL "C"

N.T.S.

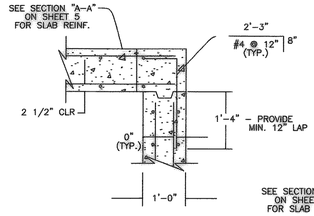

DETAIL "D"

N.T.S.

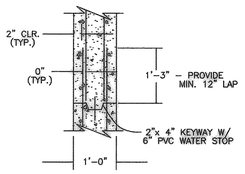

DETAIL "E"

N.T.S.

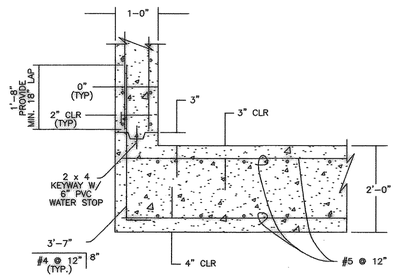

DETAIL "F"

N.T.S.

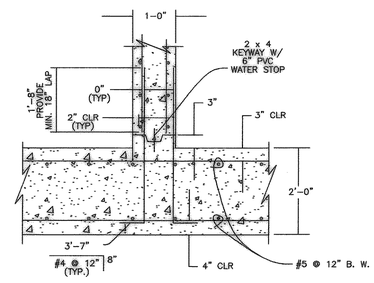

DETAIL "G"

N.T.S.

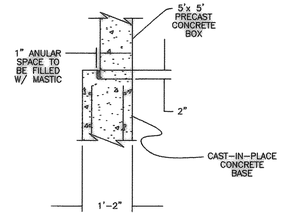

DETAIL "H"

N.T.S.

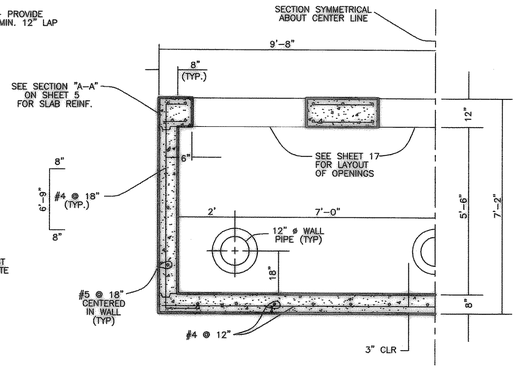

PARTIAL SECTION C–C

N.T.S.

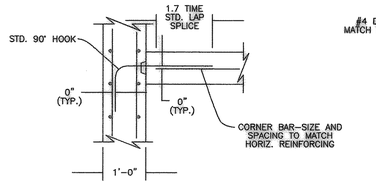

SINGLE CURTAIN REINFORCING AT INTERSECTION WITH DOUBLE CURTAIN REINFORCED WALL

N.T.S.

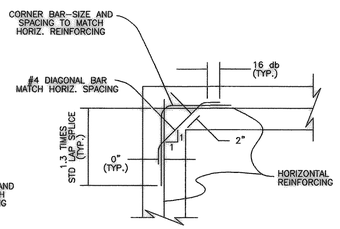

SINGLE CURTAIN REINFORCING AT WALL CORNER

N.T.S.

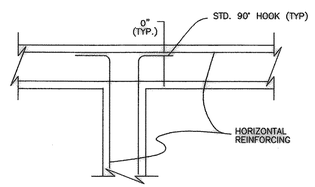

DOUBLE CURTAIN REINFORCING AT INTERSECTION WITH DOUBLE CURTAIN REINFORCED WALL

N.T.S.

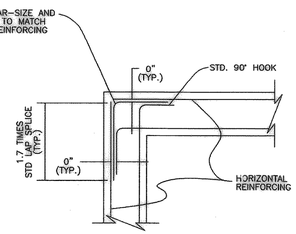

DOUBLE CURTAIN REINFORCING AT WALL CORNER

N.T.S.

TYPICAL CORNER DETAILS

NOTE: VERTICAL REINFORCEMENT NOT SHOWN FOR CLARITY.

REVISED TO CONFORM TO CONSTRUCTION RECORDS.

DATE: 11/6/03

REV.	DESCRIPTION	BY	DATE	APVD.	DATE

FLYGT

ITT FLYGT CORPORATION
TRUMBULL, CONNECTICUT 06611

	DATE	BY
DRAWN		
CHKR.		
PROJ. ENGR.		
APVD.		

LIFT STATION DETAILS

REF.

SCALE

NUMBER 34

REV.

M:\projects\9919-2\9919-2LS2.dwg 02/20/02 09:51:08 AM CST