PLAN OF RECORD

This record drawing is a compilation of the sealed engineering drawing for permit and construction, by others; modified based on a field observation by BIG RED DOG. The information shown on the record drawings that was provided for permit and construction, by others not associated with the record drawing engineer, cannot be verified for accuracy or completeness. Review is for general conformance with construction documents and on-site improvements. The original approved sealed drawings are on file at the offices of the City of Rockwall.

Therefore, with the exceptions noted and clouded, this "Plan of Record" is true and correct to the best of my knowledge and was prepared under my supervision.

STATE OF TEXAS
GRAYSON K. HUGHES
114327
LICENSED
PROFESSIONAL ENGINEER

September 28, 2018

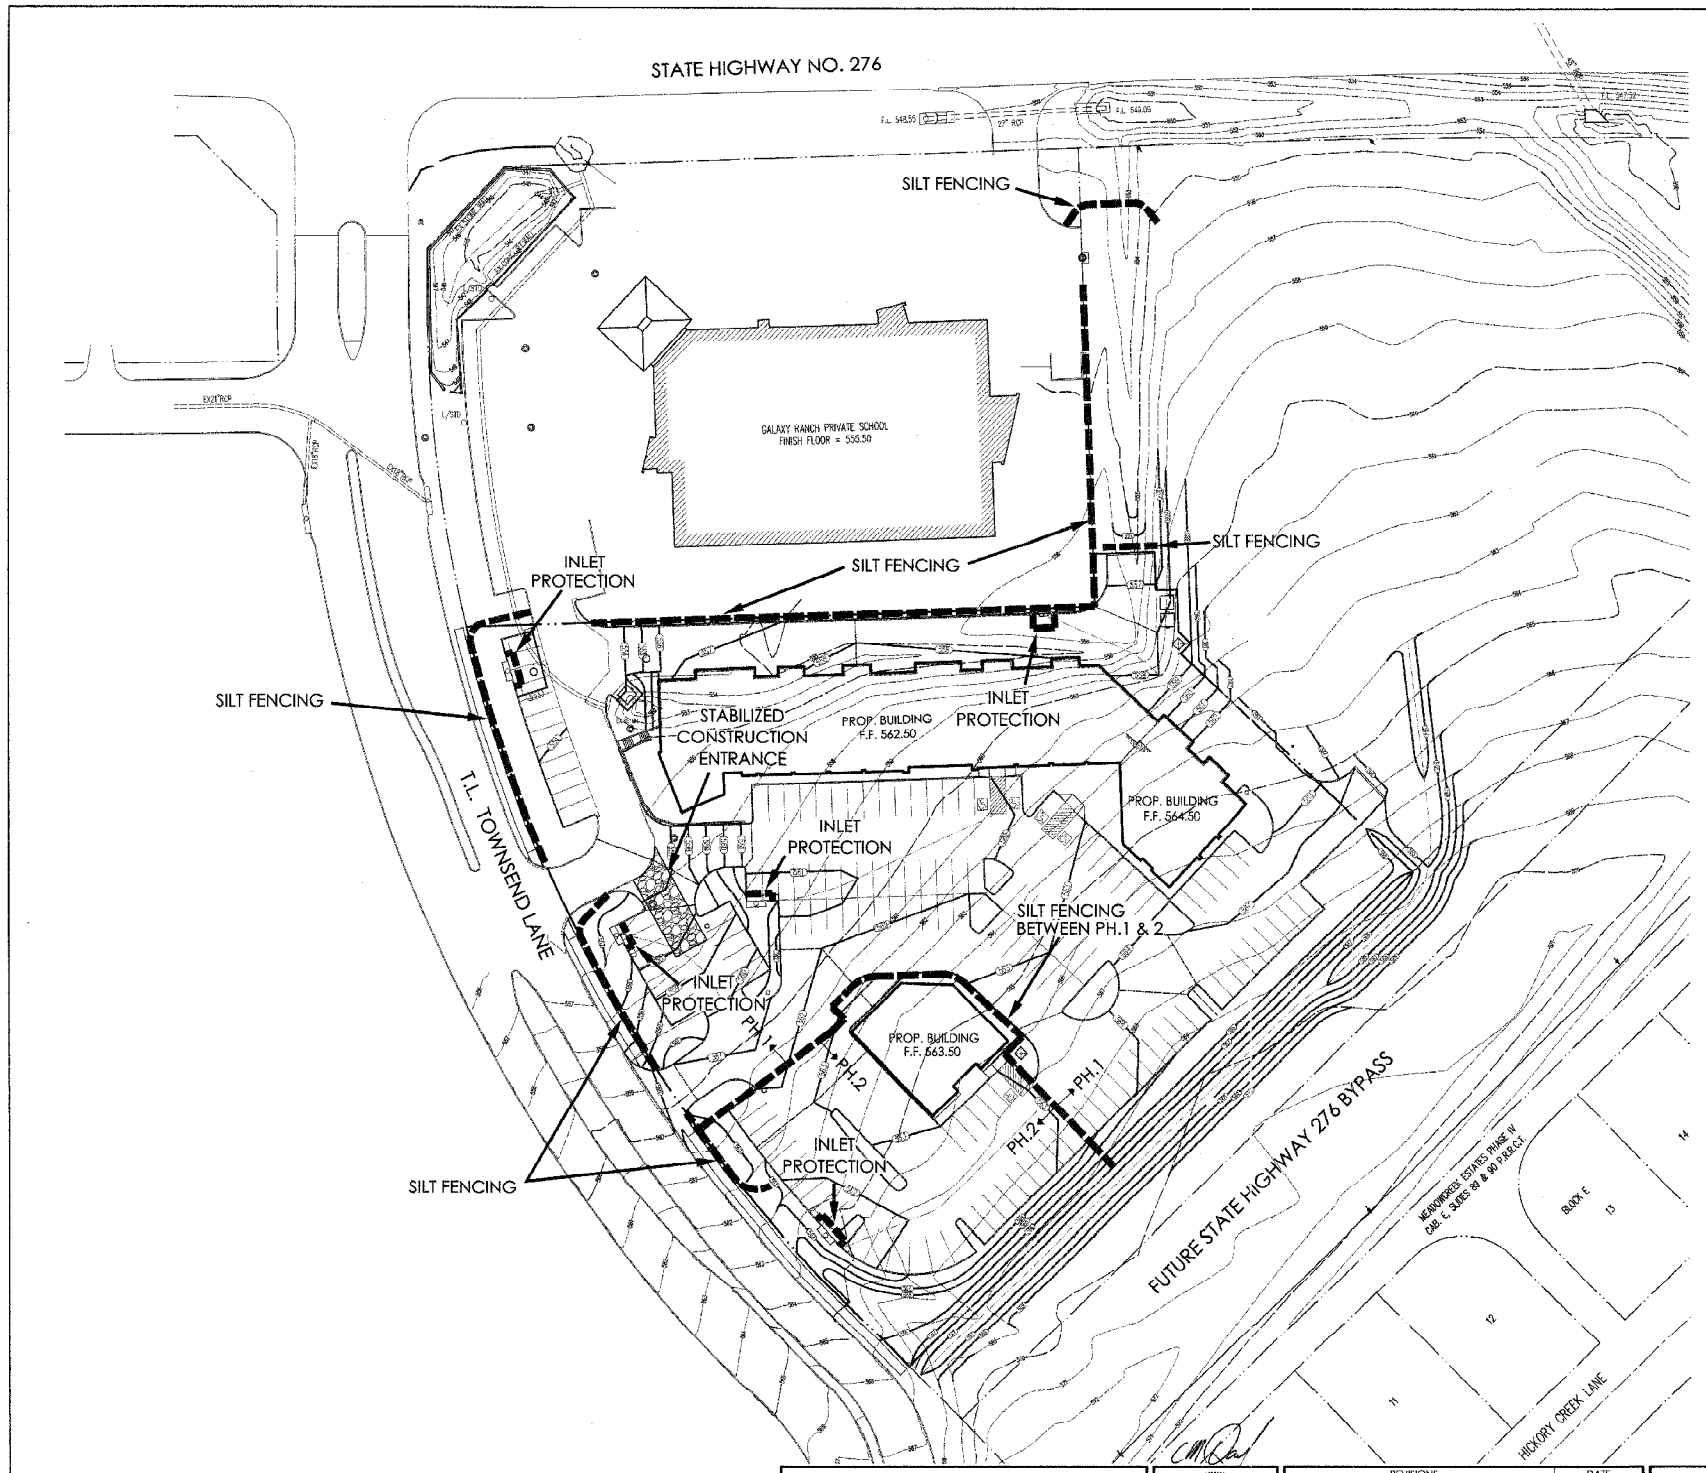

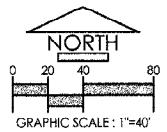

LEGEND

- DIRECTION OF FLOW
- EXISTING CONTOURS
- PROPOSED SILT FENCE
- PROPOSED INLET PROTECTION
- PROPOSED CONSTRUCTION ENTRANCE

Contractor responsible to locate, establish & maintain staging area and concrete washout area erosion control measures. See SWP3 document.

LIMITS OF DISTURBANCE = 2.7 Ac.

CONTRACTOR SHALL CONTACT UNDERGROUND UTILITY LOCATOR SERVICE NO EARLIER THAN 14 DAYS AND NO LATER 48 HOURS PRIOR TO ANY EXCAVATION EXCEEDING A DEPTH OF 16 INCHES
1-800-DIG-TESS

ENGINEER:
NATHAN D. MAIER CONSULTING ENGINEERS, INC.
CONTACT: MIKE DANIEL (214)739-4741

SITE BENCHMARK:
CUT "X" ON TOP OF NORTH CURBLINE OF EXISTING CONCRETE DRIVE APPROX. 45 FEET SOUTH OF SOUTH BUILDING WALL OF GALAXY RANCH PRIVATE SCHOOL AND 148 FEET +/- EAST OF EXISTING EAST CURBLINE OF T.L. TOWNSEND LANE.
ELEVATION = 554.56

STATE OF TEXAS
C. MICHAEL DANIEL
62457
REGISTERED
PROFESSIONAL ENGINEER

REVISIONS	DATE

NDM
NATHAN D. MAIER
CONSULTING ENGINEERS, INC.
TEXAS FIRM REGISTRATION NO. F-356
WWW.NDMCE.COM
Two Northpark 8080 Park Lane Suite 600
Dallas, Texas 75231 214.739.4741

EROSION CONTROL PLAN
LARSEN RETAIL DEVELOPMENT
3.154 ACRE TRACT - LARSEN SCHOOL ADDITION
ROCKWALL, ROCKWALL COUNTY, TEXAS

DESIGN	DRAWN	SCALE	DATE	NOTES
NDMCE	NDMCE	1"=40'	2011-03-05	

SHEET NO. 15/16

JOB NUMBER 06-04-038.A

5-6-11