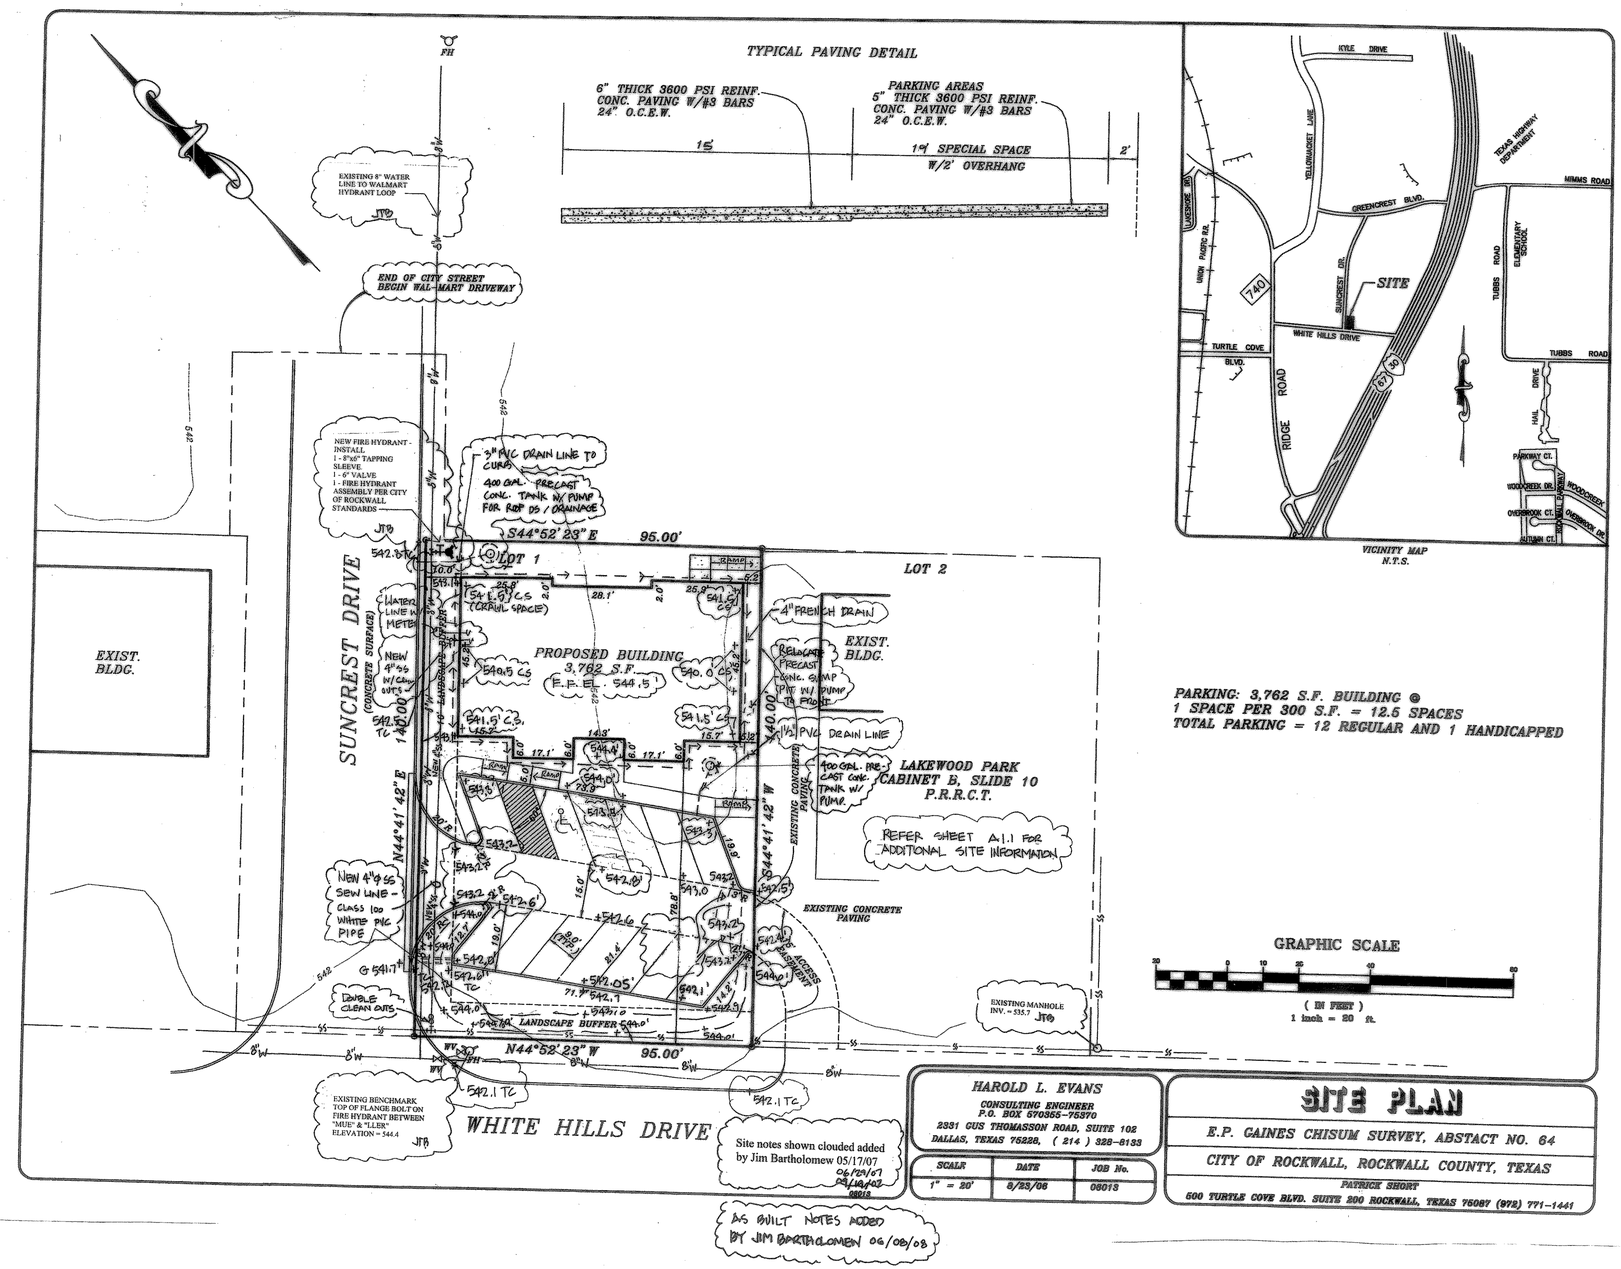

HAROLD L. EVANS
CONSULTING ENGINEER P.O. BOX 570355-7537O 2331 GUS THOMASSON ROAD, SUITE 102 DALLAS, TEXAS 75228, (214) 328-6133

SCALE	DATE	JOB No.
1" = 20'	8/23/06	06013

SITE PLAN

E.P. CAINES CHISUM SURVEY, ABSTACT NO. 64

CITY OF ROCKWALL, ROCKWALL COUNTY, TEXAS

PATRICK SHORT

600 TURTLE COVE BLVD. SUITE 200 ROCKWALL, TEXAS 75087 (972) 771-1441

AS BUILT NOTES ADDED BY JIM BARTHOLOMEW 06/06/08

TRUE NORTH / PLAN NORTH

01 CIVIL ENGINEERING SITE PLAN

SCALE: 1"= 20.0'

ISSUE DATE
08/28/07 PERMIT
09/11/07 Revision
06/29/07 Revision
09/19/07 Revision

THE LAW FIRM OF PATRICK SHORT

WHITE HILLS DRIVE — ROCKWALL, TEXAS

BARTHOLOMEW ASSOCIATES ARCHITECTS
Architecture Planning Interior Design
P.O. Box 276 Rockwall, Texas 75087
Phone: (972) 771-4549

REGISTERED ARCHITECT JAMES F. BARTHOLOMEW 13115 STATE OF TEXAS

09/07/07

SHEET TITLE: CIVIL ENGINEERING SITE PLAN

SHEET NUMBER A1.0