2" TYPE "D" FINE GRADED SURFACE COURSE
ITEM 334 PER TXDOT 1993 SPECIFICATIONS

4" TYPE "A" COURSE GRADED BASE COURSE
ITEM 334 PER TXDOT 1993 SPECIFICATIONS

6" LIME STABILIZED SUBGRADE
TO BE EXTENDED 2 FT. BEYOND EDGE OF PVMT.

ASPHALT PAVEMENT SECTION

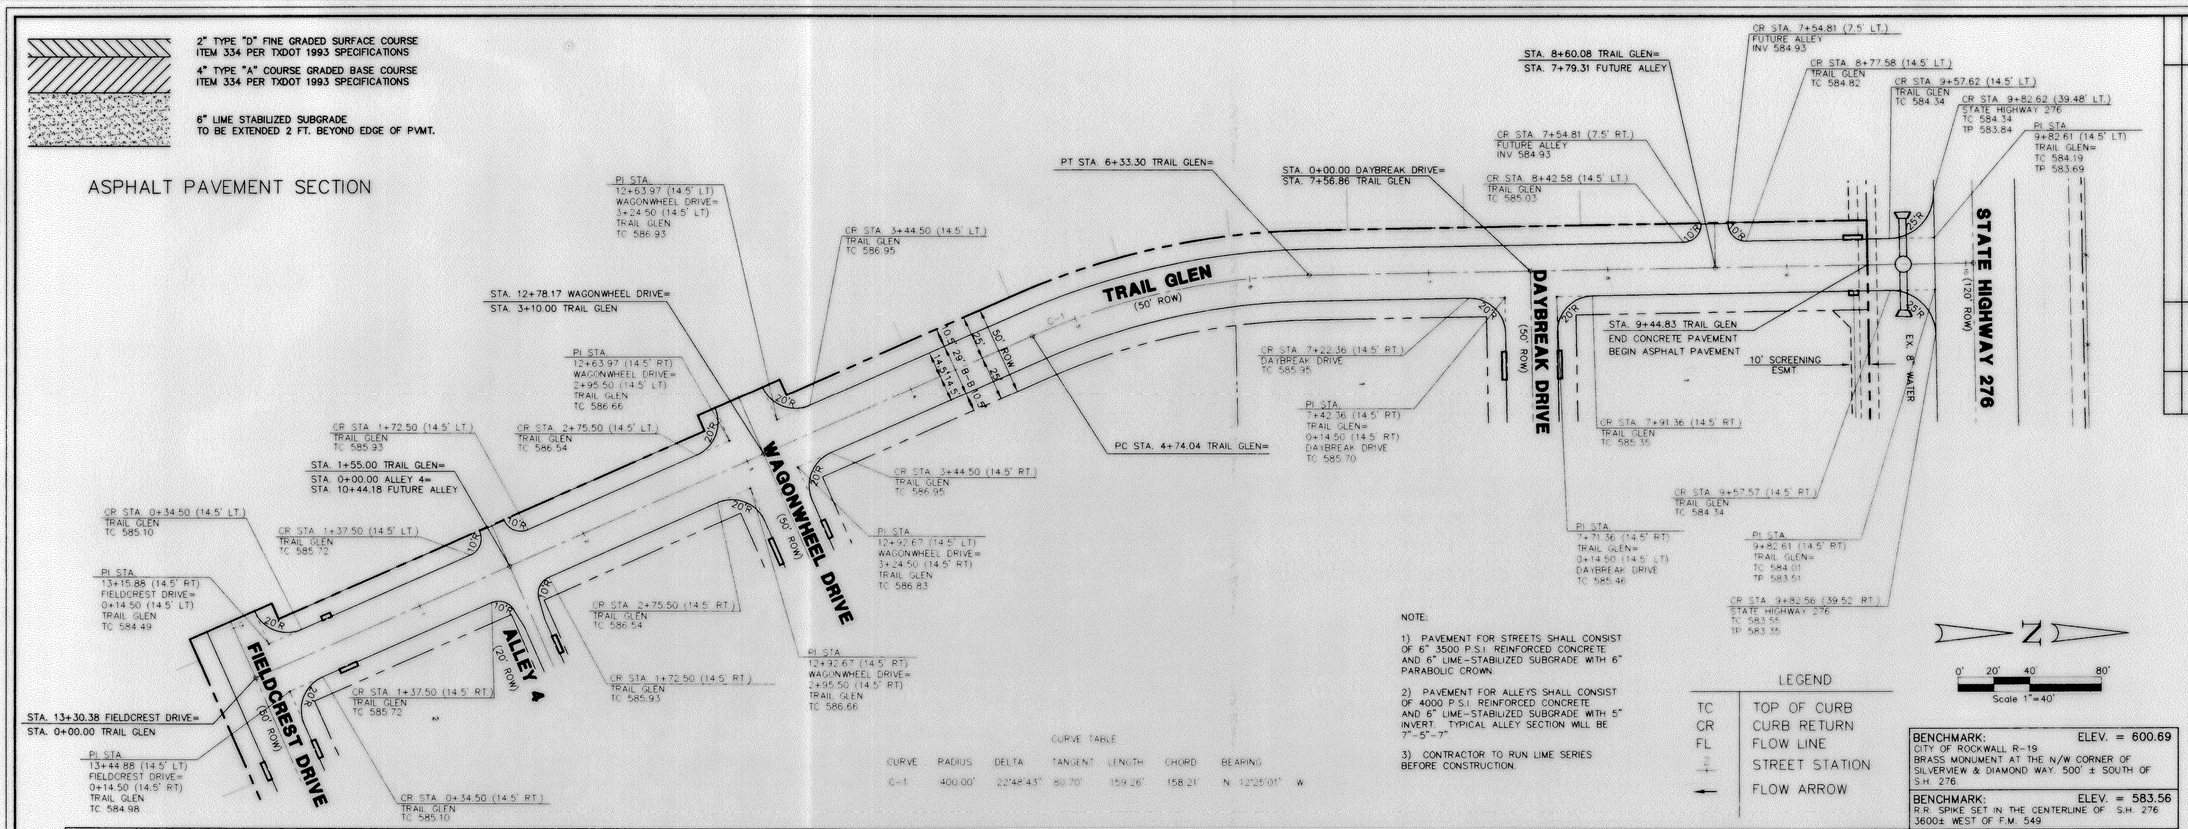

NOTE:

1) PAVEMENT FOR STREETS SHALL CONSIST OF 6" 3500 P.S.I. REINFORCED CONCRETE AND 6" LIME-STABILIZED SUBGRADE WITH 6" PARABOLIC CROWN.

2) PAVEMENT FOR ALLEYS SHALL CONSIST OF 4000 P.S.I. REINFORCED CONCRETE AND 6" LIME-STABILIZED SUBGRADE WITH 5" INVERT. TYPICAL ALLEY SECTION WILL BE 7'-5"-7'

3) CONTRACTOR TO RUN LIME SERIES BEFORE CONSTRUCTION.

CURVE TABLE

CURVE	RADIUS	DELTA	TANGENT	LENGTH	CHORD	BEARING
C-1	400.00'	22°48'43"	80.70'	159.26'	158.21'	N. 12°25'01" W.

LEGEND

TC	TOP OF CURB
CR	CURB RETURN
FL	FLOW LINE
⊕	STREET STATION
←	FLOW ARROW

BENCHMARK: ELEV. = 600.69
CITY OF ROCKWALL R-19
BRASS MONUMENT AT THE N/W CORNER OF SILVERVIEW & DIAMOND WAY. 500' ± SOUTH OF S.H. 276

BENCHMARK: ELEV. = 583.56
R.R. SPIKE SET IN THE CENTERLINE OF S.H. 276
3600± WEST OF F.M. 549

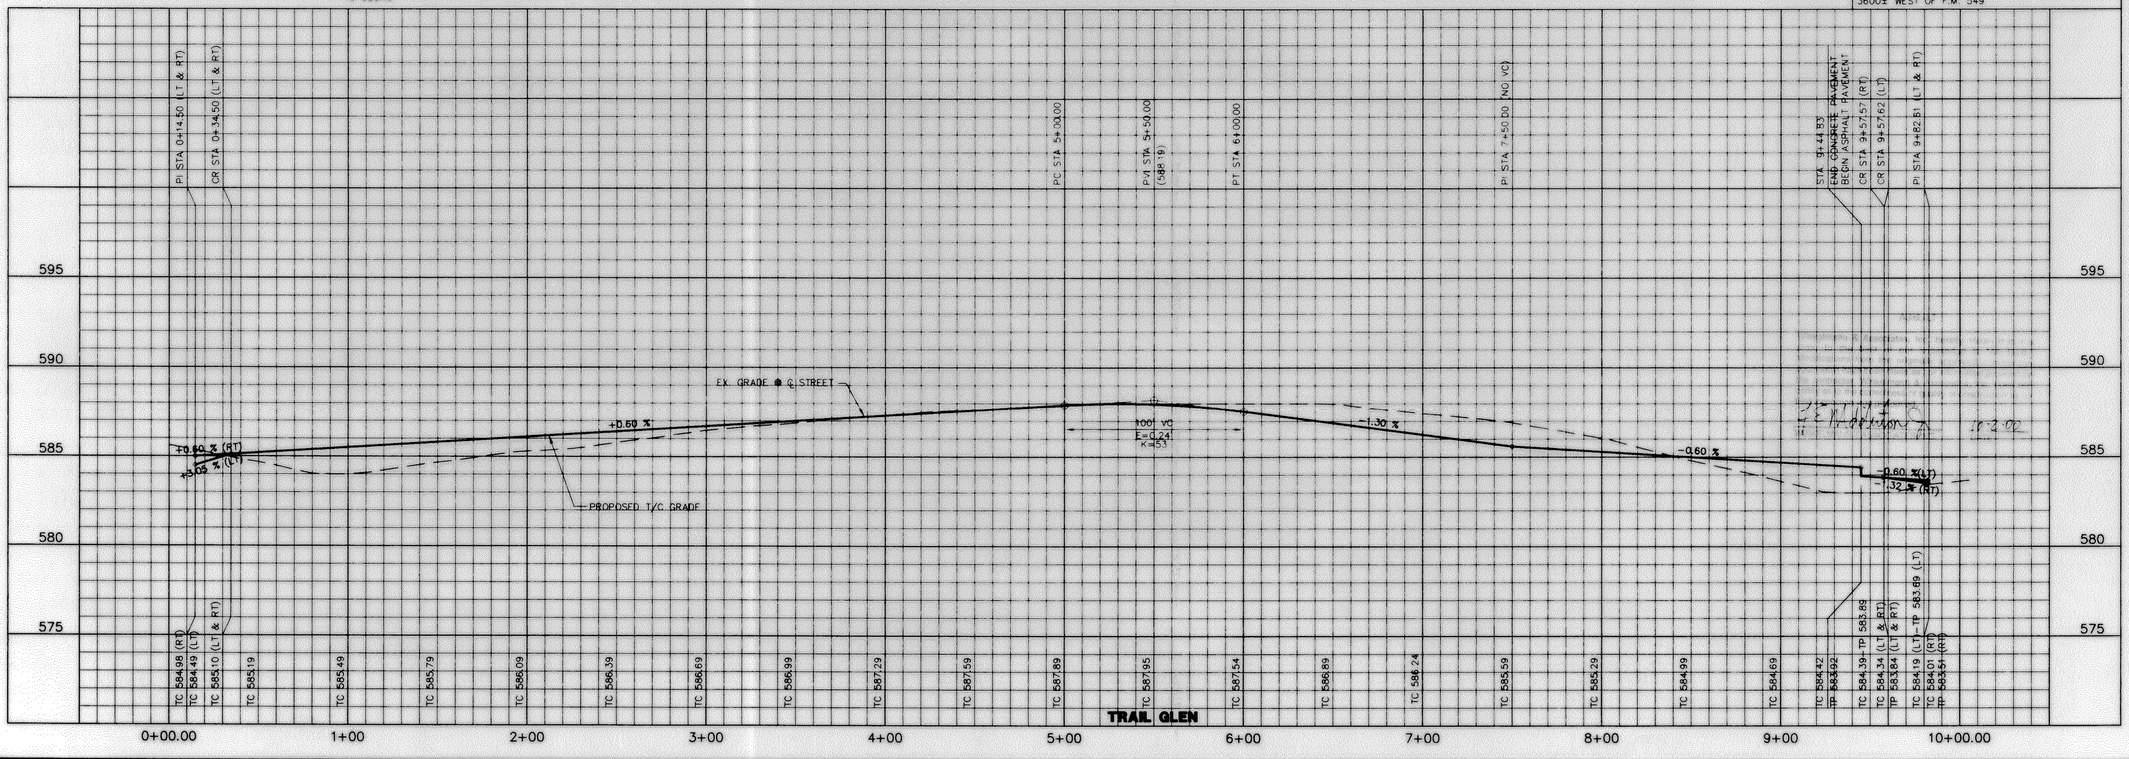

Winkelmann & Associates, Inc.
CONSULTING CIVIL ENGINEERS ■ SURVEYORS
6750 Hillcrest Plaza Drive, Suite 100
Dallas, Texas 75230
(972) 490-7090
(972) 490-7094 fax
www.winkelmann.com

NO.	DATE	REVISION	APPROV.

STATE OF TEXAS
F. L. MIDDLETON, JR.
87449
REGISTERED
PROFESSIONAL
ENGINEER

W.H. BAIRD SURVEY, ABSTRACT NO. 25
CITY OF ROCKWALL
ROCKWALL COUNTY, TEXAS

CONTINENTAL HOMES
621 WEST COLLEGE STREET
GRAPEVINE, TEXAS 76051

PAVING PLAN & PROFILE
TRAIL GLEN
STA. 0+00 TO 10+05.09

Scale : H. 1"=40' V. 1"=4' | Date : 2/9/00
Designed By : MK
Drawn By : DA
Checked By : FEM | View :
File : 3200IP6.DWG
Project No. : 3200.01

SHEET 7 OF 32

C:\RUSSELL\3200\IP6.dwg Wed Feb 09 09:17:13 2000 RUSSELL