**BENCHMARK:** ELEV. = 583.56
R.R. SPIKE SET IN THE CENTERLINE OF S.H. 276
3600± WEST OF F.M. 549

**BENCHMARK:** ELEV. = 600.69
CITY OF ROCKWALL R-19
BRASS MONUMENT AT THE N/W CORNER OF SILVERVIEW & DIAMOND WAY. 500' ± SOUTH OF S.H. 276.

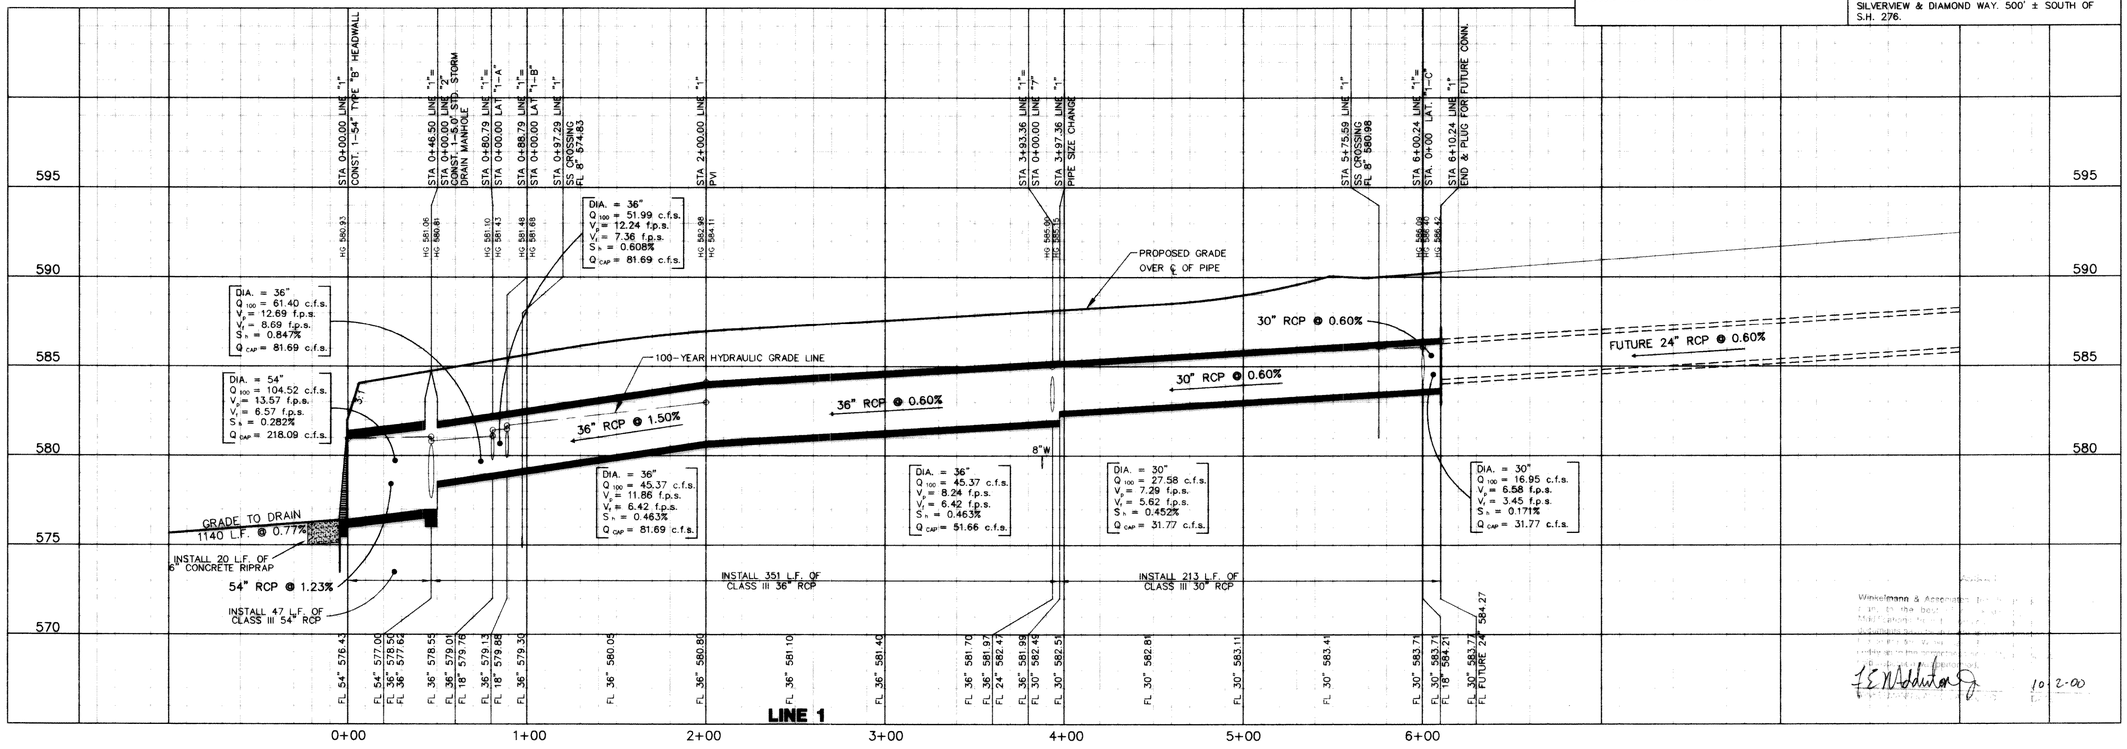


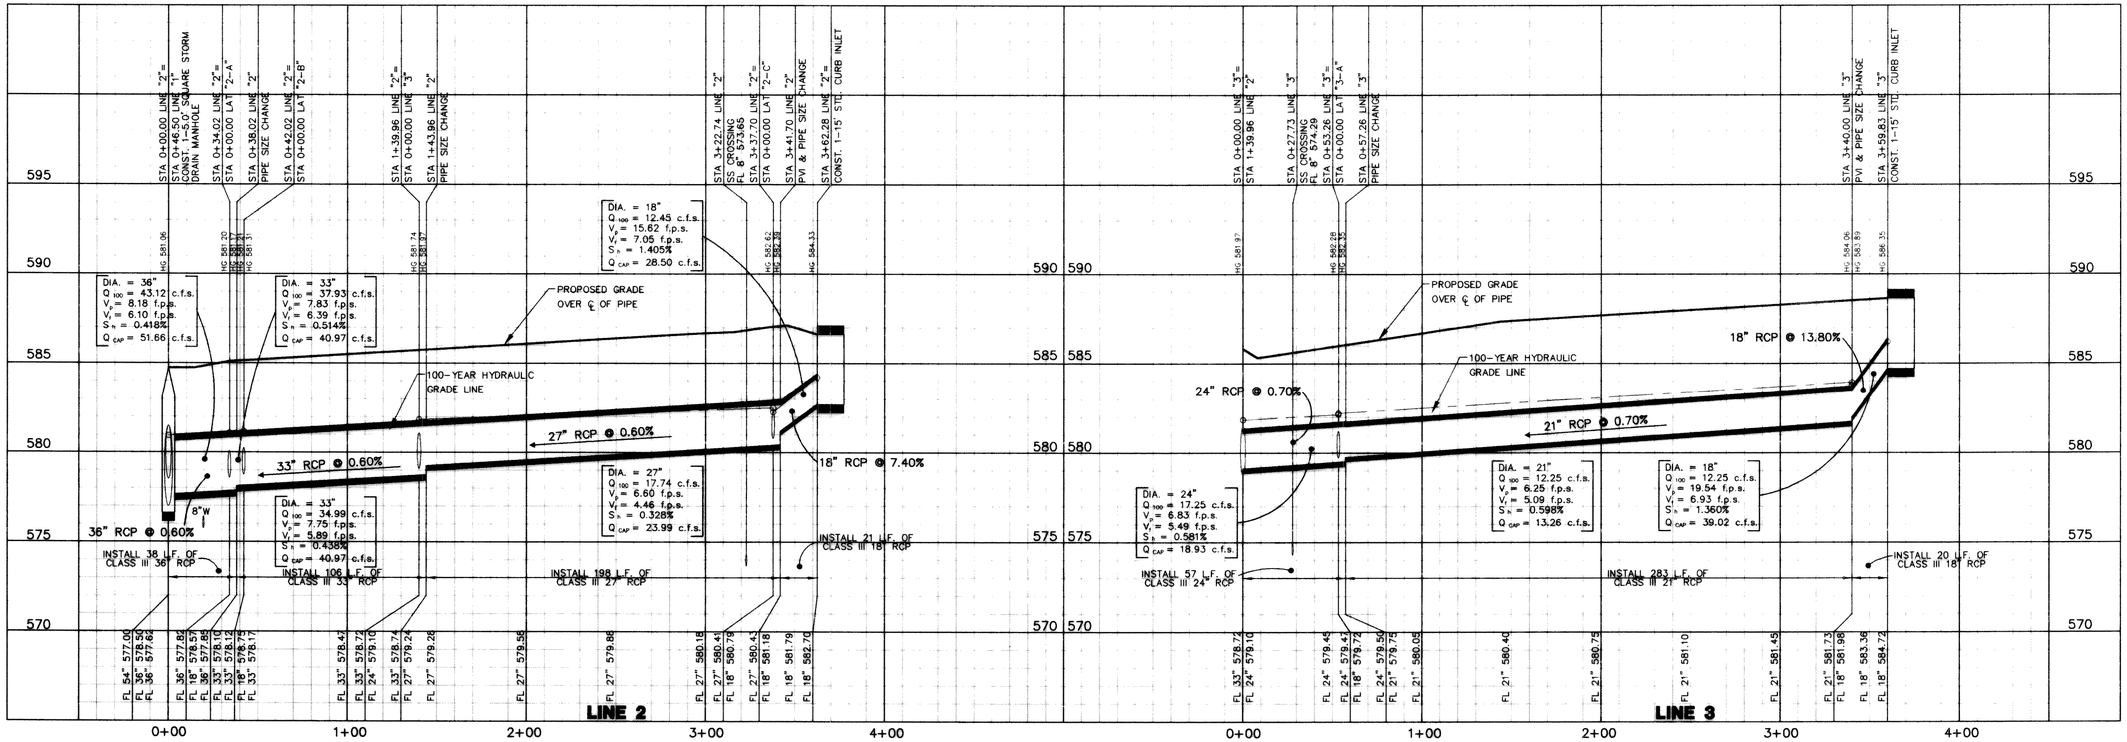


Winkelmann & Associates, Inc.
CONSULTING CIVIL ENGINEERS & SURVEYORS
8750 Whitehurst Drive, Suite 100
Dallas, Texas 75243
(972) 480-7900
(972) 480-7906 FAX
www.winkelmann.com

| NO. | DATE | REVISION | APPROV. |
|---|---|---|---|

STATE OF TEXAS — J. E. MIDDLETON — 67449 — REGISTERED PROFESSIONAL ENGINEER
3-13-00

Winkelmann & Associates, Inc. has prepared these plans in the best interest of the City of Rockwall. Winkelmann & Associates, Inc. does not guarantee the accuracy of any information shown on these plans that was taken from any source other than Winkelmann & Associates, Inc.
J. E. Middleton 10-2-00

W.H. BAIRD SURVEY, ABSTRACT NO. 25
CITY OF ROCKWALL
ROCKWALL COUNTY, TEXAS

CONTINENTAL HOMES
621 WEST COLLEGE STREET
GRAPEVINE, TEXAS 76051

# STORM SEWER PROFILES
## LINE "1", LINE "2 & LINE "3"

| | |
|---|---|
| Scale : H: 1"=40' V: 1"=4' | Date : 3/10/00 |
| Designed By : | NK/DA |
| Drawn By : | DA |
| Checked By : | FEM |
| File : 32001SP1.DWG | View : |
| Project No. : | 32001.01 |

SHEET 16 OF 32

Fri Mar 10 16:02:35 2000