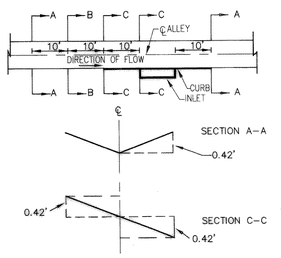

TYPICAL ALLEY WARPING AT INLET

N.T.S.

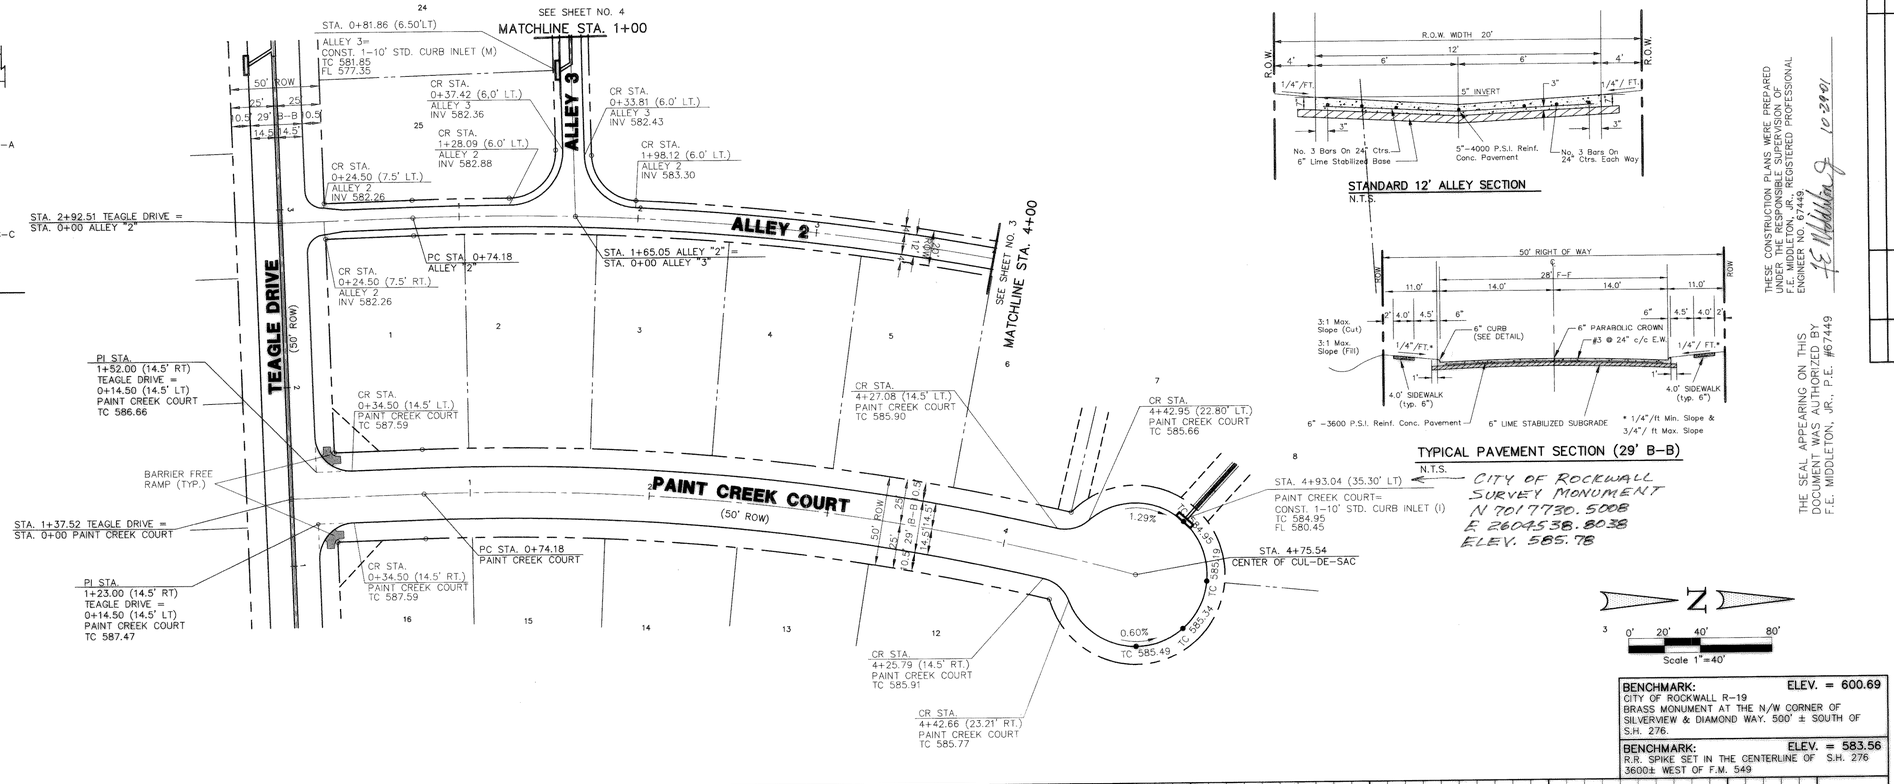

NOTE:

1) PAVEMENT FOR STREETS SHALL CONSIST OF 6" 3600 P.S.I. REINFORCED CONCRETE AND 6" LIME-STABILIZED SUBGRADE WITH 6" PARABOLIC CROWN.

2) PAVEMENT FOR ALLEYS SHALL CONSIST OF 4000 P.S.I. REINFORCED CONCRETE AND 6" LIME-STABILIZED SUBGRADE WITH 5" INVERT. TYPICAL ALLEY SECTION WILL BE 7"-5"-7".

3) CONTRACTOR TO RUN LIME SERIES BEFORE CONSTRUCTION.

STANDARD 12' ALLEY SECTION

N.T.S.

TYPICAL PAVEMENT SECTION (29' B-B)

N.T.S.

BENCHMARK:	ELEV. = 600.69
CITY OF ROCKWALL R-19 BRASS MONUMENT AT THE N/W CORNER OF SILVERVIEW & DIAMOND WAY. 500' ± SOUTH OF S.H. 276.	
BENCHMARK:	**ELEV. = 583.56**
R.R. SPIKE SET IN THE CENTERLINE OF S.H. 276 3600± WEST OF F.M. 549	

THESE CONSTRUCTION PLANS WERE PREPARED UNDER THE RESPONSIBLE SUPERVISION OF F.E. MIDDLETON, JR., REGISTERED PROFESSIONAL ENGINEER NO. 67449

F.E. Middleton Jr. 10-29-01

THE SEAL APPEARING ON THIS DOCUMENT WAS AUTHORIZED BY F.E. MIDDLETON, JR., P.E. #67449

NO.	DATE	REVISION	APPROV.

STATE OF TEXAS — F. E. MIDDLETON, JR. — 67449 — REGISTERED PROFESSIONAL ENGINEER

Winkelmann & Associates, Inc.

CONSULTING CIVIL ENGINEERS ■ SURVEYORS
8750 Hillcrest Plaza Drive, Suite 100
Dallas, Texas 75230
(972) 490-7090
(972) 490-7099 FAX
www.winkelmann.com

LOFLAND FARMS, PHASE 4
W.H. BAIRD SURVEY, ABSTRACT NO. 25
CITY OF ROCKWALL
ROCKWALL COUNTY, TEXAS

CONTINENTAL HOMES
621 WEST COLLEGE STREET
GRAPEVINE, TEXAS 76051

PAVING PLAN & PROFILE - PAINT CREEK COURT STA. 0+00 TO STA. 4+75.54
PAVING PLAN - ALLEY 2 STA. 0+00 TO 4+00
PAVING PLAN - ALLEY 3 STA. 0+00 TO 1+00

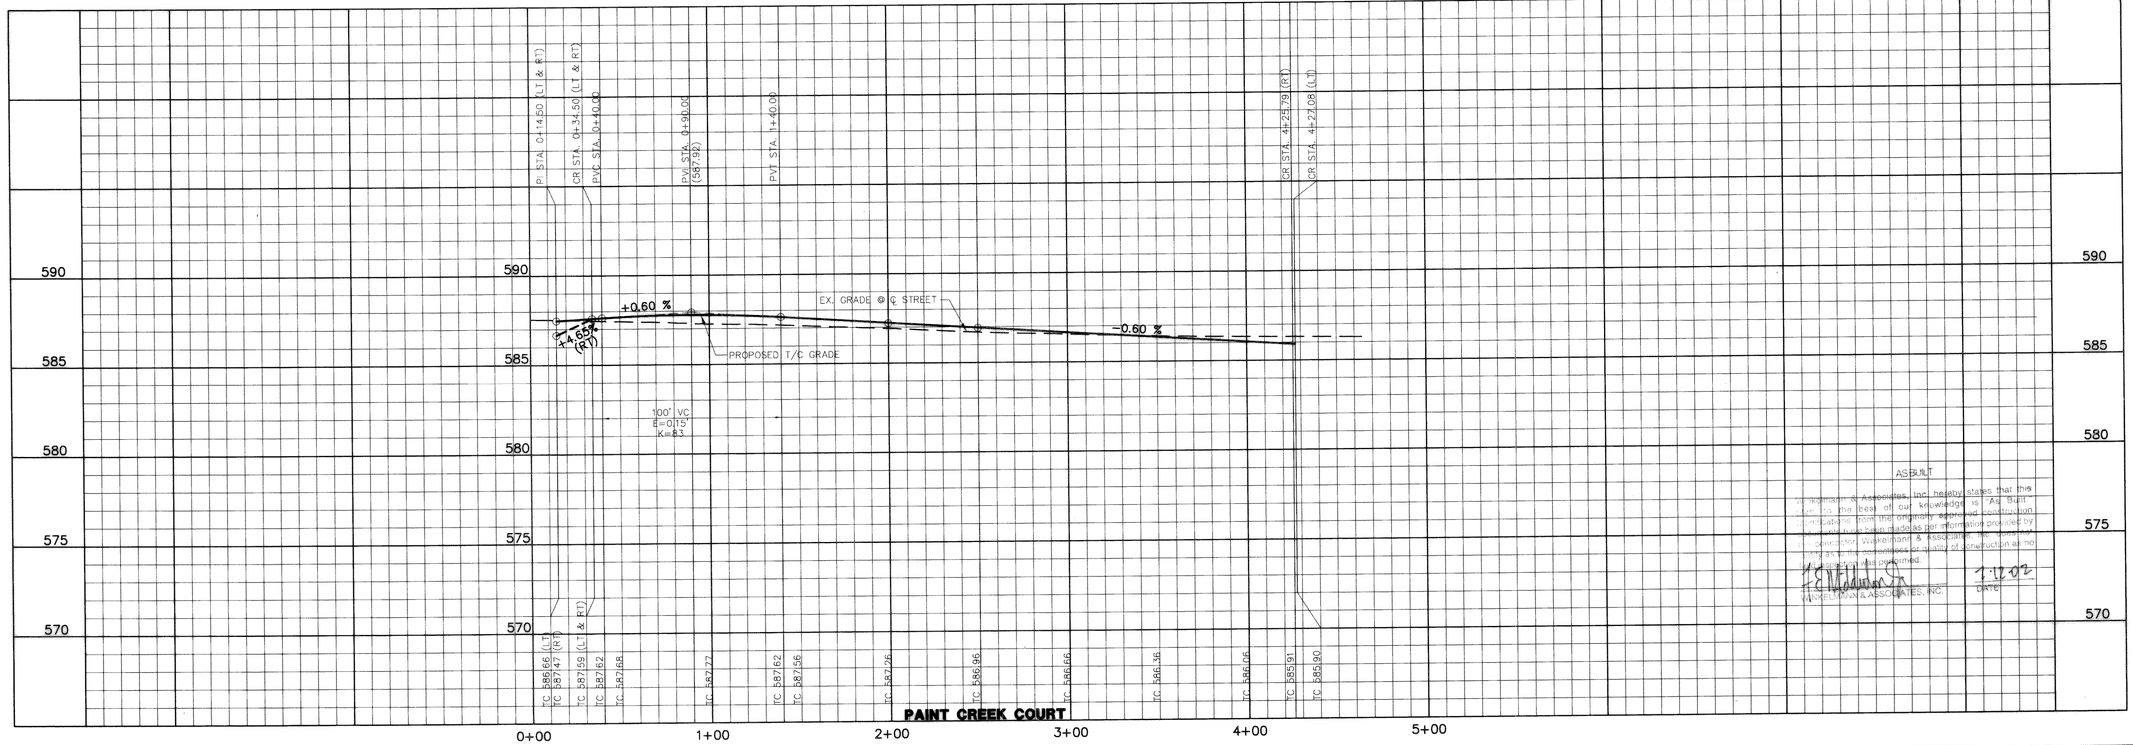

AS-BUILT

Winkelmann & Associates, Inc. hereby states that this plan is, to the best of our knowledge, "As Built" except as noted from the originally approved construction plans. We have relied on the field details per information provided by others. Winkelmann & Associates, Inc. does not warrant the correctness or quality of construction as no inspection was performed.


1-17-02 — DATE

Scale : H: 1"=40' V: 1"=4'	Date : 3-2-01
Designed By :	RB
Drawn By :	MK
Checked By :	FEM
File : 32002#P5.DWG	View :
Project No. :	32002.01

SHEET 7 OF 24

C:\RUSSELL\32002#P5.dwg Mon Oct 29 07:37:11 2001 RUSSELL