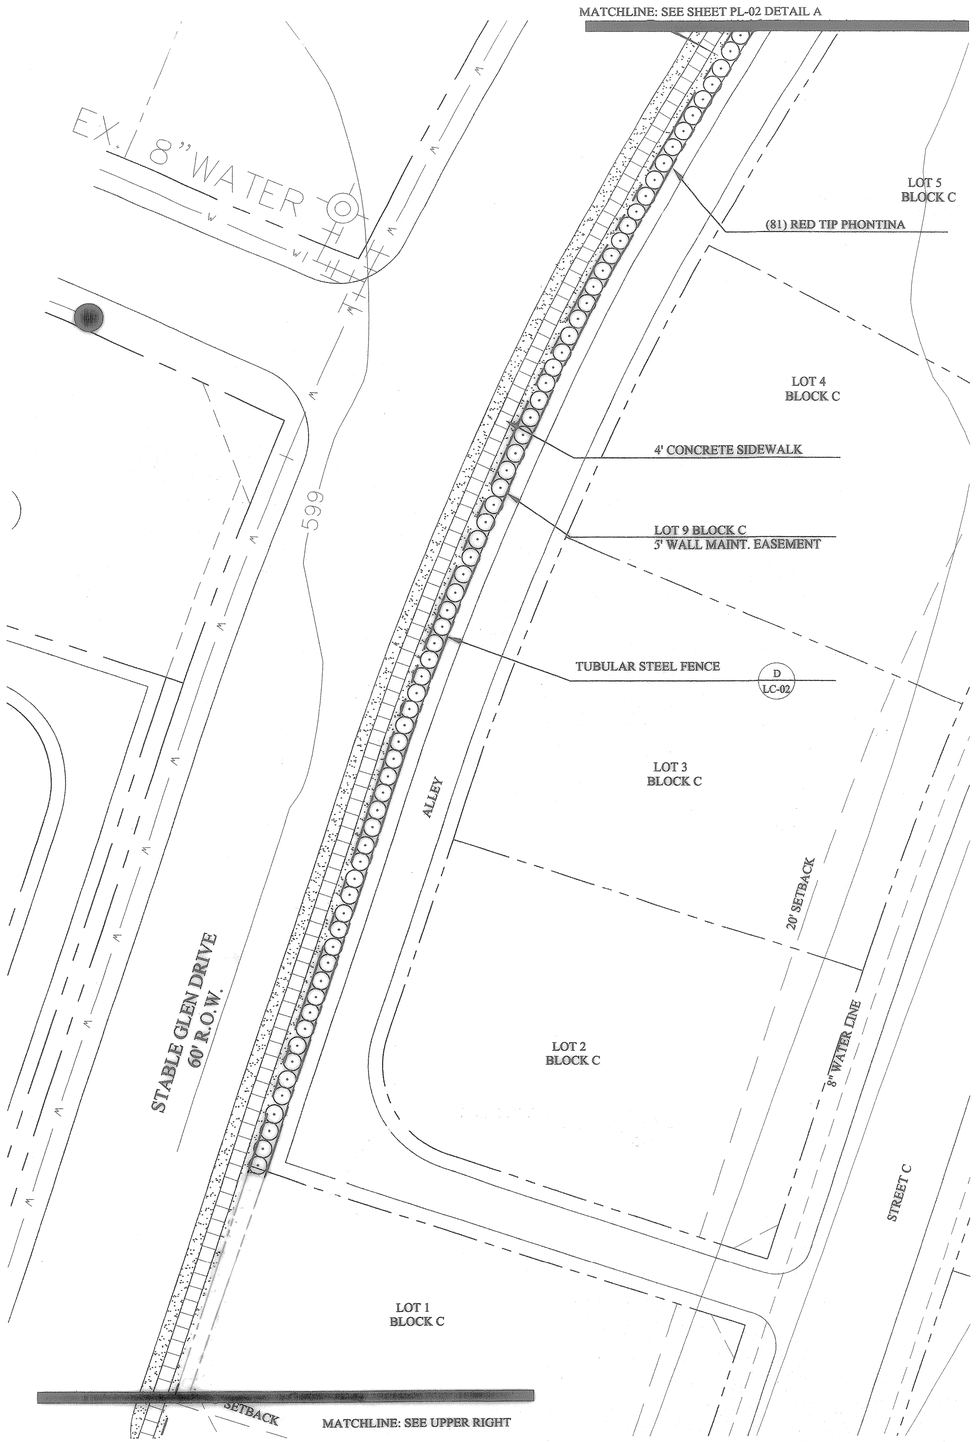

ALL COLUMNS AND FENCES ARE LOCATED IN THE 5' WALL MAINT. EASEMENT

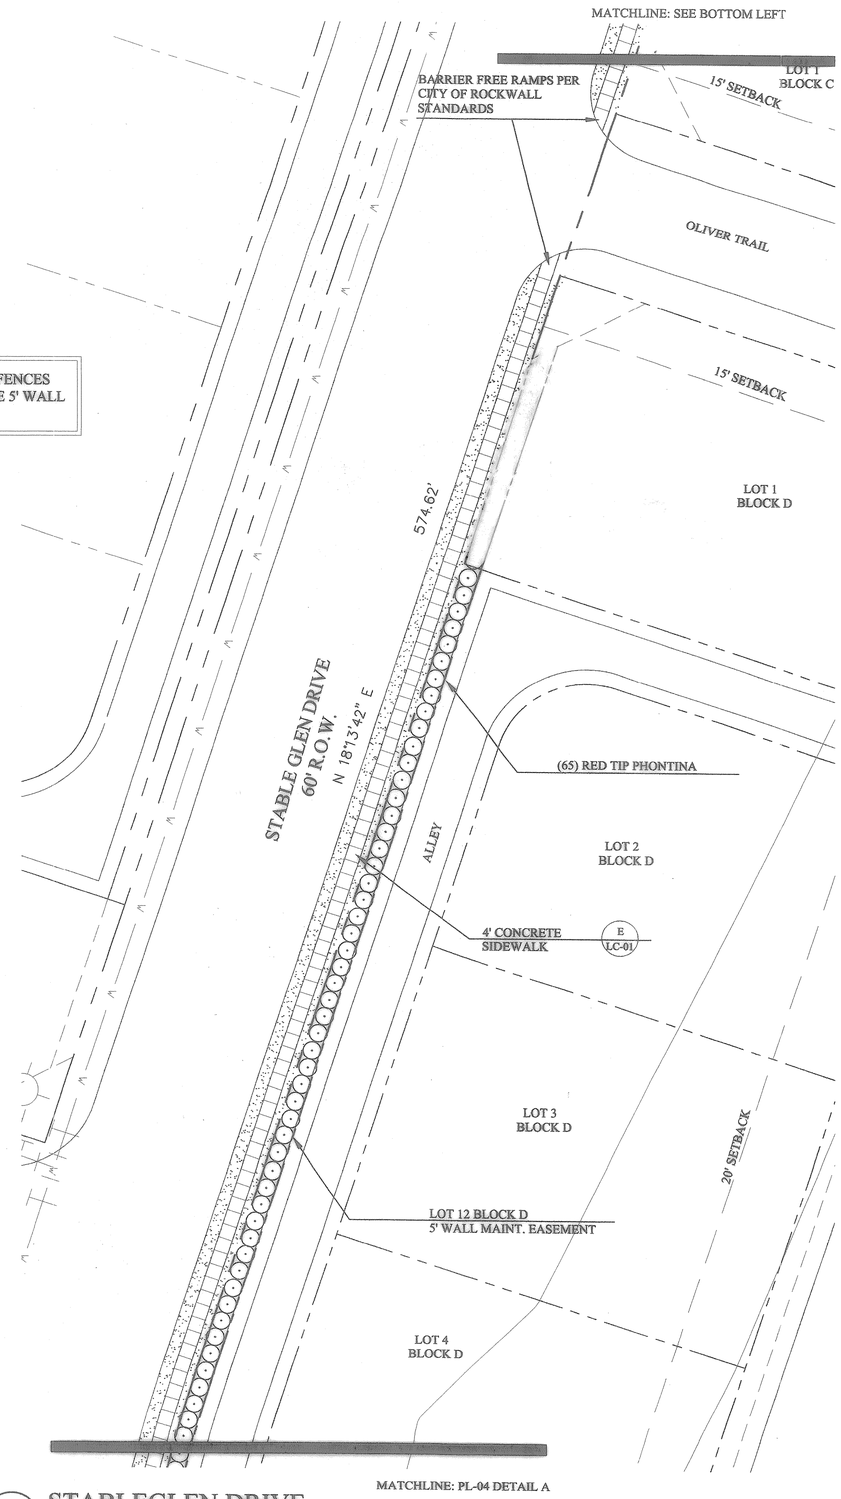

A STABLEGLEN DRIVE
SCALE: 1"=20'-0"

NORTH

B STABLEGLEN DRIVE
SCALE: 1"=20'-0"

NORTH

Ironwood
Design Group

Landscape Architecture
Land Planning

302 Brookside Drive
Grapevine, Texas 76051

Grapevine Office
(Ph.) 817-329-7643
(Fax) 817-488-5833

These Drawings and Specifications are to be an instrument of service and shall remain the property of the Ironwood Design Group. They are not to be used on other projects or extensions to this project except by agreement in writing from the Ironwood Design Group. Ironwood Design Group is not responsible for construction means, methods, sequences or procedures, or for safety precautions and programs in connection with the project.

LOFLAND FARMS
PHASE 5A
ROCKWALL, TEXAS

CONTINENTAL HOMES
621 WEST COLLEGE STREET
GRAPEVINE, TEXAS

Project Number:	
Drawn By:	RGB
Checked By:	B.R.
Issue Date:	06-24-02
Scale:	1"=20'-0"
Revisions	10/15/03

STATE OF TEXAS
LICENSED
LANDSCAPE ARCHITECT

AS-BUILT

PLANTING PLAN

Sheet Number
PL-03