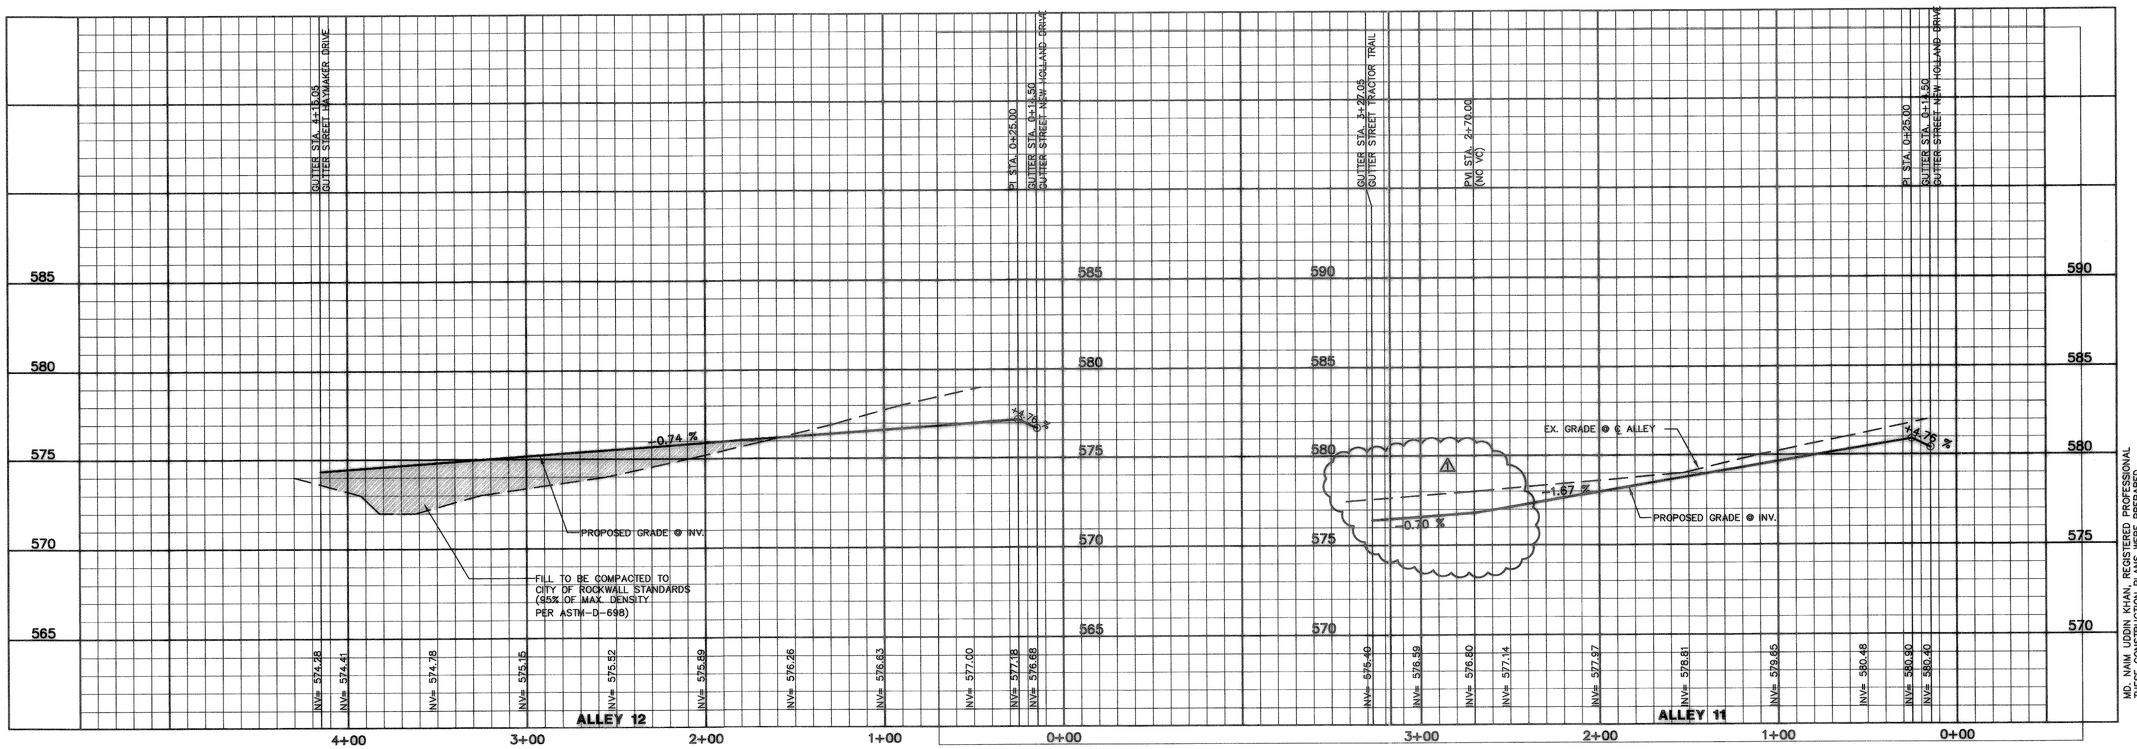

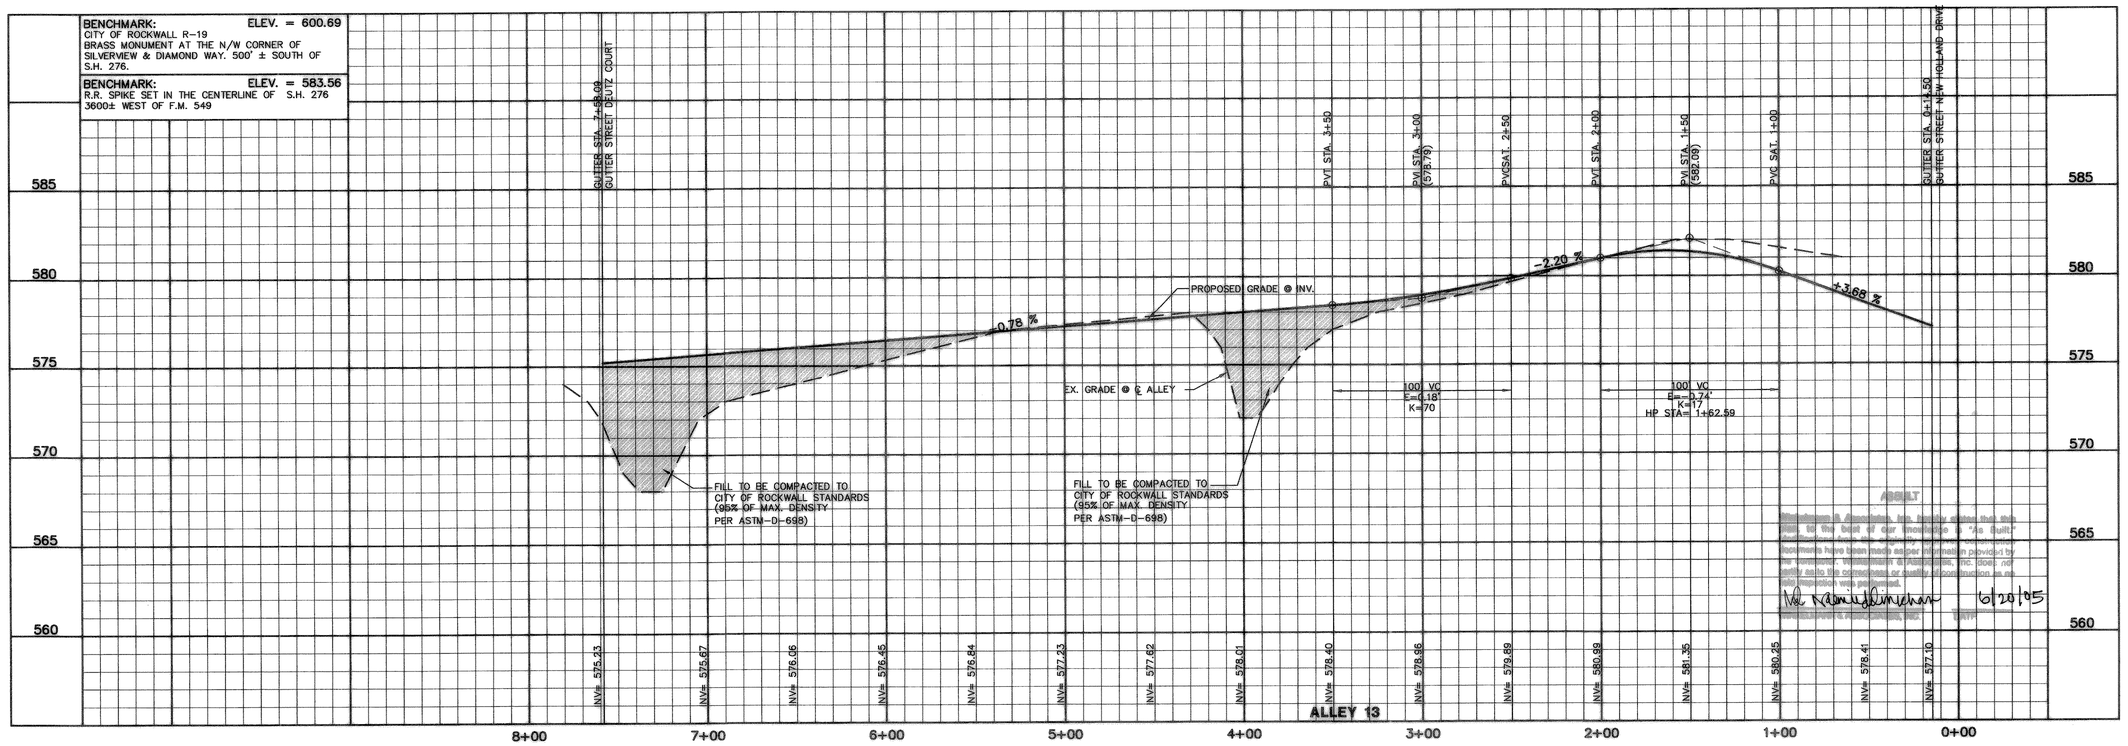

MD. NAIM UDDIN KHAN, REGISTERED PROFESSIONAL ENGINEER, PREPARED THIS SHEET OR HAVE PREPARED UNDER THE RESPONSIBLE SUPERVISION OF
ENGINEER NO. 87776
6/17/05

NO.	DATE	REVISION	APPROV.
1	1-25-05	REVISED ALLEY PROFILE	NK

Winkelmann & Associates, Inc.
CONSULTING CIVIL ENGINEERS ■ SURVEYORS
8750 Willow Pass Pkwy, Suite 100
Dallas, Texas 75243
(972) 490-7090
(972) 490-7094 FAX
www.winkelmann.com

STATE OF TEXAS
MD. NAIM UDDIN KHAN
87776
REGISTERED PROFESSIONAL ENGINEER

LOFLAND FARMS, PHASE 5B
W.H. BAIRD SURVEY, ABSTRACT NO. 25
CITY OF ROWLETT
ROCKWALL COUNTY, TEXAS

D.R. HORTON
4306 MILLER ROAD, SUITE-A
ROWLETT, TEXAS 75088

THE SEAL APPEARING ON THIS DOCUMENT WAS AUTHORIZED BY MD. NAIM UDDIN KHAN, # 87776

ALLEY PAVING PROFILE

ALLEY 11 - STA. 0+00 TO STA. 3+41.55
ALLEY 12 - STA. 0+00 TO STA. 4+29.55
ALLEY 13 - STA. 0+00 TO STA. 7+85.52

AS BUILT
Winkelmann & Associates, Inc. hereby states that the data, to the best of our knowledge is "as built" information and as originally surveyed and constructed. Any changes and/or additions to the original design documents have been made as per information provided by the contractor, subcontractors & suppliers. Inc. does not verify as to the correctness or quality of construction as no inspection was performed.
6/20/05
Winkelmann & Associates, Inc. Date

Scale : Hz. 1"=40' Vt. 1"=4'	Date : 6/30/04
Designed By :	RB
Drawn By :	MK
Checked By :	NK
File : 32004SALD.DWG	View :
Project No. :	32004.01

SHEET
12
OF
28