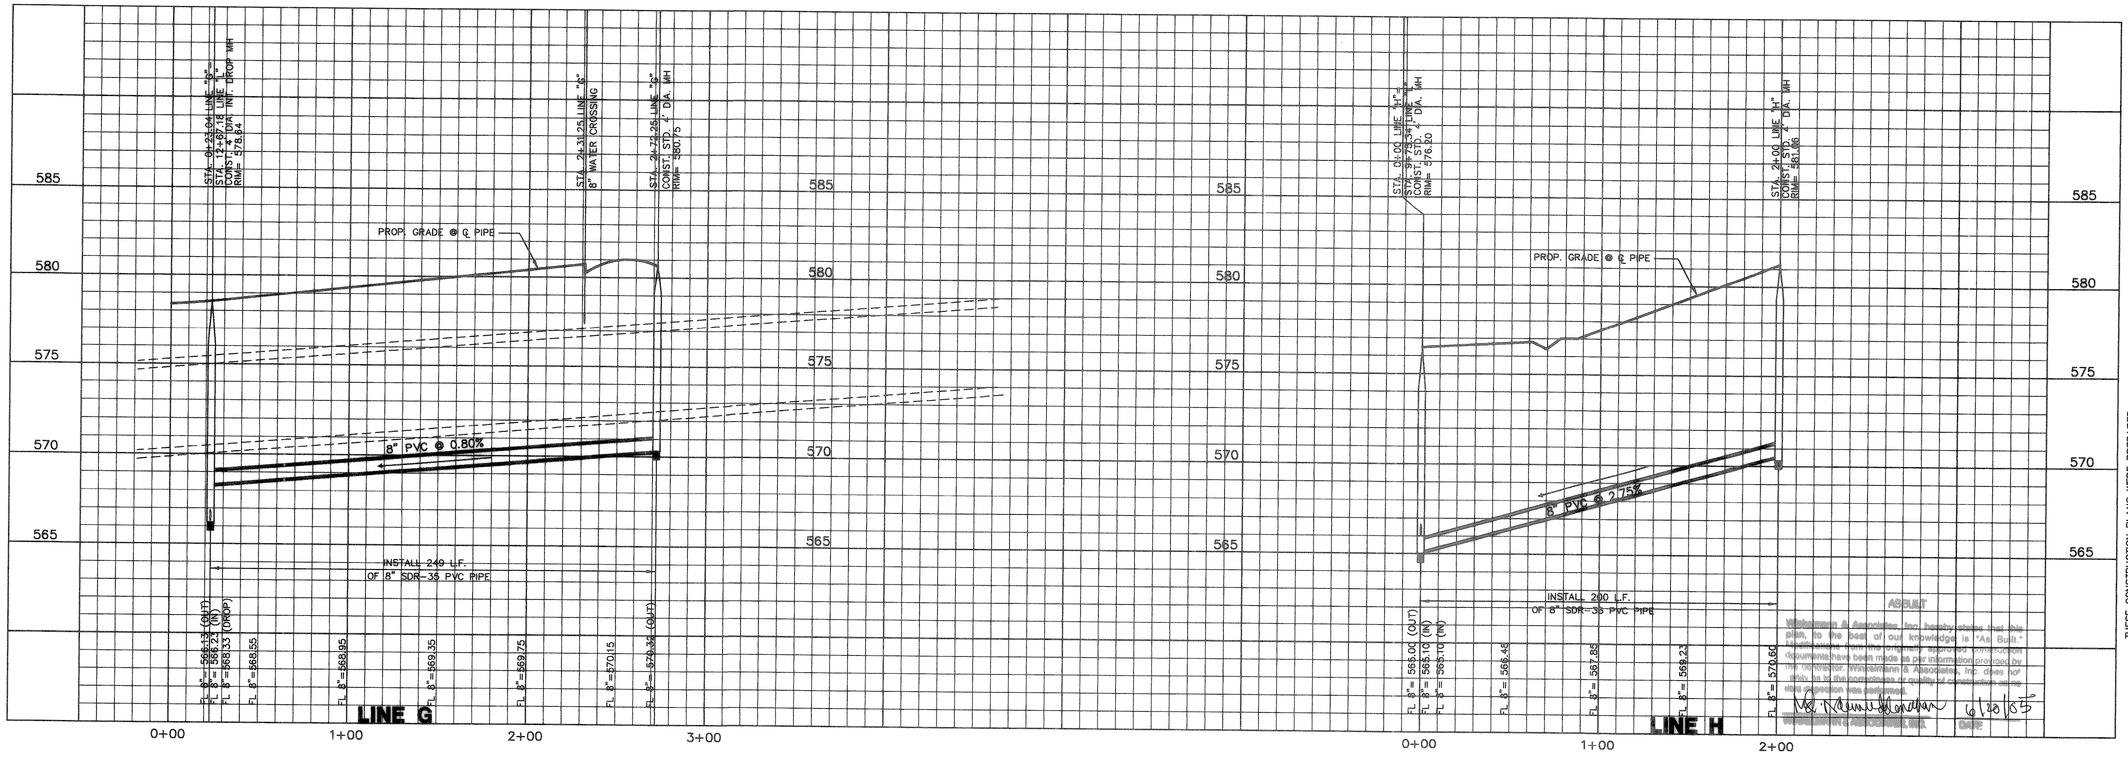

THESE CONSTRUCTION PLANS WERE PREPARED UNDER THE RESPONSIBLE SUPERVISION OF MD. NAIM UDDIN KHAN, REGISTERED PROFESSIONAL ENGINEER NO. 87776

Naim Uddin Khan 7/9/04

THE SEAL APPEARING ON THIS DOCUMENT WAS AUTHORIZED BY MD. NAIM UDDIN KHAN, # 87776

ASBUILT

Winkelmann & Associates, Inc. hereby states that this plan, to the best of our knowledge is "As Built." All variances from the originally approved construction documents have been made as per information provided by the contractor. Winkelmann & Associates, Inc. does not imply, as to the correctness or quality of construction where said operation was performed.

Naim Uddin Khan 6/28/05

NO.	DATE	REVISION	APPROV.

Winkelmann & Associates, Inc.
CONSULTING CIVIL ENGINEERS ■ SURVEYORS
6750 Hillcrest Plaza Drive, Suite 100, Dallas, Texas 75230
(972) 490-7080
(972) 490-7089 FAX
www.winkelmann.com

STATE OF TEXAS — MD. NAIM UDDIN KHAN — 87776 — REGISTERED PROFESSIONAL ENGINEER

LOFLAND FARMS, PHASE 5B
W.H. BAIRD SURVEY, ABSTRACT NO. 25
CITY OF ROCKWALL
ROCKWALL COUNTY, TEXAS

D R HORTON
4306 MILLER ROAD, SUITE A
ROWLETT, TEXAS 75088

SANITARY SEWER PROFILE
LINE F - STA. 0+00 TO STA 5+50
LINE G - STA. 0+23.04 TO STA 2+72.25
LINE H - STA. 0+00 TO STA 2+00
LINE I - STA. 1+03.53 TO STA. 3+15

BENCHMARK:
R.R. SPIKE SET IN THE CENTERLINE OF S.H. 276
3600± WEST OF F.M. 549
ELEV. = 583.56

BENCHMARK:
CITY OF ROCKWALL R-19
BRASS MONUMENT AT THE N/W CORNER OF SILVERVIEW & DIAMOND WAY: 500' ± SOUTH OF SH 276.
ELEV. = 600.69

Scale = H: 1"=40' Date :07/09/04
Designed By : RB
Drawn By : MS
Checked By : NK
File :3200458SSP.dwg View :
Project No. : 32004.01

SHEET 23 OF 28

C:\work\3200\3200458SSP.DWG Fri Jul 09 11:30:06 2004 mustafa