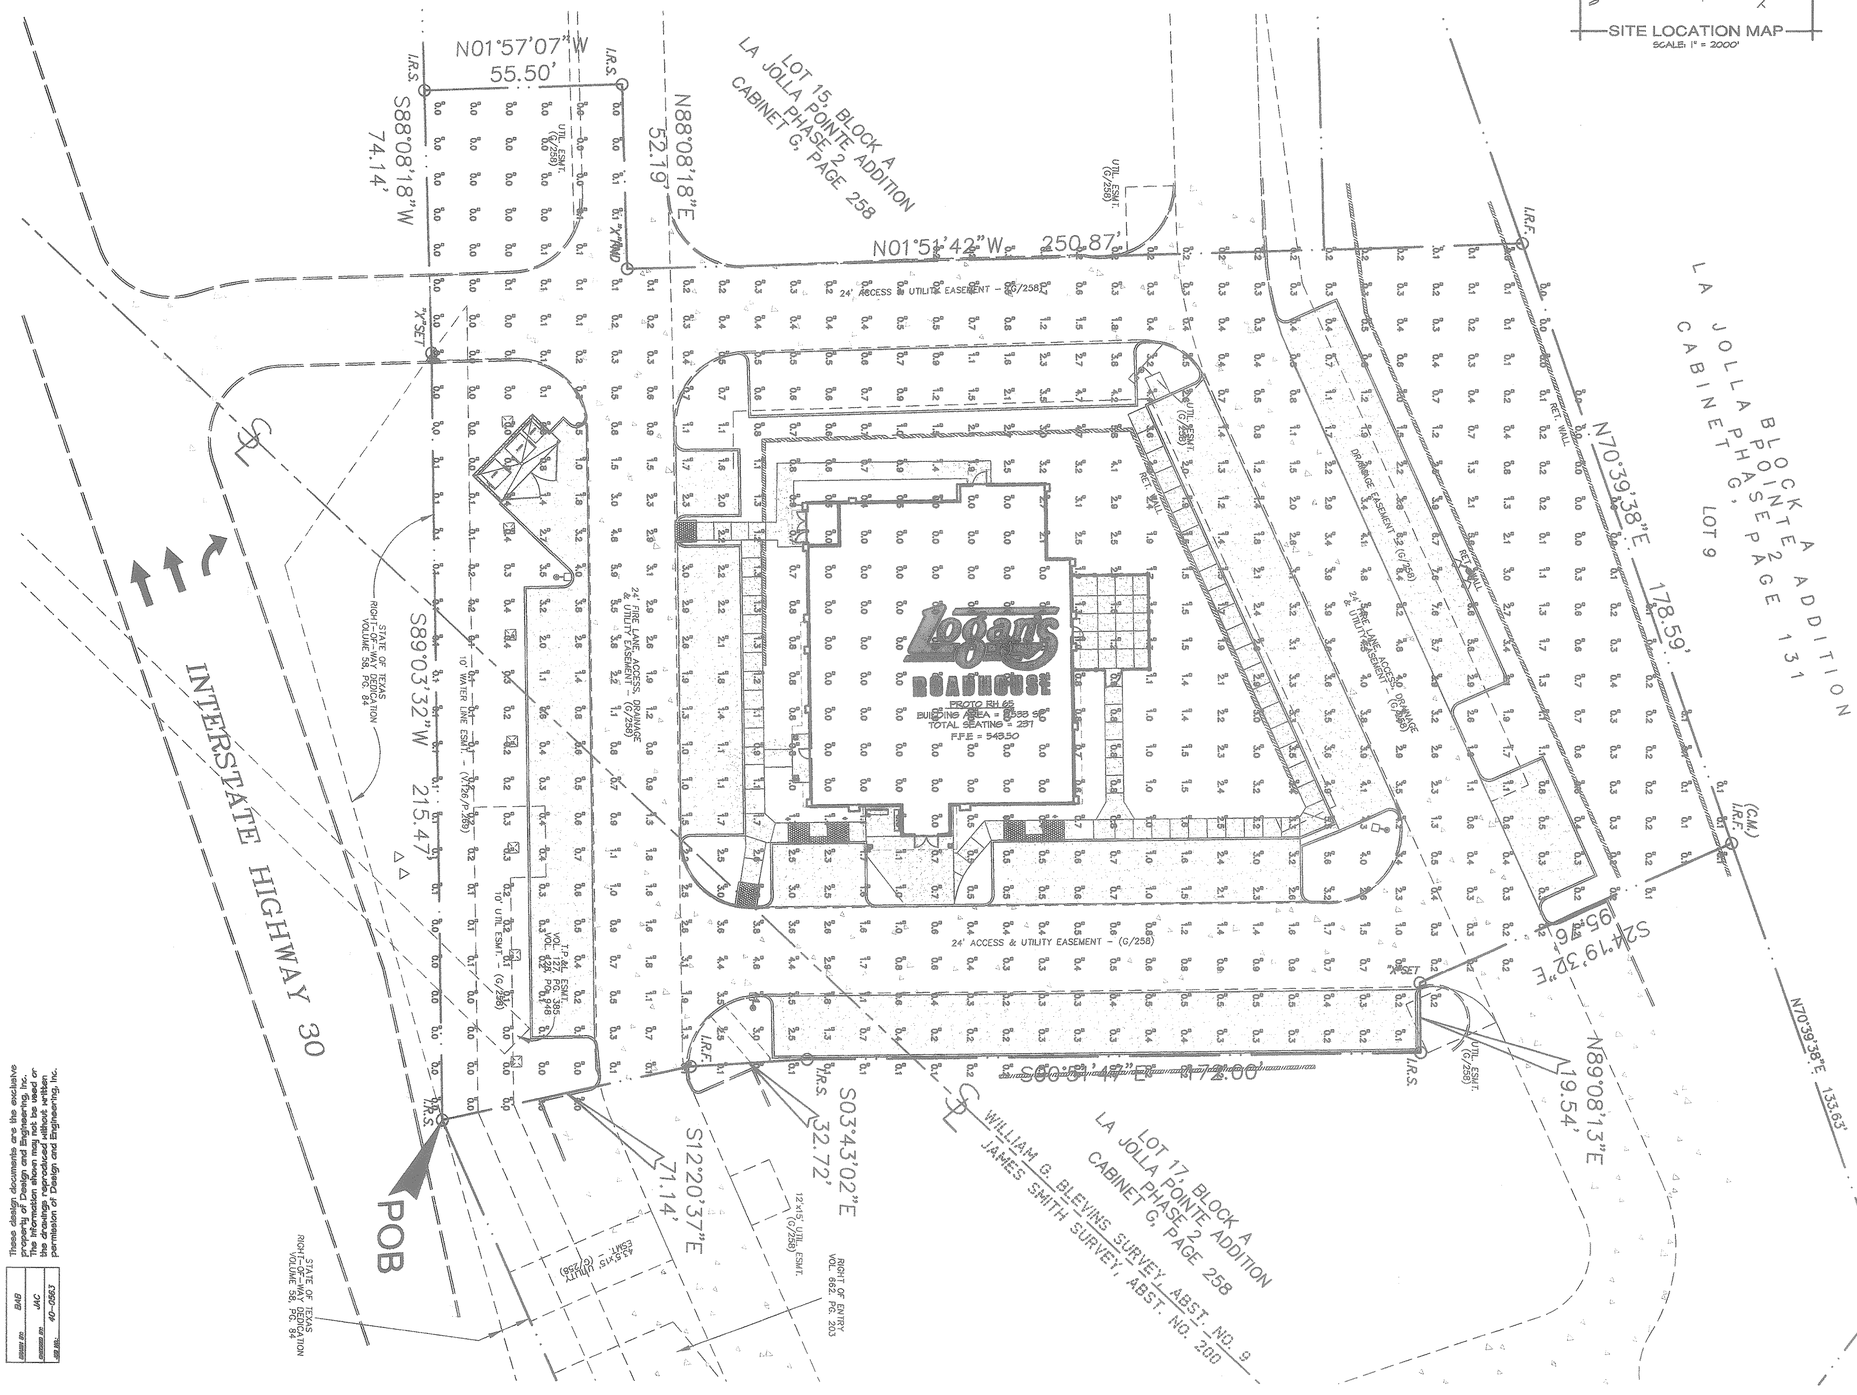

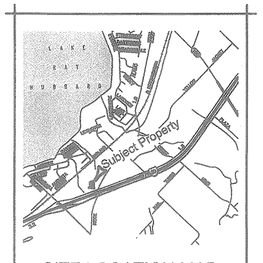

SITE LOCATION MAP
SCALE: 1" = 2000'

MAGNETIC

GRAPHIC SCALE

(IN FEET)
1 inch = 20 ft.

DESIGN and ENGINEERING INC
STRUCTURAL AND CIVIL ENGINEERS
1645 Westgate Circle
Brentwood, Tennessee 37027
615-370-1779 fax: 370-9108
www.dandeinc.us

RECORD DRAWINGS

Logan's ROADHOUSE

3011 Armory Dr., Suite 300
Nashville, Tennessee 37204
Phone: (615) 885-9056

Location:
I-30 FRONTAGE ROAD
ROCKWALL, TEXAS

Job Number:
40-0563H

Revisions:
#1: 07-21-08
#2: 08-25-08
#3: 09-02-08
#4: 09-09-08
#5: 10-13-08 (CITY COMMENTS)
#6 03-05-09 (PER CLIENT)
#7 03-12-09 (PER ABC/FIRE)
#8 03-17-09 (PER CLIENT)
#9 07-10-09 (RECORD DWGS)

TO THE BEST OF OUR KNOWLEDGE, DESIGN AND ENGINEERING, INC. HEREBY STATES THAT THIS PLAN DEPICTS AS-BUILT CONSTRUCTION. THE INFORMATION PROVIDED IS BASED ON FIELD SURVEYING AT THE SITE ON JUNE 10, 2009.

C-7

Photometric Plan
July 10, 2008
PROTO RH65

These design documents are the exclusive property of Design and Engineering, Inc. The information shown may not be used or the drawings reproduced without written permission of Design and Engineering, Inc.

DRAWN BY: BAB
CHECKED BY: JAC
JOB NO.: 40-0563