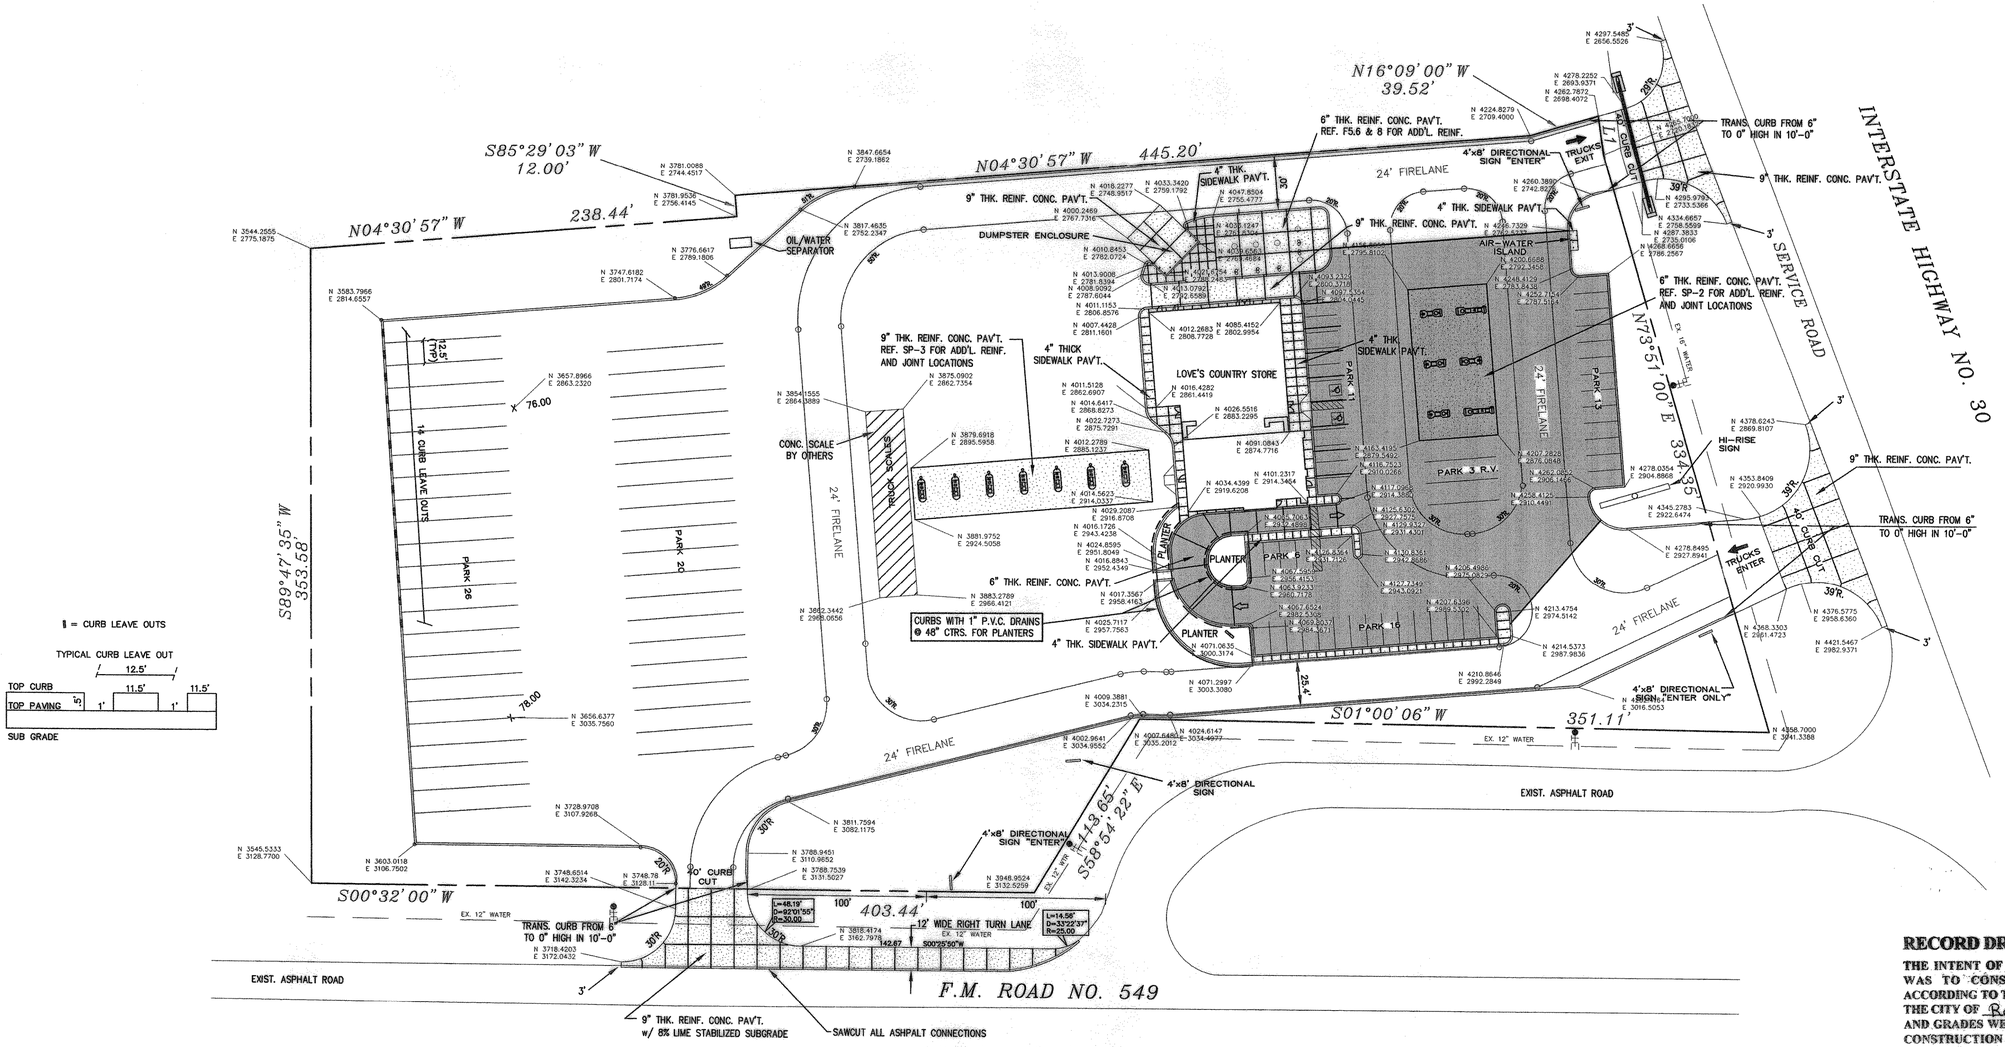

■ = CURB LEAVE OUTS

TYPICAL CURB LEAVE OUT

LEGEND

- EXPANSION JOINT
- TIED TONGUE & GROOVE JOINT
- SAW CUT
- ✱SIDEWALK SAWED CONTRACTION JOINTS
- AREA OF 9" P.C. REINFORCED CONC. PAV'T.
- AREA OF 6" 3500 PSI REINFORCED CONC. PAV'T.
- AREA OF P.C. CONC. PAVING OR SIDEWALK

✱SIDEWALK CONTRACTION JOINTS TO BE TOOLED JOINTS WITH EVERY THIRD JOINT TO BE SAWED AS SHOWN ON DETAIL SHT. C-3.

NOTE
SEE SHT. C-3 FOR PAVING & JOINT DETAILS.

The following areas are to be sealed with specified concrete sealer:
Seal 30 days after concrete pour.
- Sidewalks around building
- Front Parking Spaces
- Car Canopy Pad
- 10' each side of Drive-Thru Window x Drive Lane width.
- Truck Canopy Pad.

GRAPHIC SCALE

40 0 20 40 80 160

(IN FEET)
1 inch = 40 ft.

RECORD DRAWINGS:

THE INTENT OF THE OWNER AND ENGINEER WAS TO CONSTRUCT THESE FACILITIES ACCORDING TO THESE PLANS AS APPROVED BY THE CITY OF Rockwall. THE LINES AND GRADES WERE SET ON THE GROUND FOR CONSTRUCTION ACCORDING TO SAID PLANS. THE CITY OF Rockwall INSPECTED THE CONSTRUCTION. THE OWNER NOR ENGINEER DID NOT VERIFY LINES OR GRADES AFTER CONSTRUCTION. WE ARE NOT AWARE OF ANY CHANGES OR REVISIONS TO THESE PLANS DURING CONSTRUCTION EXCEPT AS NOTED

REVISED FOR CONSTRUCTION
CHANGED DETENTION POND & PARKING LAYOUT.
AUG. 30, 2000

THE SEAL APPEARING ON THIS DOCUMENT WAS AUTHORIZED BY W.L. DOUPHRATE II TEXAS P.E. NO. 60102 ON 8/31/00

DOUPHRATE & ASSOCIATES, INC.
ENGINEERING • PROJECT MANAGEMENT • SURVEYING
2235 RIDGE RD., # 200 ROCKWALL, TEXAS 75087
PHONE: (972)771-9004 FAX: (972)771-9005

PAVING PLAN & DIMENSIONAL CONTROL 1
LOVE'S ADDITION NO. 1
CITY OF ROCKWALL
ROCKWALL COUNTY, TEXAS

1. REVISED AS PER CITY OF ROCKWALL REVISIONS. 7/14/00
2. REVISED AS PER CITY & ARCHITECT REVISIONS. 8/15/00
3. REVISED AS PER ARCHITECT COMMENTS. 8/23/00

REVISION

W.L.D.
CHECKED

K.E.B.
DRAWN

3/10/00
DATE

0007PAV1
PROJECT

6
OF
9