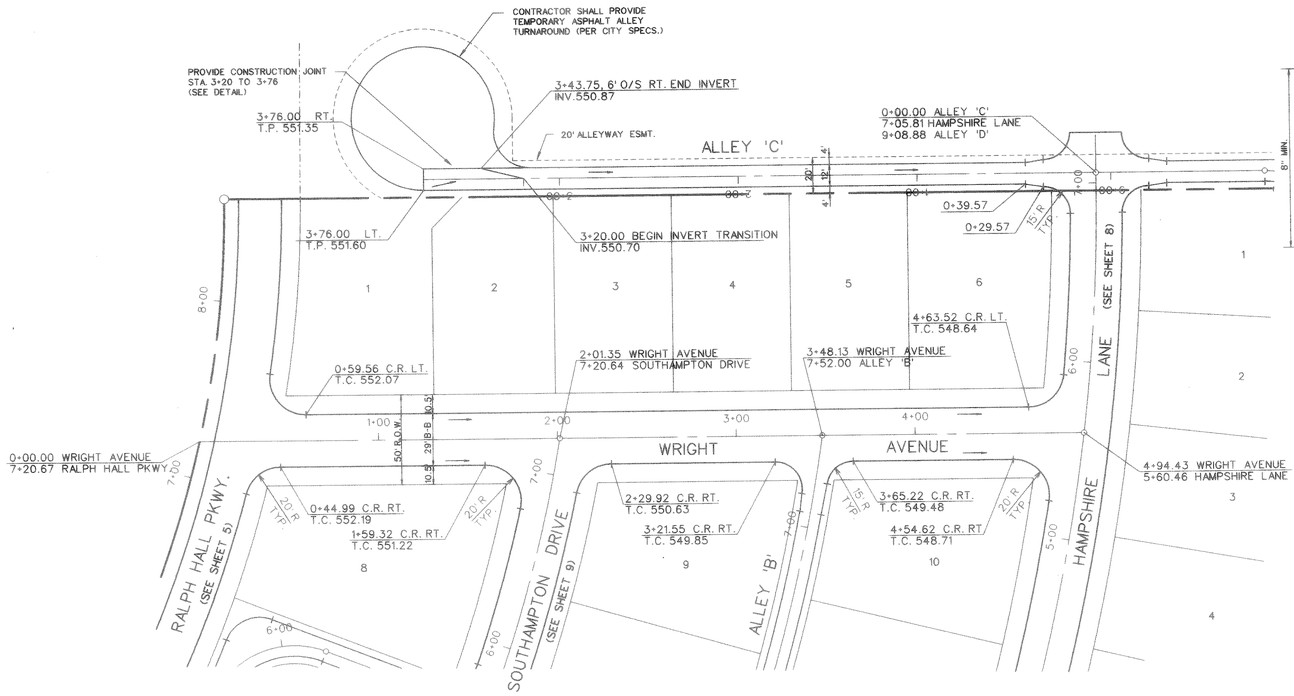

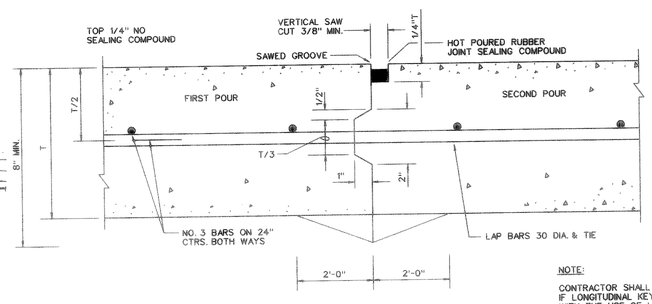

CONSTRUCTION JOINT FOR PAVEMENTS

TRANSVERSE AND LONGITUDINAL JOINTS

N.T.S.

NOTE:

CONTRACTOR SHALL PROTECT KEYWAY PRIOR TO SECOND POUR. IF LONGITUDINAL KEYWAY IS DAMAGED, CONTRACTOR SHALL REPAIR WITH THE USE OF LONGITUDINAL BUTT JOINT. DRILL DOWELS IN TO FIRST POUR.

T = PAVEMENT THICKNESS
THICKENED EDGES ARE REQUIRED FOR FUTURE WIDENING ONLY.

0 20 40 80

SCALE: 1" = 40'

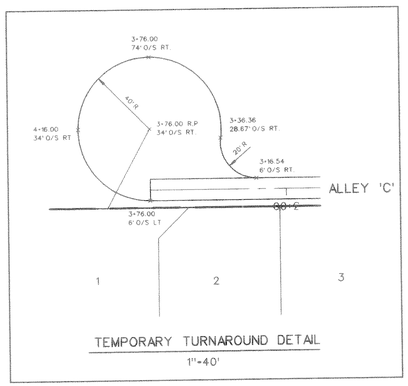

TEMPORARY TURNAROUND DETAIL

1"=40'

BENCHMARK:

"□" cut on top of curb, center of inlet on the Northwest side of Rockwall Pkwy. approx. 140' Northeast of Woodcreek Dr.

ELEVATION = 527.25

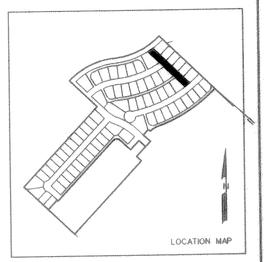

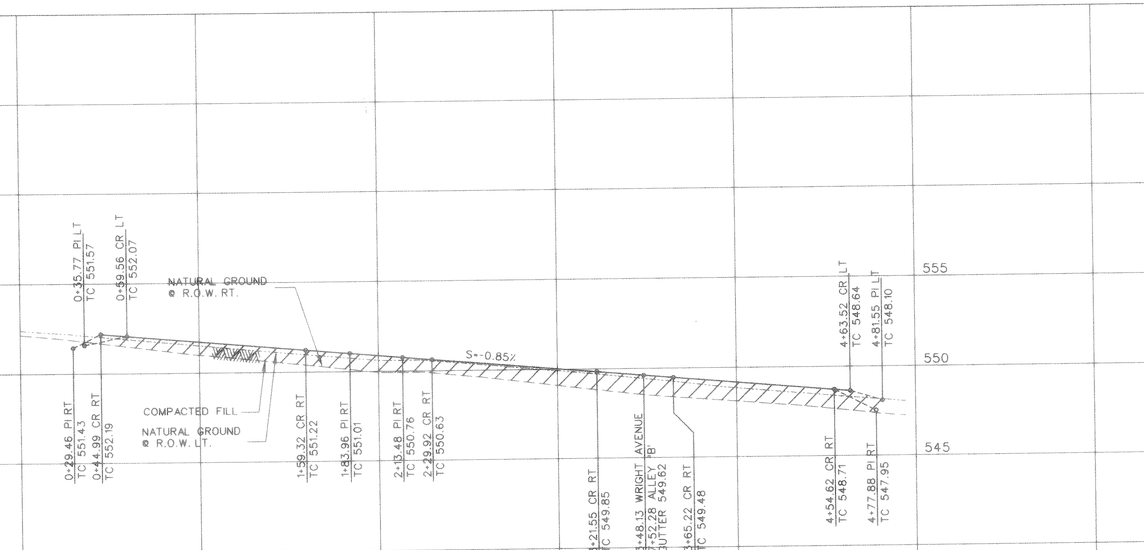

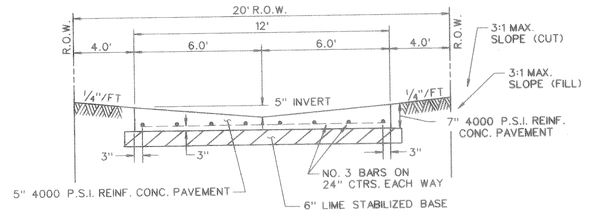

STANDARD 12' ALLEY SECTION

N.T.S.

NO.	REVISIONS	BY	DATE

CORWIN ENGINEERING, INC.
8131 LBJ FREEWAY, SUITE 333
DALLAS, TEXAS 75251 (972) 480-0305

DEVELOPMENT PLANS FOR
LYNDEN PARK ESTATES PHASE IA
ROCKWALL, TEXAS

WRIGHT AVENUE
ALLEY 'C'

STATE OF TEXAS
WARREN L. CORWIN
57875
REGISTERED
PROFESSIONAL ENGINEER
4-28-97

The seal appearing on this document was authorized by Warren L. Corwin, P.E. 57875, on APRIL 28, 1997

AS-BUILT JULY 1999
INFORMATION PROVIDED BY CONTRACTORS (NOT FIELD VERIFIED)

DRAWN BY	DESIGNED BY	CHECKED BY	SHEET NO.
CEI	CEI	CEI	7 OF 24
JOB NUMBER	DATE	SCALE: 1"=4' V, 1"=40' H	
9702	JANUARY 1997		

PF:
FILE: 9702WRIG.DGN
REF FILE: 9702AL.DGN
VIEW:
DATE: