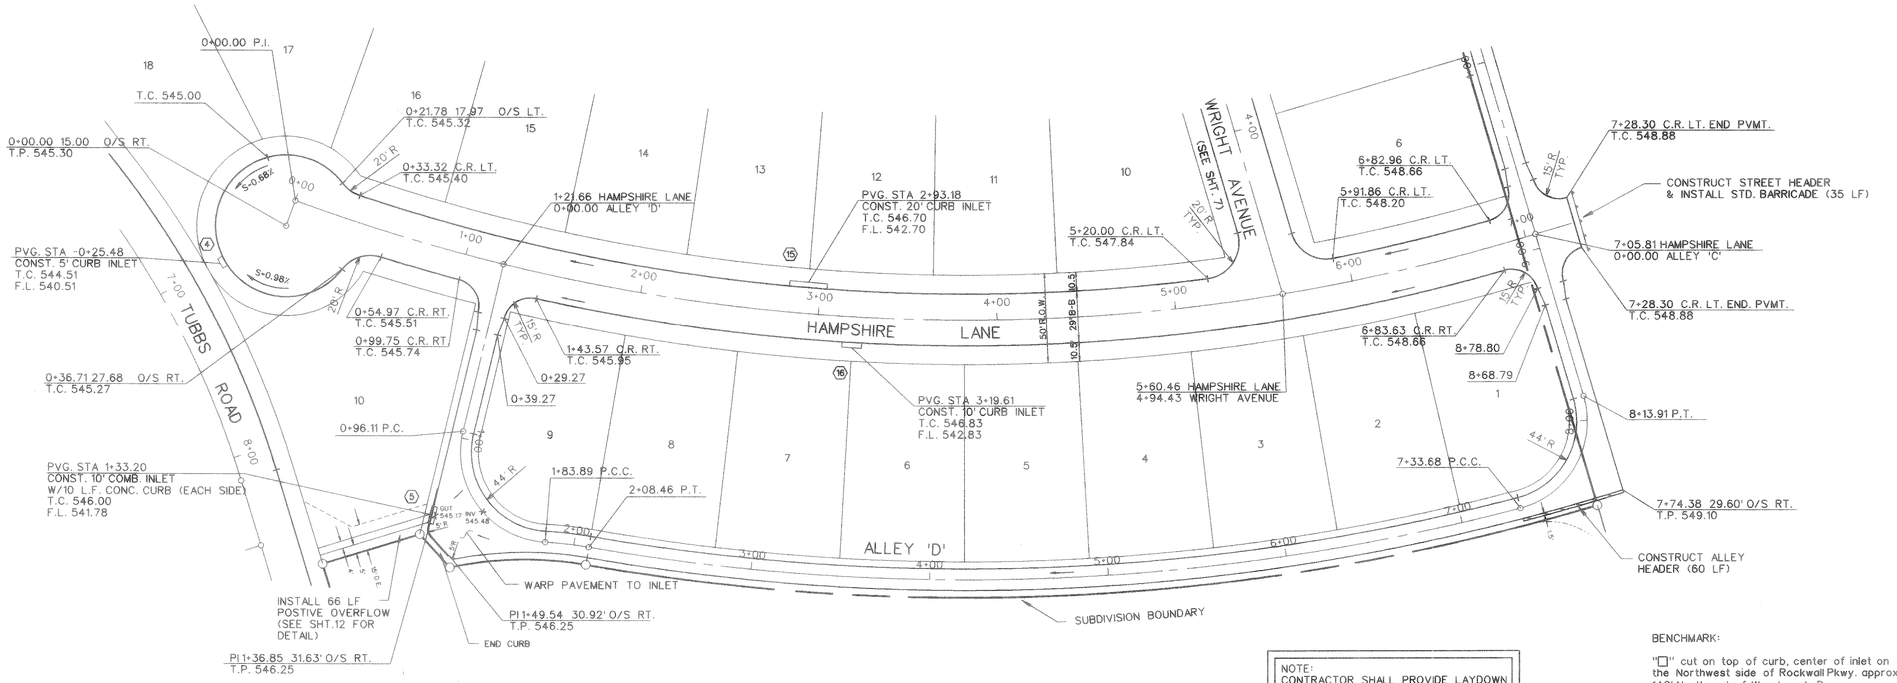

NOTE:
CONTRACTOR SHALL PROVIDE LAYDOWN CURBS AT ALL STREET INTERSECTIONS

BENCHMARK:

"□" cut on top of curb, center of inlet on the Northwest side of Rockwall Pkwy. approx. 140' Northeast of Woodcreek Dr.

ELEVATION = 527.25

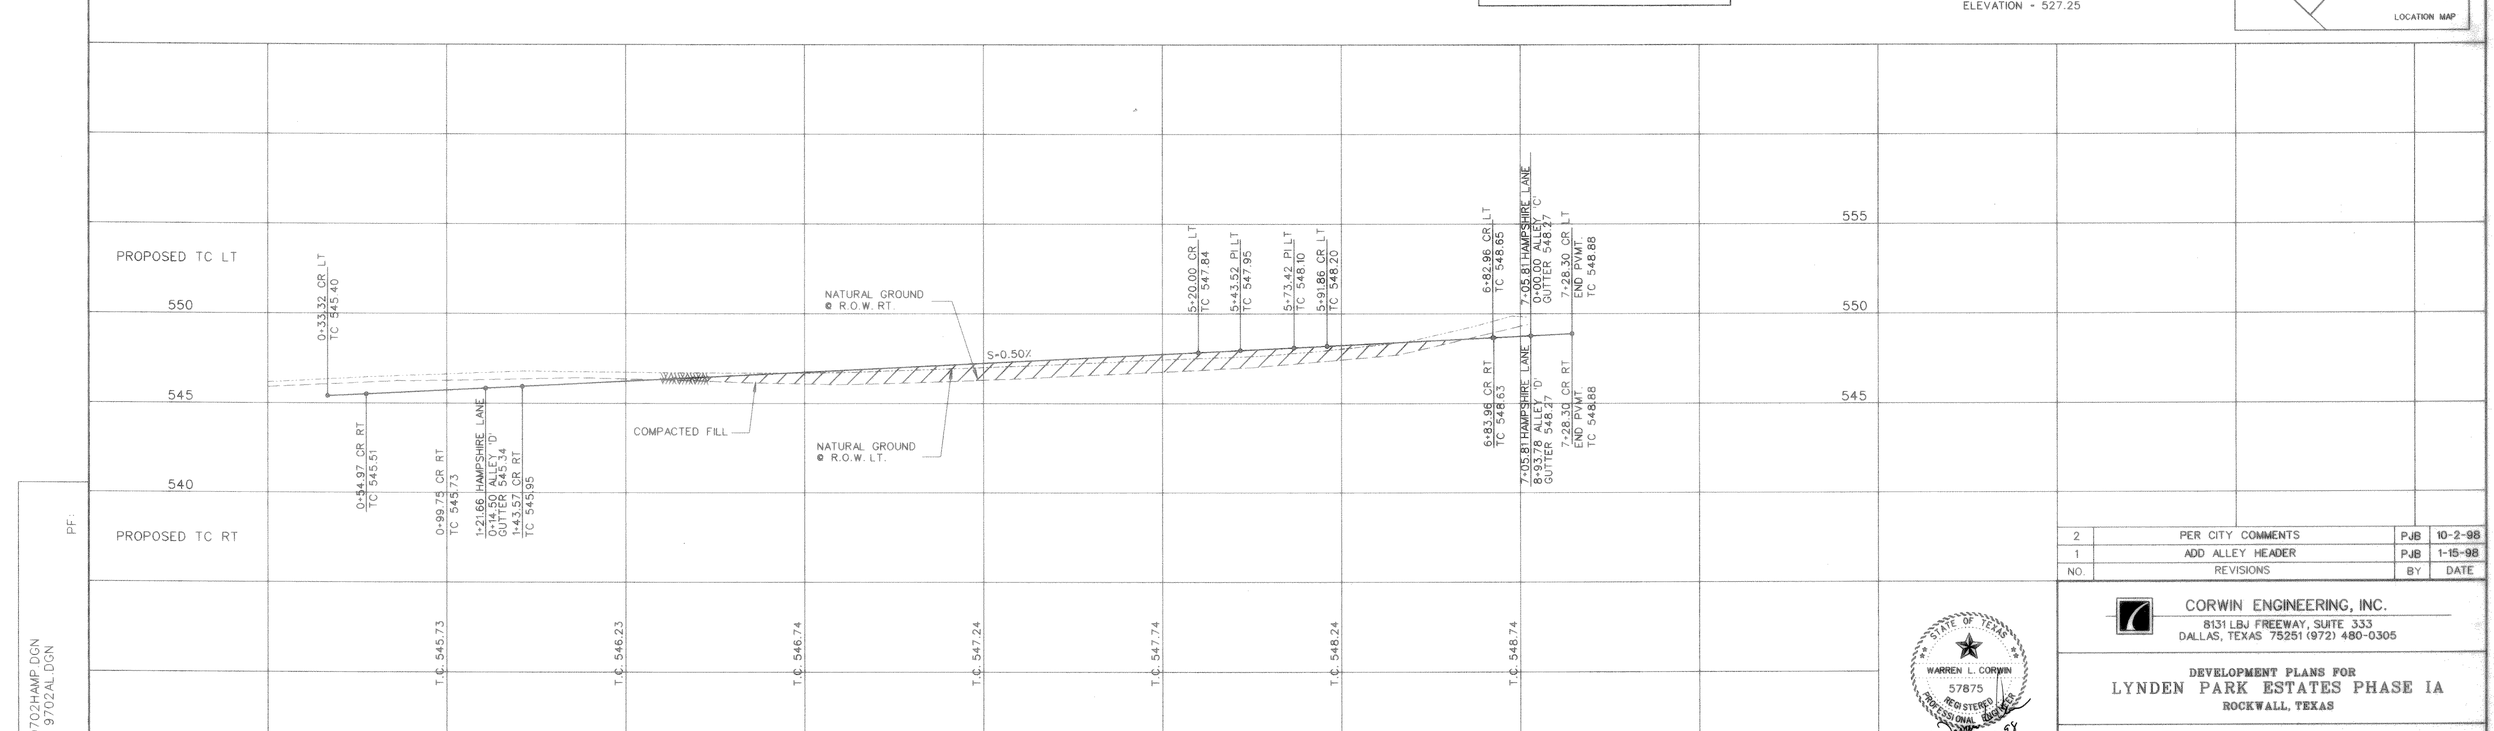

AS-BUILT JULY 1999
INFORMATION PROVIDED BY CONTRACTORS
(NOT FIELD VERIFIED)

STATE OF TEXAS
WARREN L. CORWIN
57875
REGISTERED
PROFESSIONAL ENGINEER
10-2-98

The seal appearing on this document was authorized by Warren L. Corwin, P.E. 57875, on October 2, 1998

NO.	REVISIONS	BY	DATE
2	PER CITY COMMENTS	PJB	10-2-98
1	ADD ALLEY HEADER	PJB	1-15-98

CORWIN ENGINEERING, INC.
8131 LBJ FREEWAY, SUITE 333
DALLAS, TEXAS 75251 (972) 480-0305

DEVELOPMENT PLANS FOR
LYNDEN PARK ESTATES PHASE IA
ROCKWALL, TEXAS

HAMPSHIRE LANE
ALLEY 'D'

DRAWN BY	DESIGNED BY	CHECKED BY	SHEET NO.
CEI	CEI	CEI	8 OF 24
JOB NUMBER	DATE	SCALE: 1"=4' V, 1"=40' H	
9702	JANUARY 1997		

PF:
FILE: 9702HAMP.DGN
REF FILE: 9702AL.DGN
VIEW:
DATE: