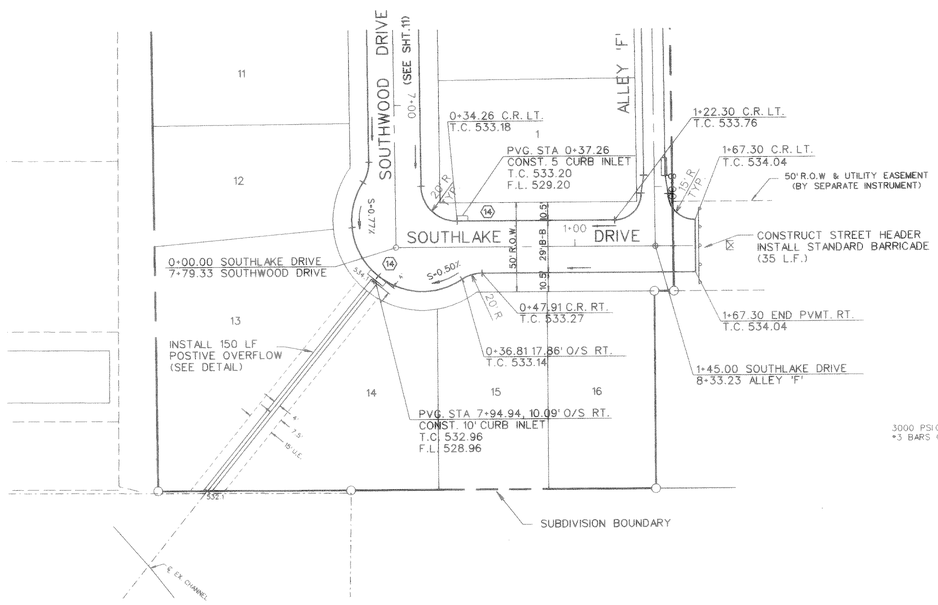

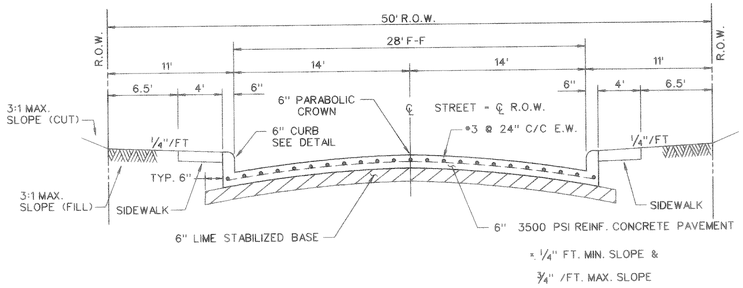

LOCAL RESIDENTIAL

N.T.S.

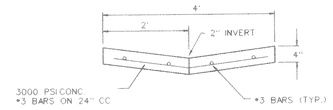

POSITIVE OVERFLOW DETAIL

N.T.S.

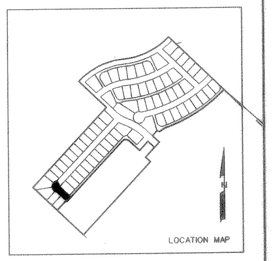

BENCHMARK:

"□" cut on top of curb, center of inlet on the Northwest side of Rockwall Pkwy. approx. 140' Northeast of Woodcreek Dr.

ELEVATION = 527.25

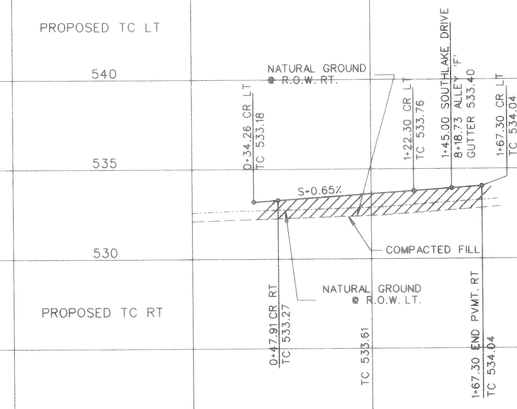

AS-BUILT JULY 1999

INFORMATION PROVIDED BY CONTRACTORS (NOT FIELD VERIFIED)

STATE OF TEXAS
WARREN L. CORWIN
57875
REGISTERED PROFESSIONAL ENGINEER
1-15-98

The seal appearing on this document was authorized by Warren L. Corwin, P.E. 57875, on January 15, 1998

NO.	REVISIONS	BY	DATE
1	CHANGE INLET LOCATION	PJB	6-23-97

CORWIN ENGINEERING, INC.
8131 LBJ FREEWAY, SUITE 333
DALLAS, TEXAS 75251 (972) 480-0305

DEVELOPMENT PLANS FOR
LYNDEN PARK ESTATES PHASE IA
ROCKWALL, TEXAS

SOUTHLAKE DRIVE

DRAWN BY	DESIGNED BY	CHECKED BY	SHEET NO.
CEI	CEI	CEI	12 OF 24
JOB NUMBER	DATE	SCALE: 1"=4' V, 1"=40' H	
9702	JANUARY 1997		

PF:
FILE: 9702LAKE.DGN
REF FILE: 9702AL.DGN
VIEW:
DATE: