MANSIONS SENIOR, RKMCE PROJECT # 1026-005

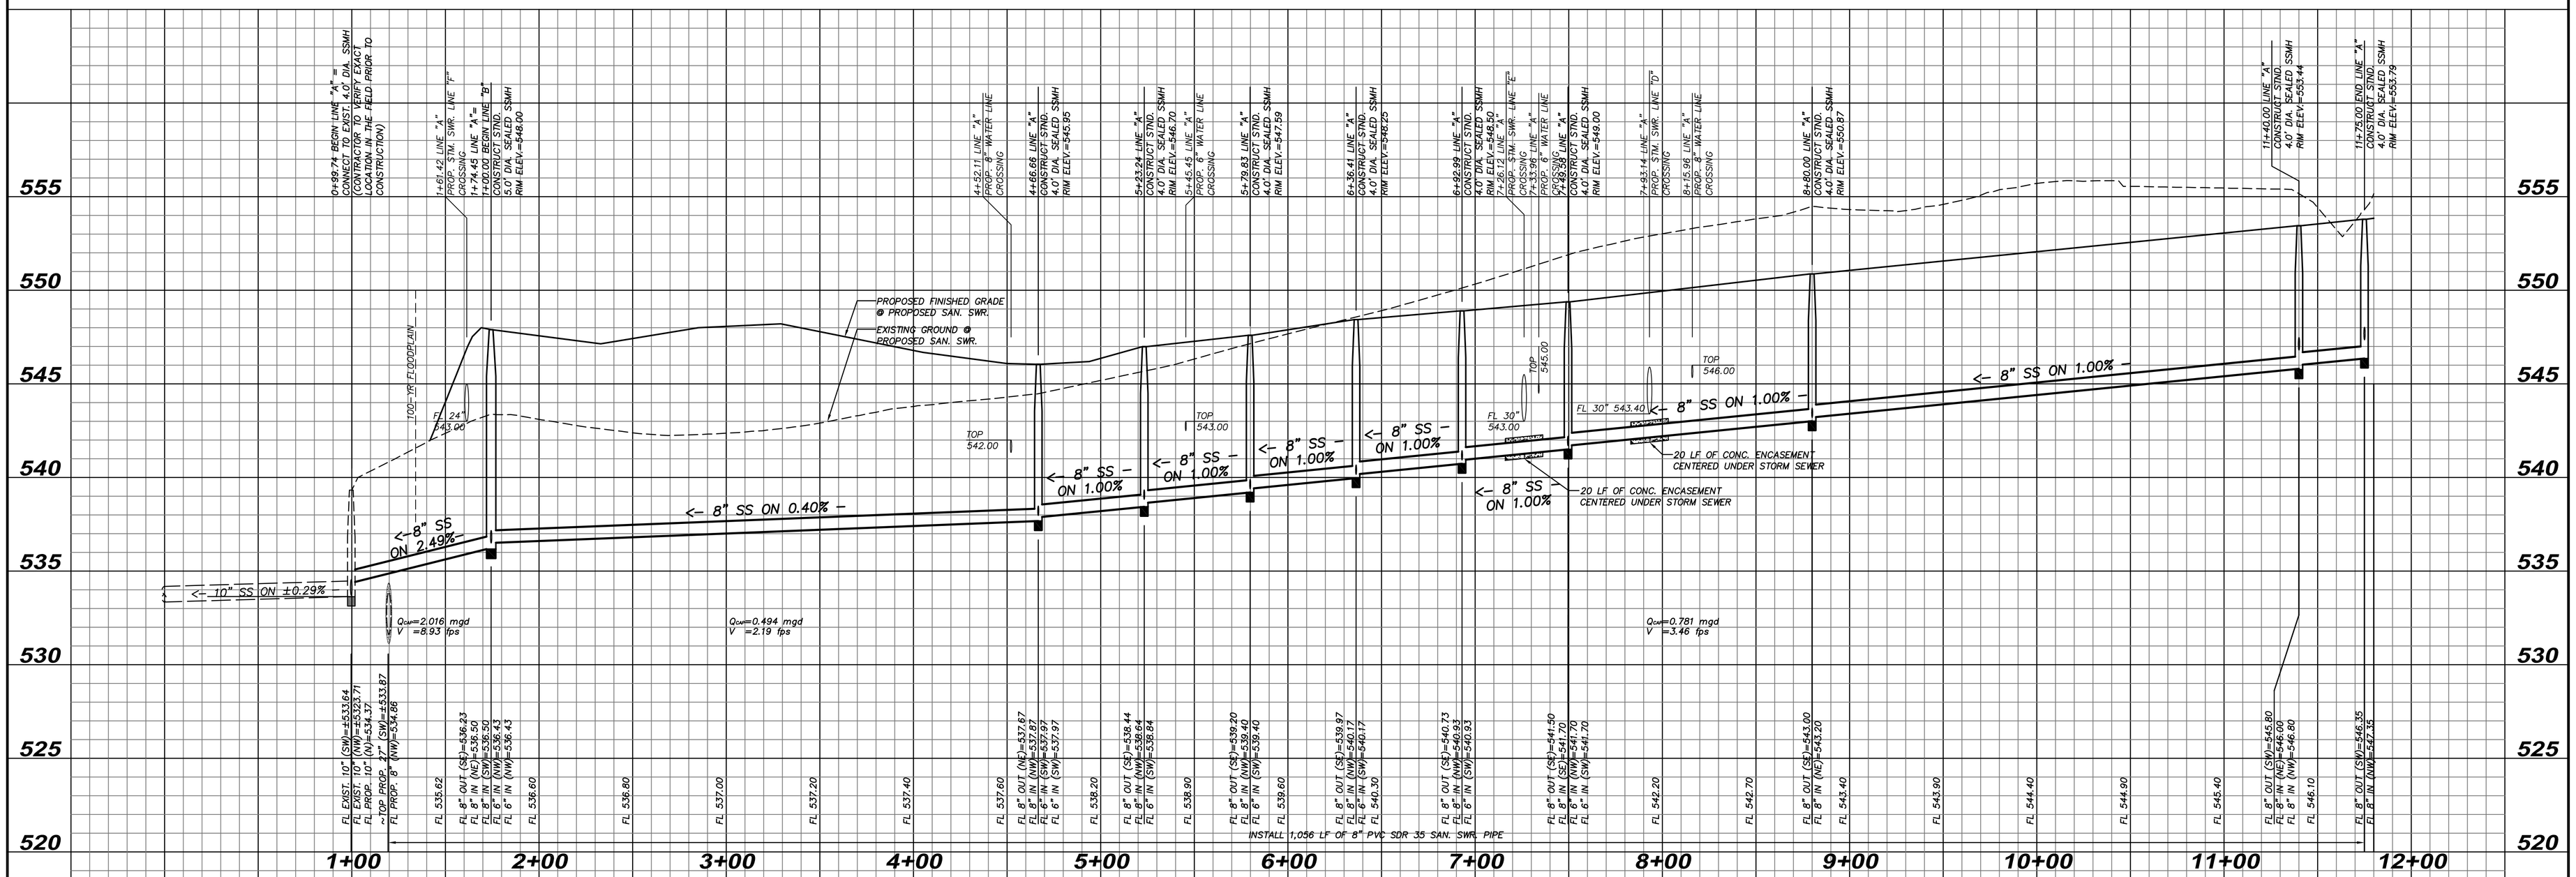

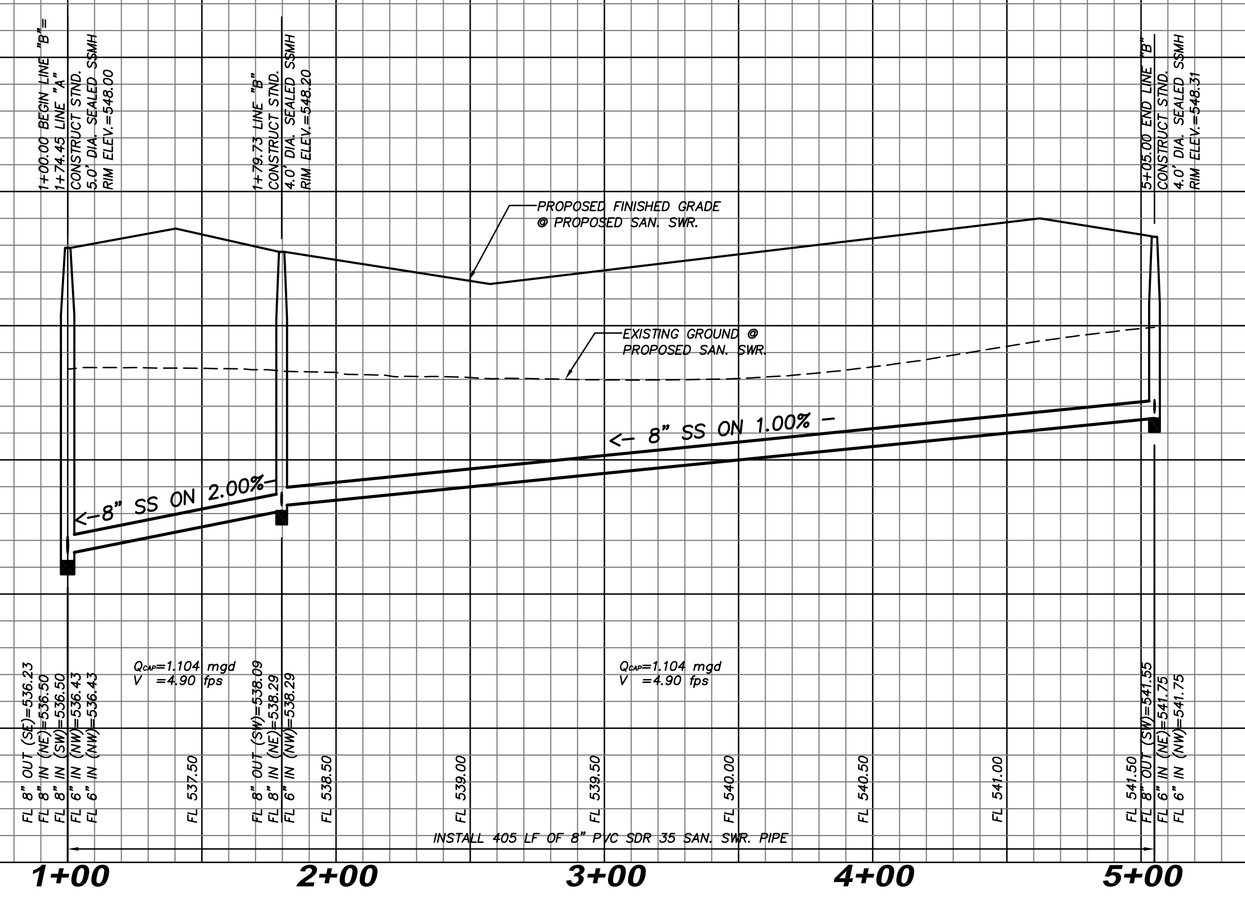

RECORD DRAWING
RECORD INFORMATION PROVIDED BY CONASTER CONSTRUCTION, FORT WORTH, TEXAS
ELEVATION VERIFICATION PERFORMED BY SURVEY CONSULTANTS, INC., PLANO, TEXAS

NOTES:
1. CONTRACTOR TO ADJUST PROPOSED MANHOLE RIM ELEVATION TO MATCH PROPOSED FINISHED GRADE.
2. ALL SANITARY SEWER MANHOLES TO BE SEALED.

STATE OF TEXAS
ROBERT K. MANAOIS
86508
LICENSED
PROFESSIONAL ENGINEER

REV.	DATE	REMARKS	BY

SANITARY SEWER PROFILES

MANSIONS SENIOR

CITY of ROCKWALL, TEXAS

RKM Consulting Engineers, Inc.
7616 LBJ Freeway, Suite 530
Dallas, Texas 75251
phone (214) 432-8070
fax (214) 432-8069

Copyright © 2009 RKM Consulting Engineers, Inc.

CHECKED	DESIGN	DRAWN	JOB	DATE	SCALE	SHEET
RKM	JRY	JRY	1026-005	02/18/09	1"=40' (H) 1"=4' (V)	16 OF 20

I:\PROJECTS\1026 - WESTERN RIM INVESTMENTS\1026-005 ROCKWALL\26-005 RS SS Profiles.dwg Plotted on: 03/17/2010 - 11:09 am