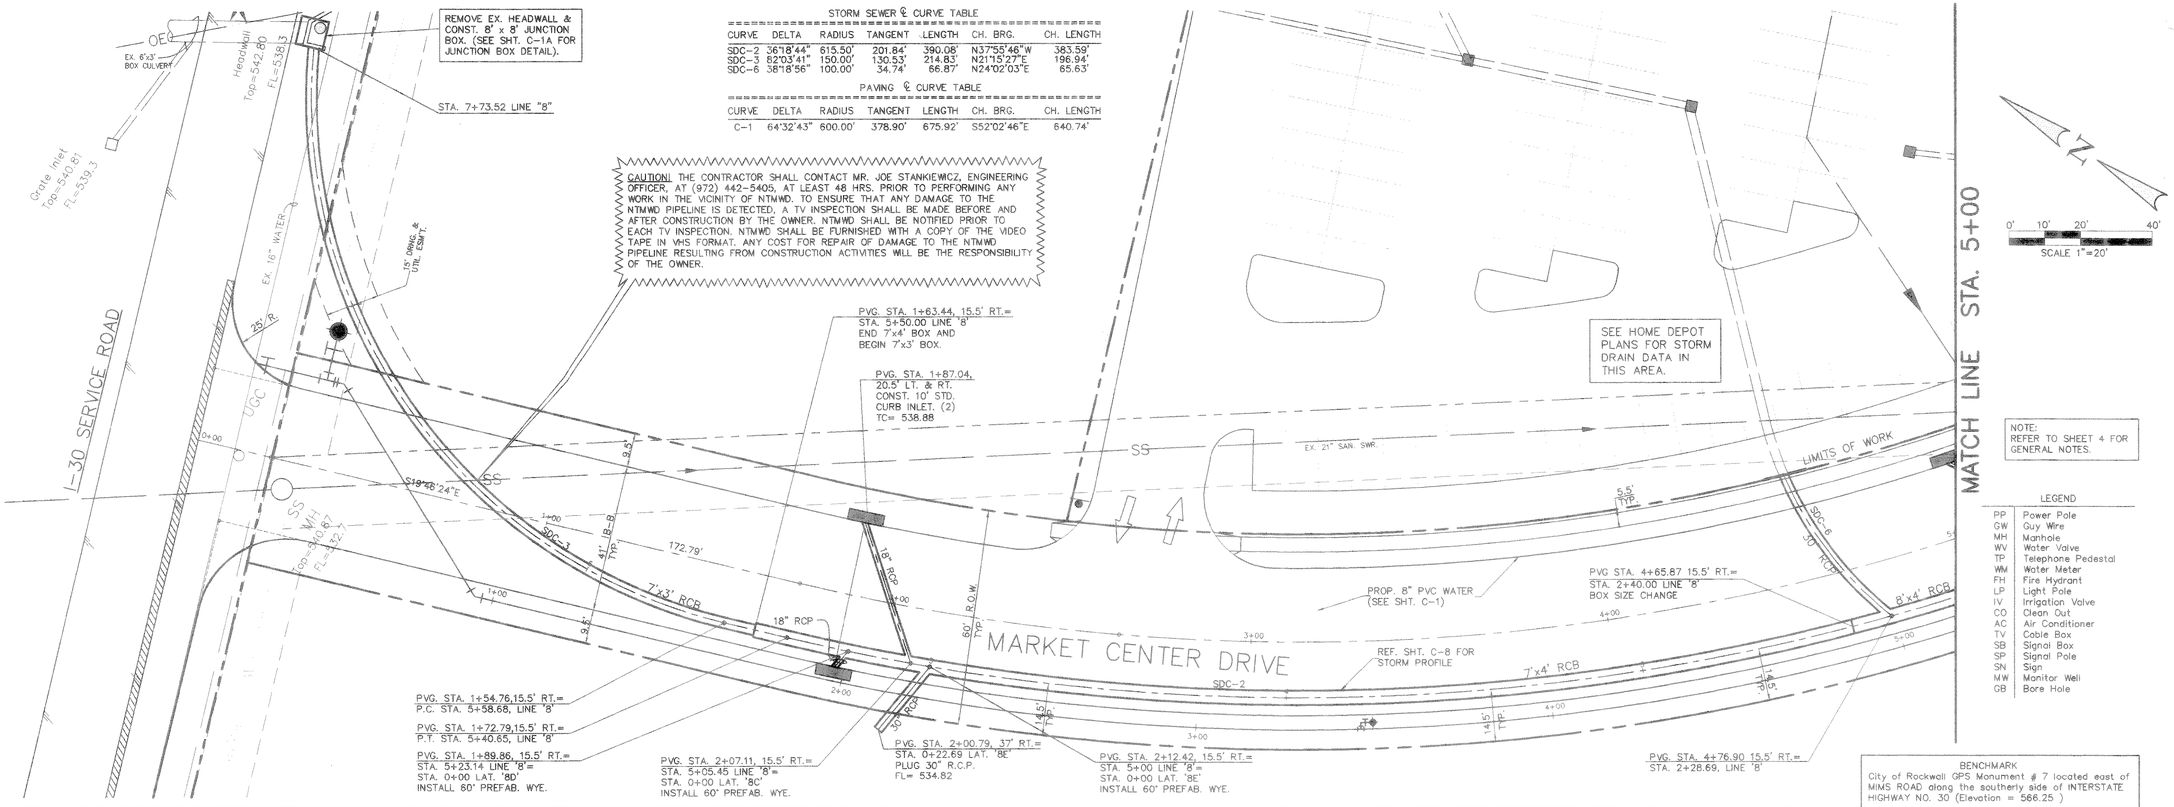

STORM SEWER & CURVE TABLE

CURVE	DELTA	RADIUS	TANGENT	LENGTH	CH. BRG.	CH. LENGTH
SDC-2	36°18'44"	615.50'	201.84'	390.08'	N37°55'46"W	383.59'
SDC-3	82°03'41"	150.00'	130.53'	214.83'	N21°15'27"E	196.94'
SDC-6	38°18'56"	100.00'	34.74'	66.87'	N24°02'03"E	65.63'

PAVING & CURVE TABLE

CURVE	DELTA	RADIUS	TANGENT	LENGTH	CH. BRG.	CH. LENGTH
C-1	64°32'43"	600.00'	378.90'	675.92'	S52°02'46"E	640.74'

BENCHMARK
City of Rockwall GPS Monument # 7 located east of MIMS ROAD along the southerly side of INTERSTATE HIGHWAY NO. 30 (Elevation = 566.25)

REFERENCE SHEET C-8 FOR STORM SEWER PROFILES

AS BUILT

Winkelmann & Associates, Inc. hereby states that, to the best of our knowledge and belief, "As built" modifications from the originally approved construction documents have been made as per information provided by the contractor. Winkelmann & Associates, Inc. does not certify as to the correctness or quality of construction and has not field inspection was performed.

WINKELMANN & ASSOCIATES, INC. DATE: 5-13-98

Winkelmann & Associates, Inc.
CONSULTING CIVIL ENGINEERS & SURVEYORS
12966 Hillcrest Road, Suite 700
Dallas, Texas 75230
(972) 490-7999 FAX

STATE OF TEXAS
MICHAEL D. CLARK
63290
REGISTERED
PROFESSIONAL ENGINEER

E.P. GAINES CHISUM SURVEY, ABST. No. 64
CITY OF ROCKWALL
ROCKWALL COUNTY, TEXAS

HOME DEPOT, U.S.A., INC.
2800 FOREST LANE
DALLAS, TEXAS 75234

STORM SEWER PLAN
MARKET CENTER DRIVE

Scale: H: 1"=20' V: 1"=5' Date: 12/29/97
Designed By: M.D.C.
Drawn By: R.D.L.
Checked By: M.D.C.
File: 07939STP.DWG
Project No: 07939.01(20)

SHEET C-8 OF 16

C:\GEO\DWGS\07939stp Mon Dec 29 10:12:59 1997 RDL