CIVIL CONSTRUCTION PLANS
FOR
McDONALD'S
L/C: 42/398
ROCKWALL, TEXAS
I-30 @ F.M. 740 (RIDGE ROAD)

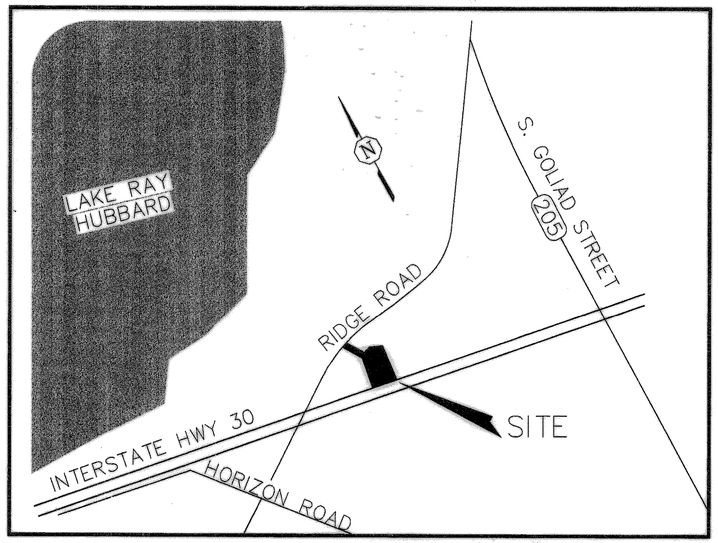

VICINITY MAP

N.T.S.

INDEX TO SHEETS

SHEET NO.	DESCRIPTION
C-0	COVER SHEET
	PLAT
C-1	SITE PLAN
C-1A	DEMO PLAN
C-1B	JOINT CONTROL PLAN
C-1C	COORDINATE CONTROL PLAN
C-2	GRADING PLAN
C-2A	DRAINAGE PLAN
SD1	SITE DETAILS
SD2	SITE DETAILS
SD3	LOT STRIPING DETAILS
SD4	PAVING DETAILS
L1	LANDSCAPING PLAN
L2	LANDSCAPING NOTES

RECORD DRAWINGS
07/25/2000
The intent of the owner and engineer was to construct these facilities according to these plans as approved by the City of Rockwall. The lines and grades were set on the ground for construction according to said plans. The City of Rockwall inspected the construction of these facilities. The pavement grades and above the ground utility appurtenances were verified by an on the ground survey performed after completion of construction and are shown hereon. We are not aware of any other changes or revisions to these plans during construction except those shown in these plans.

REV	DATE	DESCRIPTION	BY	ISSUE REF
1	5/28/99	REVISIONS AS PER CITY OF ROCKWALL	J.L.	

ADAMS CONSULTING ENGINEERS, INC.
CIVIL • ENVIRONMENTAL ENGINEERS
2445 E. Southlake Blvd., Suite 100 • Southlake, Texas 76092
Phone: (817) 329-6880 • Fax: (817) 329-7671

STATE OF TEXAS — GARY M. ADAMS — 37189 — LICENSED PROFESSIONAL ENGINEER

PLAN APPROVALS

SIGNATURE (2 REQUIRED) — DATE

REGIONAL MGR.
CONST. MGR.
OPERATIONS DEPT.
REAL ESTATE DEPT.

CO-SIGN SIGNATURES — DATE

CONTRACTOR
OWNER

STATUS	DATE	BY
DATE DRAWN	4/23/99	J.L.
PLAN CHECKED		G.R.A.
AS-BUILT		

OFFICE: DALLAS REGION - (972)869-1688
ADDRESS: KROC DRIVE - OAK BROOK, ILLINOIS 60521

McDONALD'S®

THESE PLANS AND SPECIFICATIONS ARE THE PROPERTY OF McDONALD'S CORPORATION AND SHALL NOT BE REPRODUCED WITHOUT THEIR WRITTEN PERMISSION.

I-30 @ F.M. 740 (RIDGE ROAD)
ROCKWALL, TEXAS

McDONALD'S L/C: 42/398
ACEI J.N. 099-015

C-0