EROSION CONTROL DETAILS

CONSTRUCTION OF A FILTER BARRIER

N.T.S.

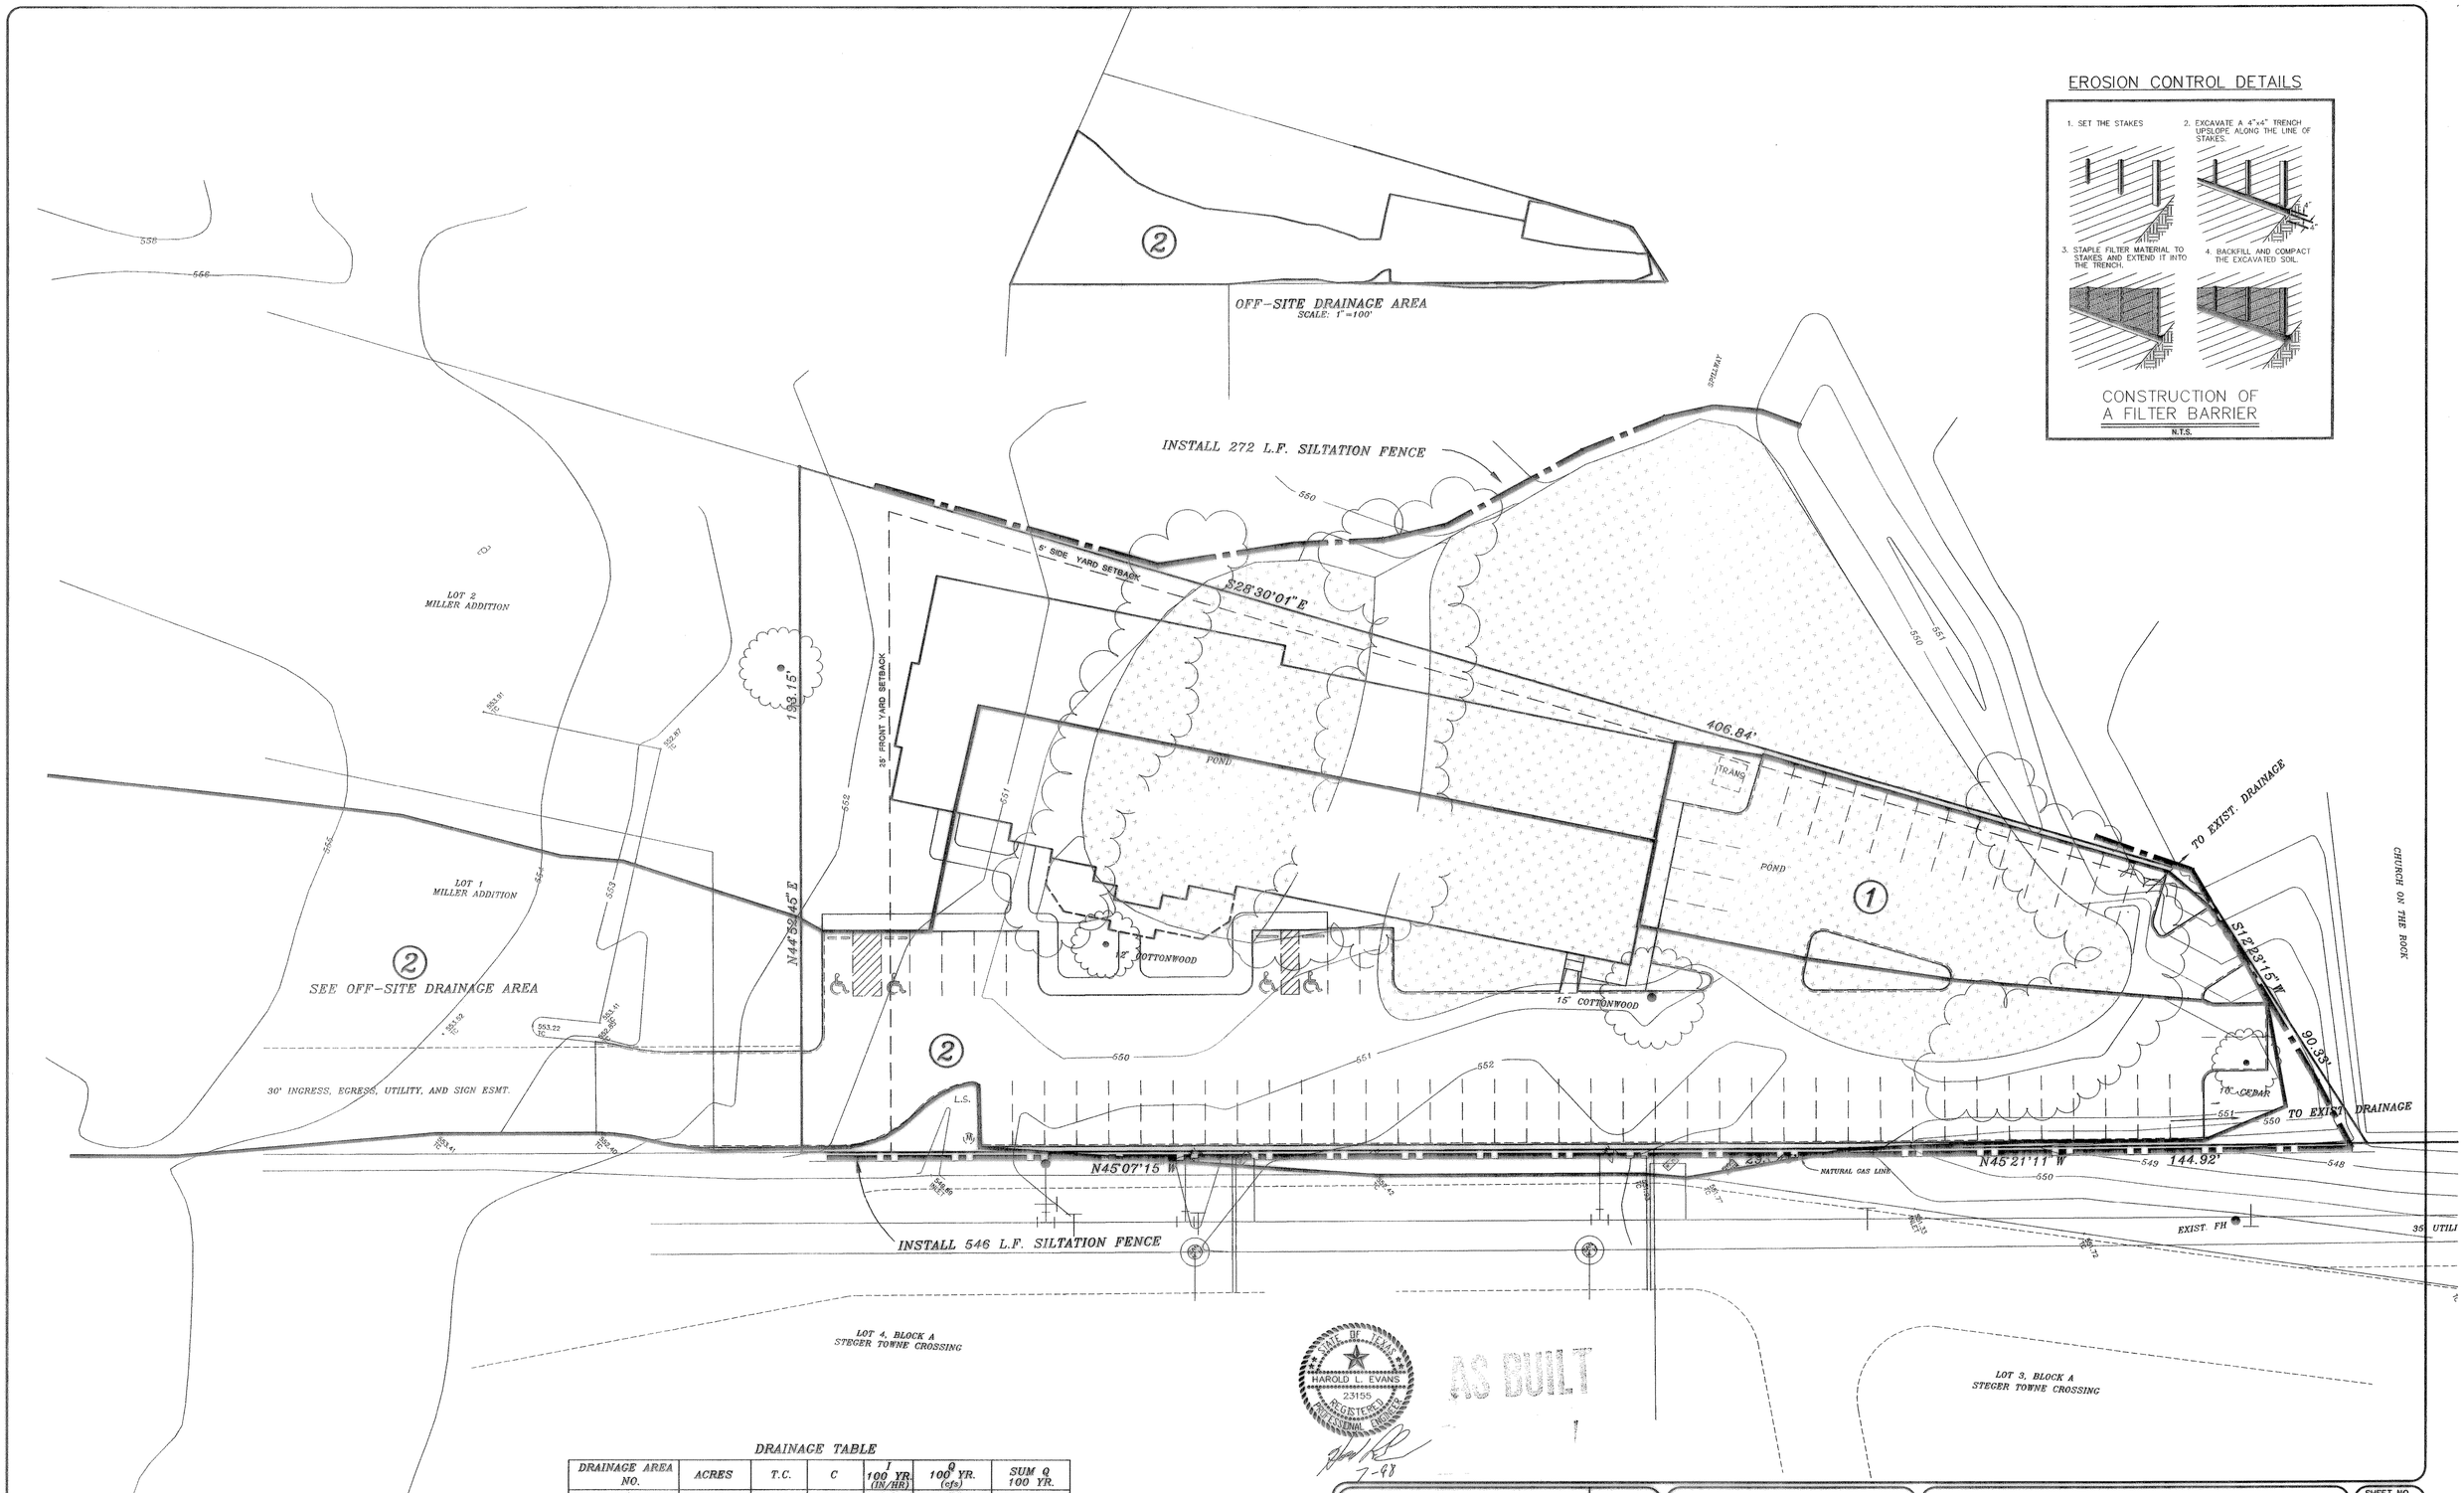

DRAINAGE TABLE

DRAINAGE AREA NO.	ACRES	T.C.	C	I 100 YR. (IN/HR)	Q 100 YR. (cfs)	SUM Q 100 YR.
1	0.17	10	0.8	9.8	1.33	
2	2.02	"	"	"	15.84	

REVISION DESCRIPTION	DATE
REV. PER 2nd. CITY REVIEW	7/28/98
REV. PER 1st. CITY REVIEW	7/10/98

9848DRN

HAROLD L. EVANS
CONSULTING ENGINEER
P.O. BOX 28355
2331 GUS THOMASSON ROAD, SUITE 102
DALLAS, TEXAS 75228, (214) 328-8133

DATE	SCALE	DESIGN	DRAWN
7/14/98	1" = 20'	H.L.E.	

EROSION CONTROL & DRAINAGE AREA
LOT 3
MILLER ADDITION
CITY OF ROCKWALL

SHEET NO. 3 / 6

JOB NO. 9848