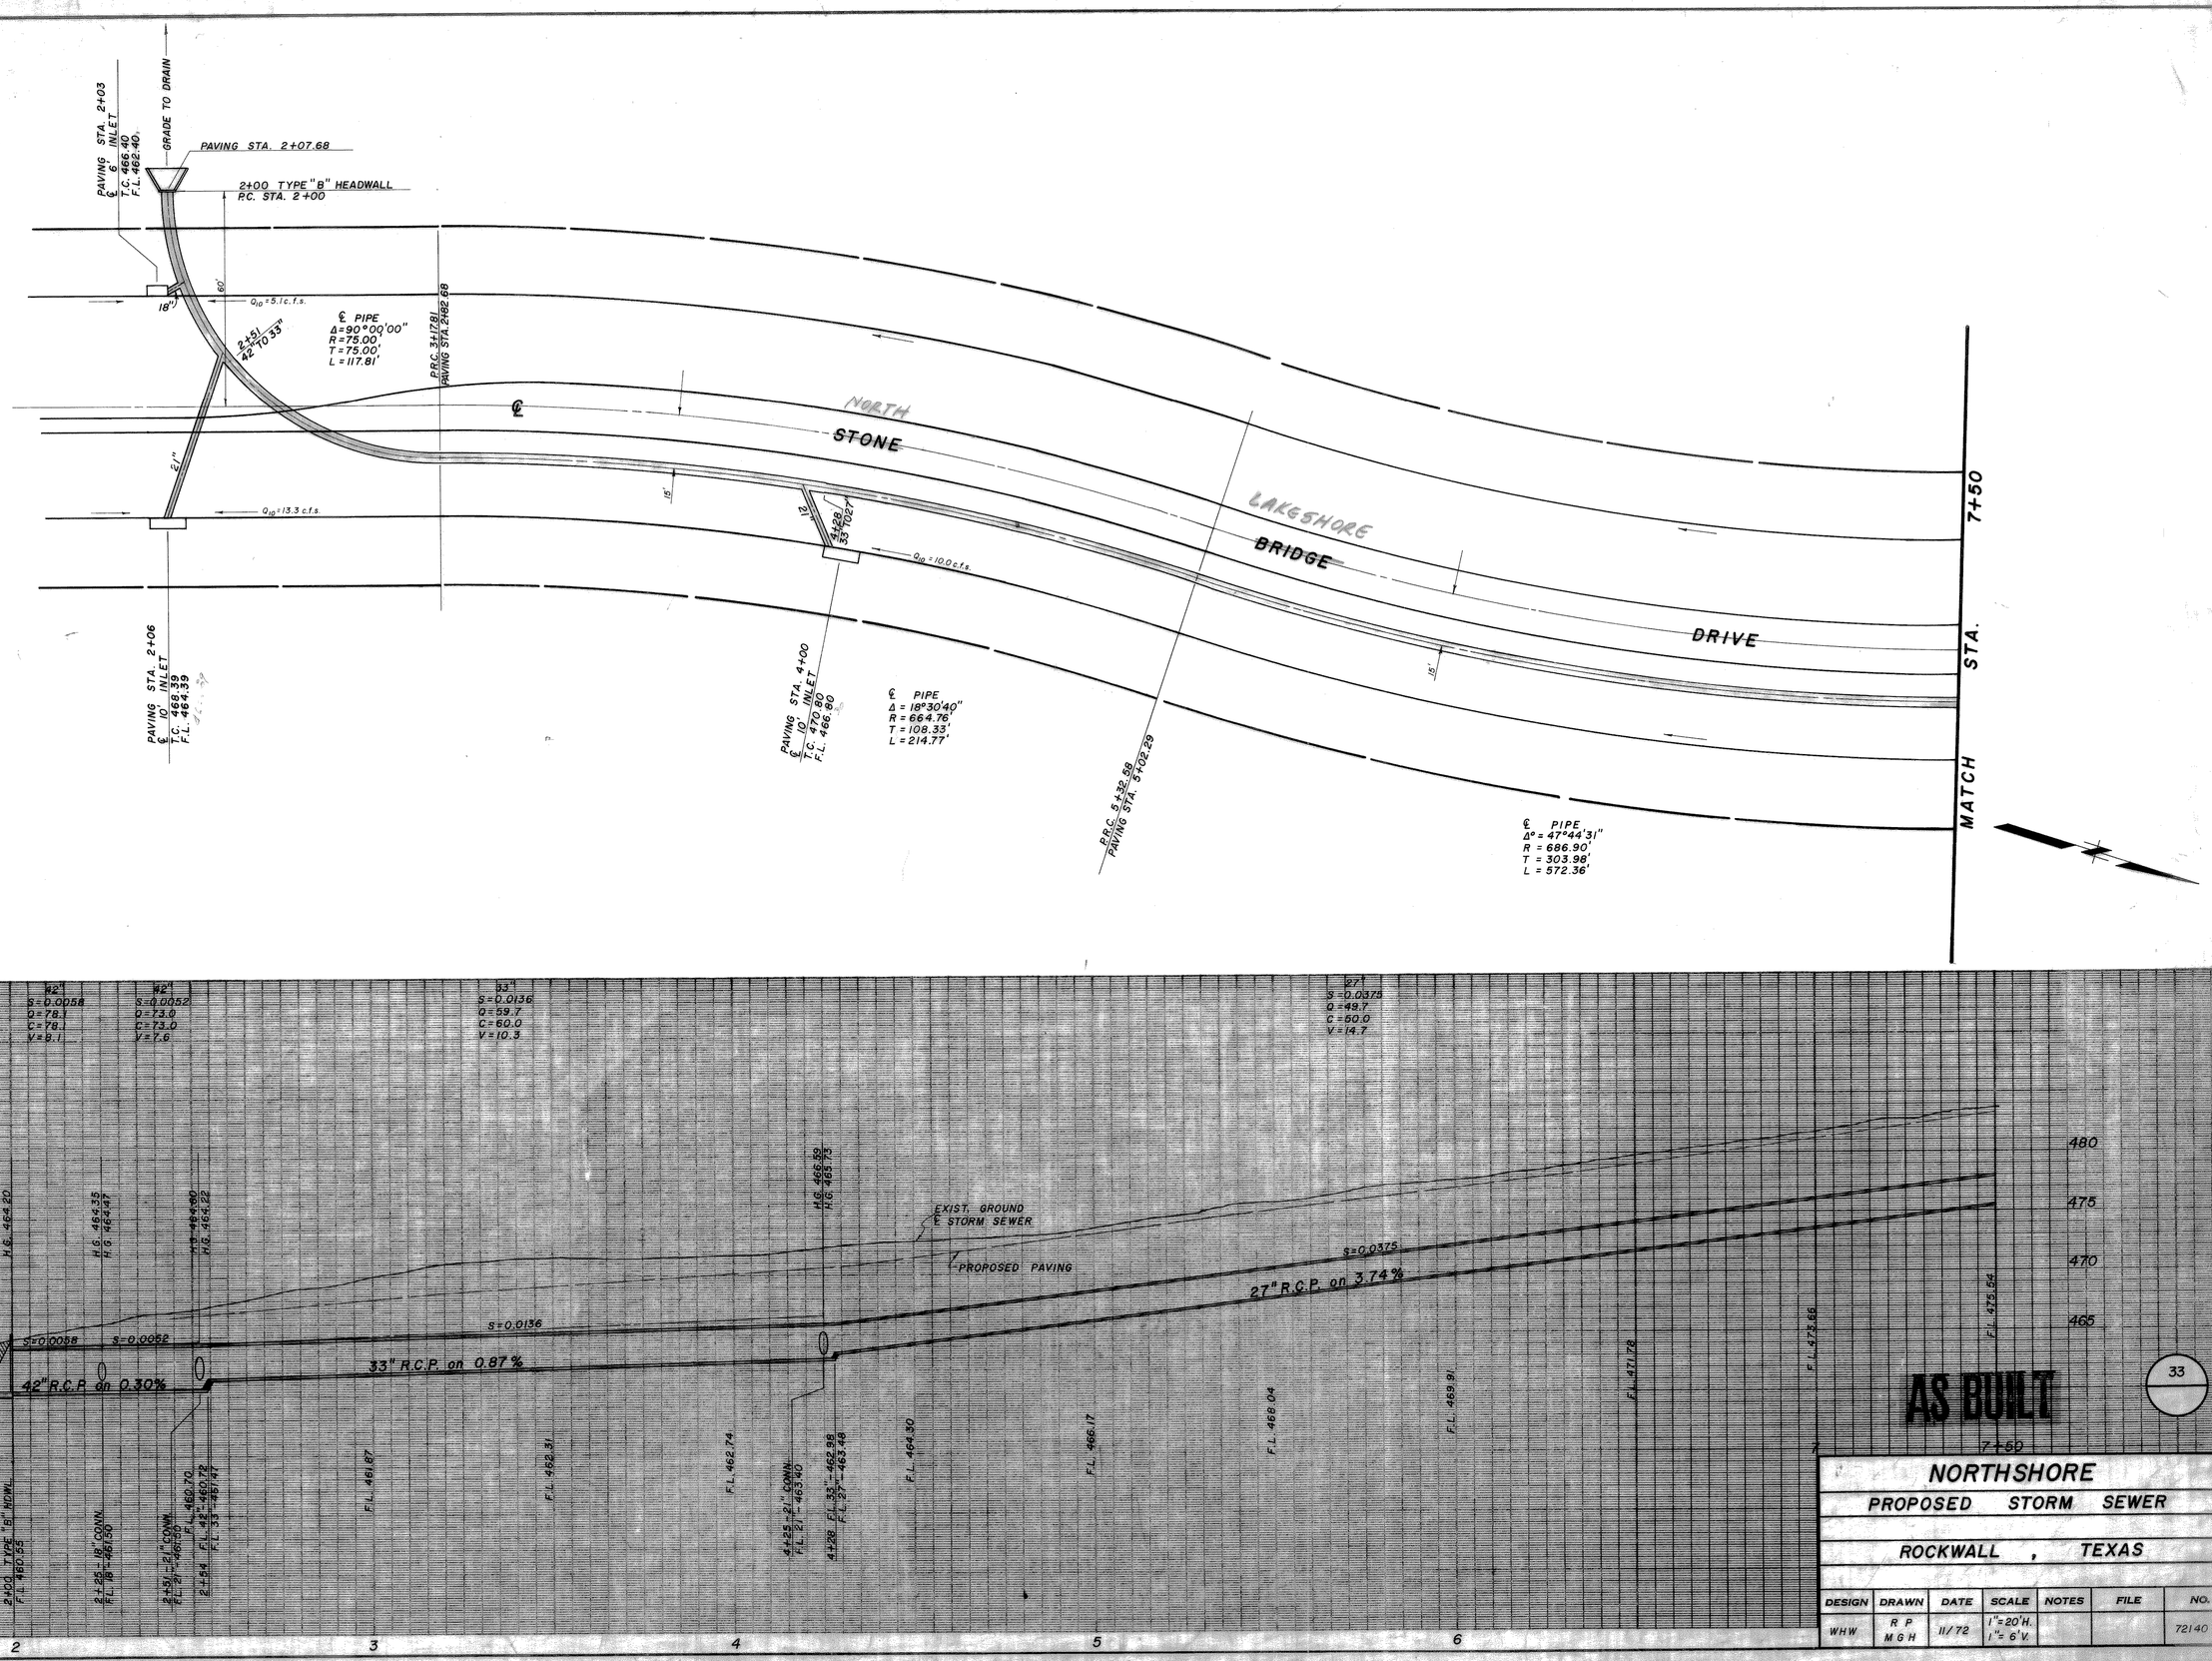

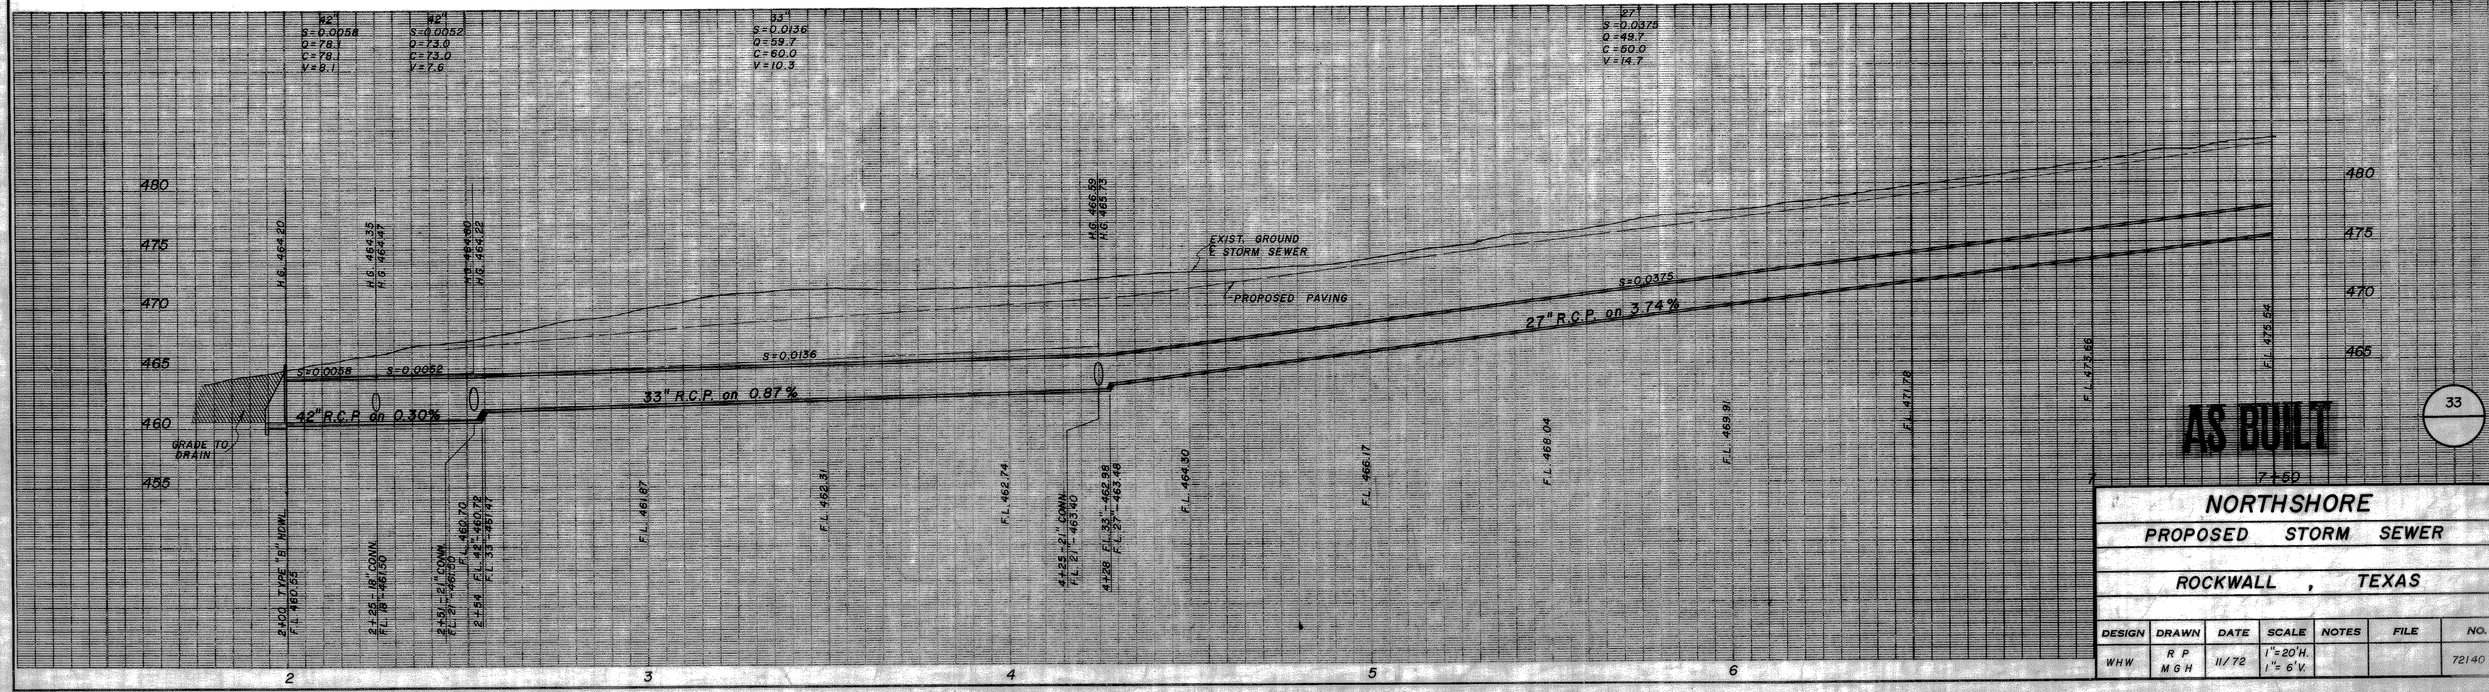

AS BUILT

33

NORTHSHORE

PROPOSED STORM SEWER

ROCKWALL , TEXAS

DESIGN	DRAWN	DATE	SCALE	NOTES	FILE	NO.
WHW	R P M G H	11/72	1"=20'H. 1"= 6'V.			72140