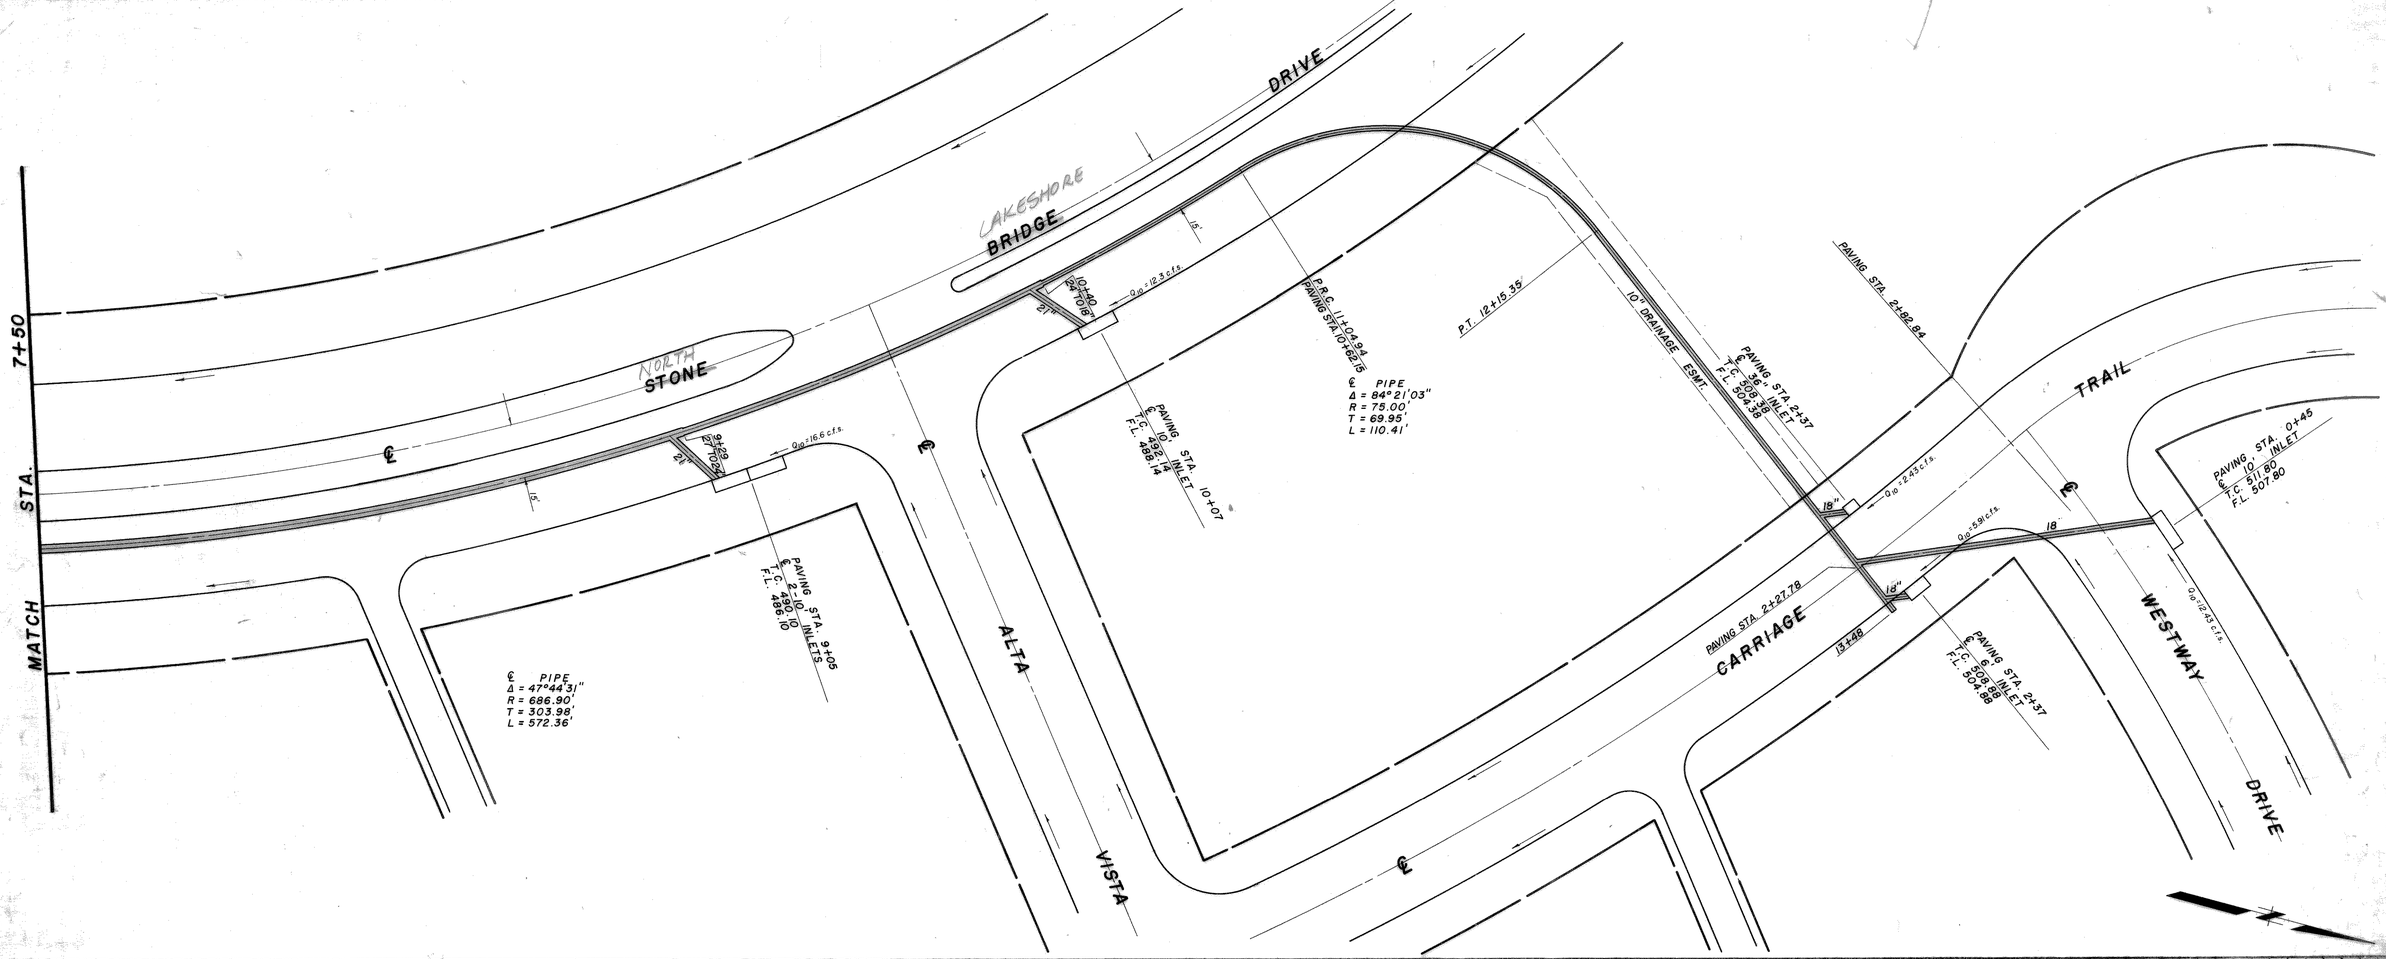

AS BUILT

34

NORTHSHORE

PROPOSED STORM SEWER

ROCKWALL , TEXAS

DESIGN	DRAWN	DATE	SCALE	NOTES	FILE	NO.
WHW	RP MGH	11/72	1"=20'H. 1"=6'V.			72140