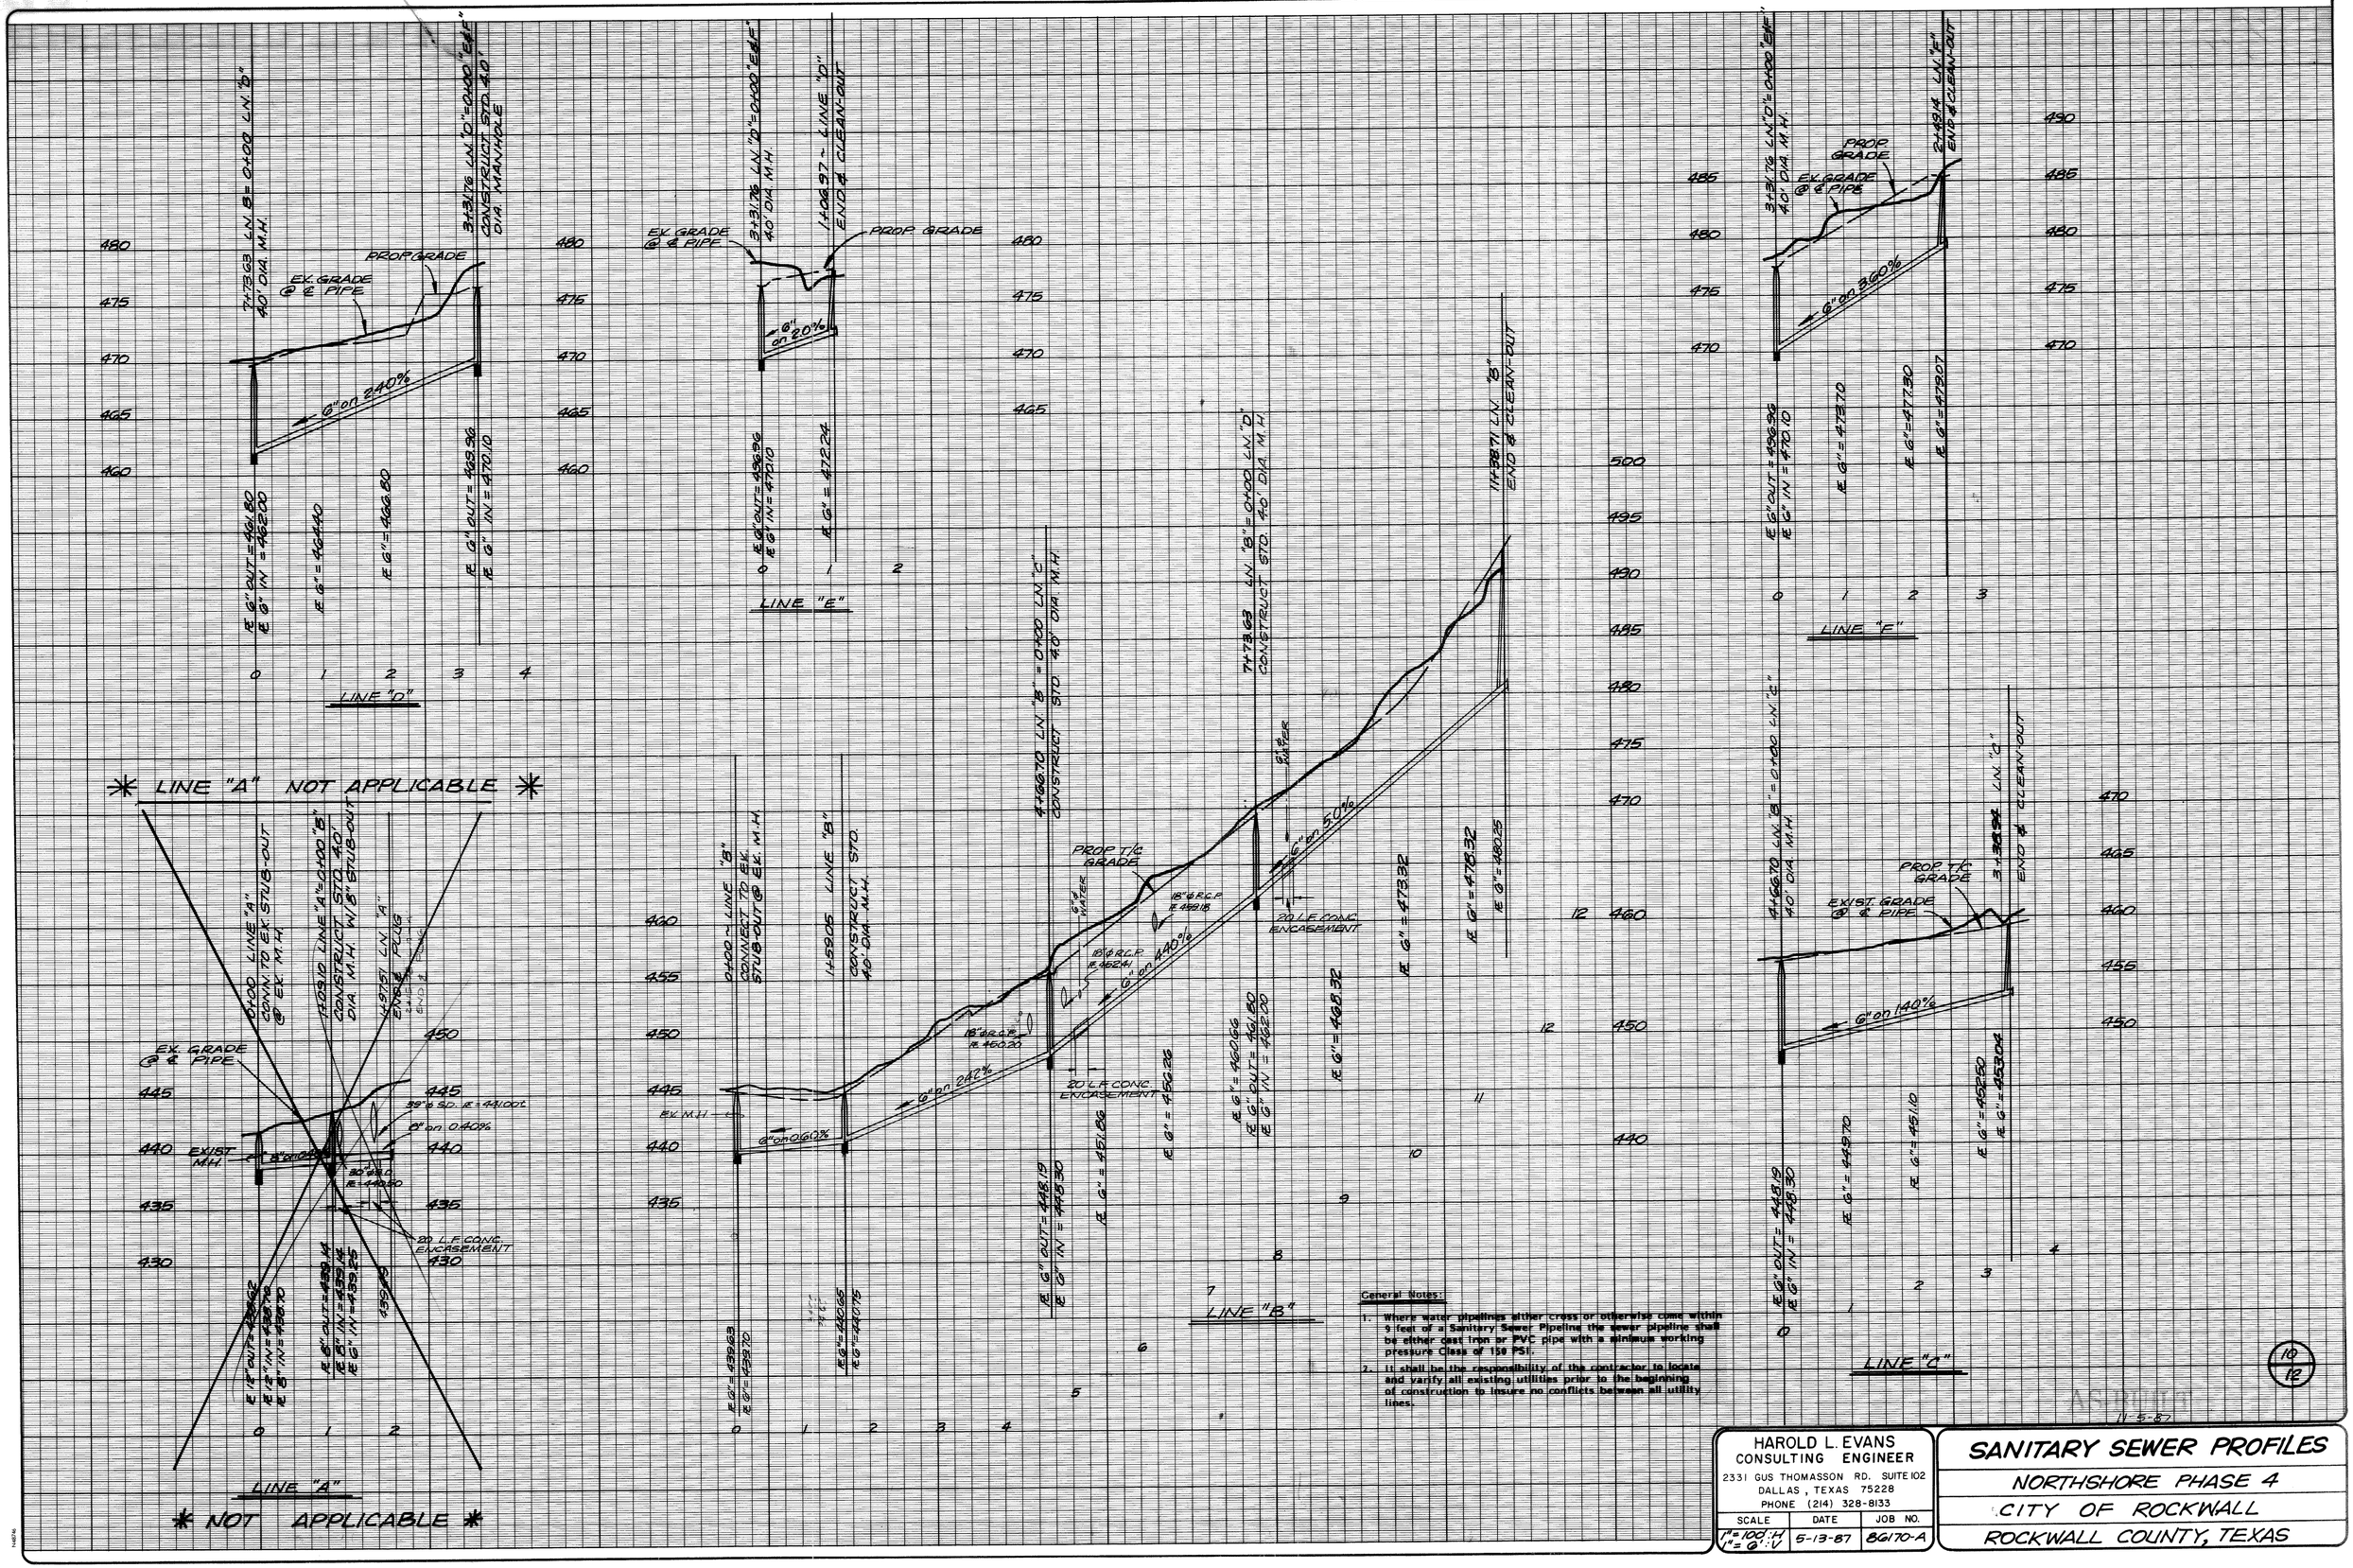


General Notes:

1. Where water pipelines either cross or otherwise come within 9 feet of a Sanitary Sewer Pipeline the sewer pipeline shall be either cast iron or PVC pipe with a minimum working pressure Class of 150 PSI.
2. It shall be the responsibility of the contractor to locate and varify all existing utilities prior to the beginning of construction to insure no conflicts between all utility lines.

10/12

11-5-87

| HAROLD L. EVANS CONSULTING ENGINEER<br>2331 GUS THOMASSON RD. SUITE 102<br>DALLAS, TEXAS 75228<br>PHONE (214) 328-8133 | | |
|---|---|---|
| SCALE | DATE | JOB NO. |
| 1"=100' :H<br>1"=6' :V | 5-13-87 | 8G170-A |

# SANITARY SEWER PROFILES

NORTHSHORE PHASE 4

CITY OF ROCKWALL

ROCKWALL COUNTY, TEXAS