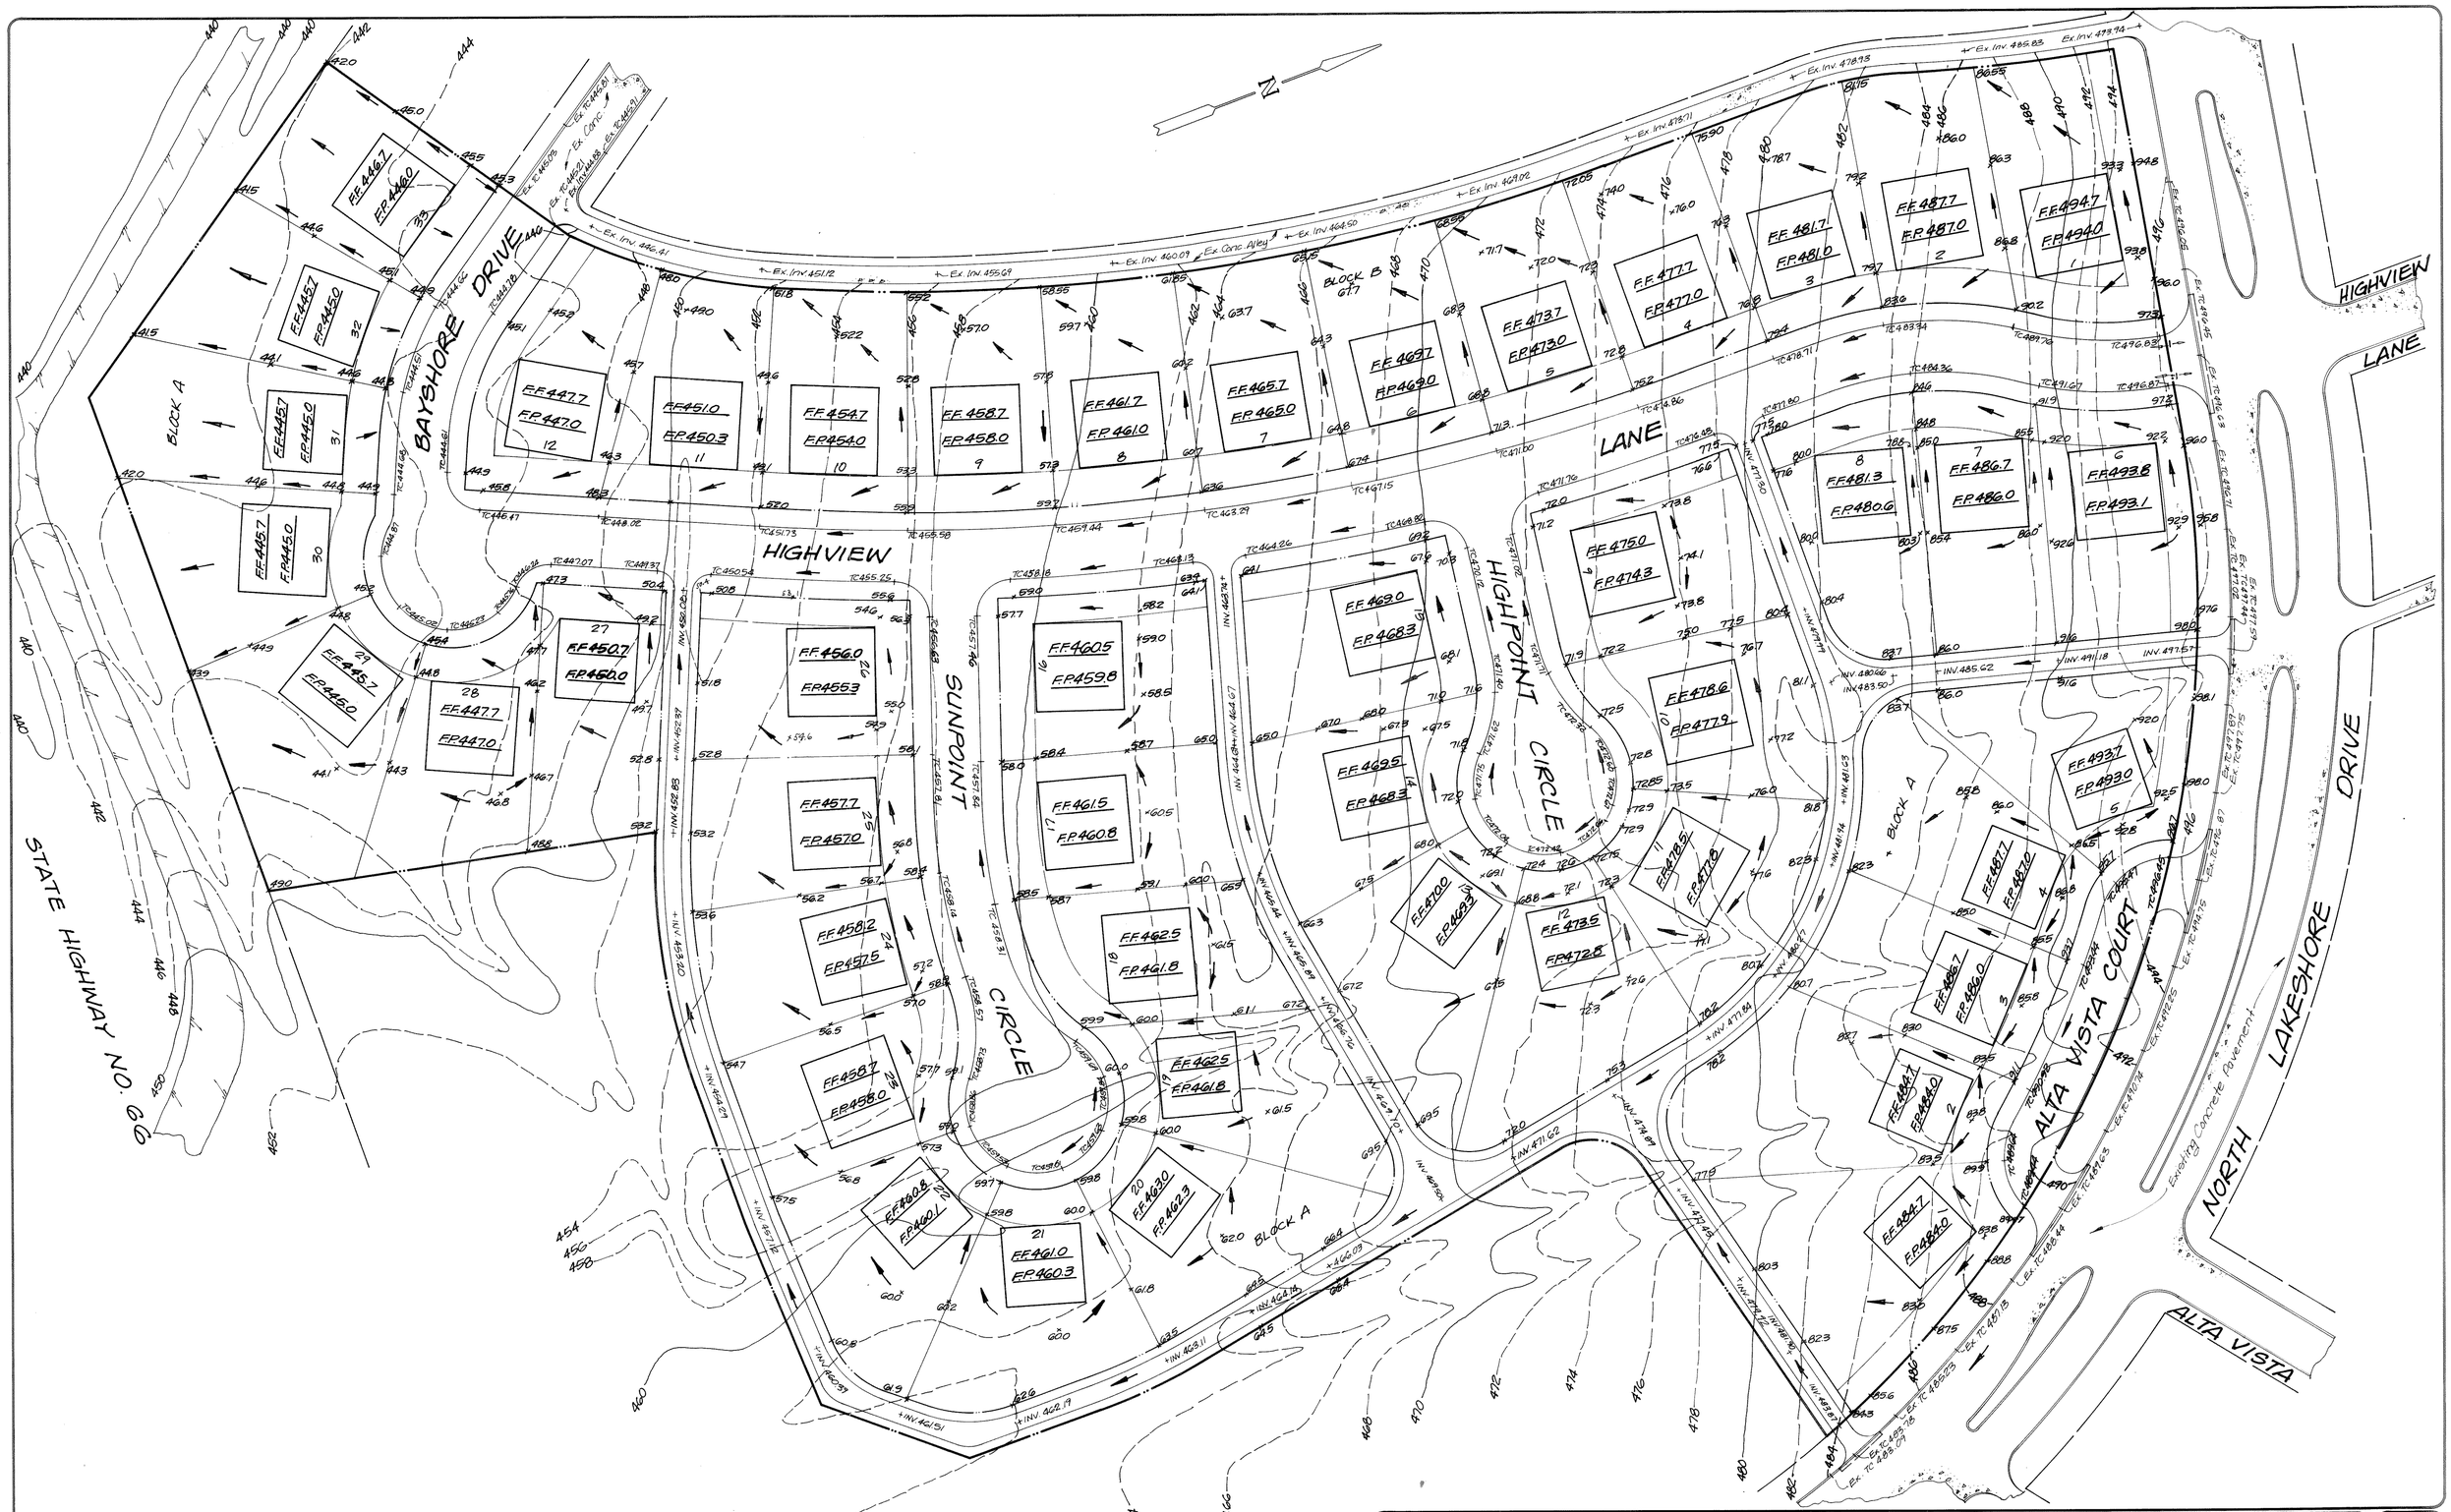

REVISION DESCRIPTION	DATE	SCALE	DESIGN	DRAWN
	5-28-87	1"=40'	H.L.E.&A.	H.L.E.&A.

HAROLD L. EVANS & ASSOCIATES
Consulting Engineers
P.O. Box. 28355
2331 Gus Thomasson Road, Suite 102
Dallas, Texas 75228 (214) 328-8133

LOT GRADING PLAN
NORTHSHORE PHASE 4
CITY OF ROCKWALL
ROCKWALL COUNTY, TEXAS

SHEET NO. 11 / 12

JOB NO. 86170-A