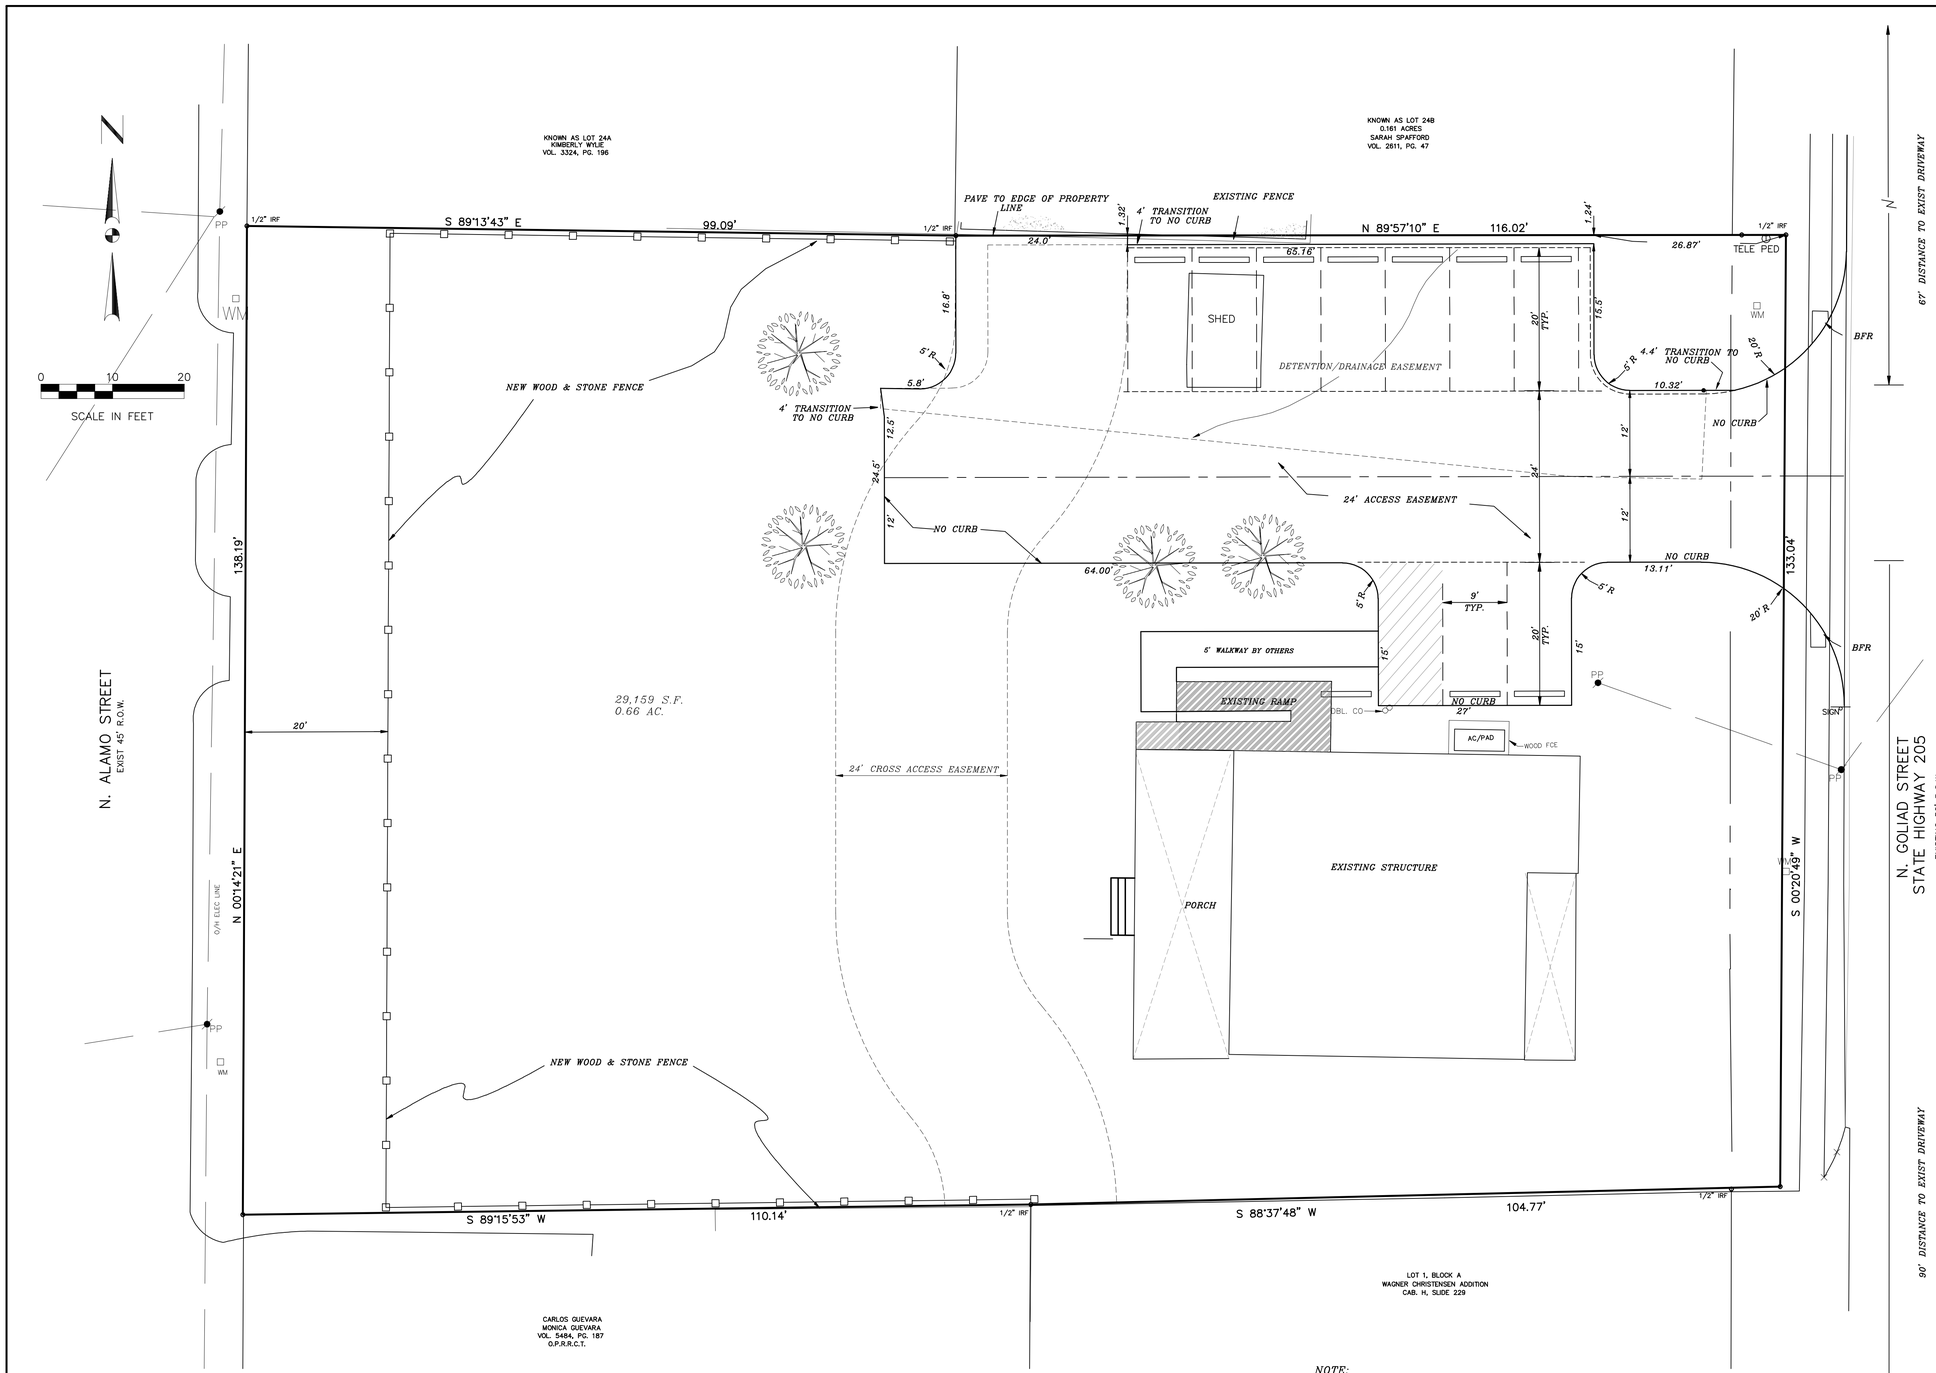

NOTE:
DIMENSIONS ARE TO BACK OF CURB OR EDGE OF PAVEMENT

REVISED TO CONFORM TO CONSTRUCTION RECORDS.

DATE: 12-30-15

CITY CASE NO. SP2014-026

THE SEAL APPEARING ON THIS DOCUMENT WAS AUTHORIZED BY WL. DOUPHRATE II TEXAS P.E. NO. 60102, P-886, ON DATE: JULY 20, 2015

DOUPHRATE & ASSOCIATES, INC.
ENGINEERING • PROJECT MANAGEMENT • SURVEYING
2235 RIDGE RD., # 200 ROCKWALL, TEXAS 75087
PHONE: (972)771-9004 FAX: (972)771-9005

DIMENSION CONTROL PLAN
OUR HOUSE
803 N. GOLIAD STREET
B.F. BOYDSTON SRRVEY, ABST. 14
CITY OF ROCKWALL
ROCKWALL COUNTY, TEXAS

REVISION	10-13-15 REV. ACCESS ESMT., EX. RAMP & PARKING
CHECKED	W.L.D.
DRAWN	G.C.W.
SCALE	1"=10' H 1"= V
DATE	JULY 20, 2015
PROJECT	15016 DIM
	4/14