HIGHWAY PERMIT
DRIVE ENTRANCE
803 N. GOLIAD STREET
CITY OF ROCKWALL
ROCKWALL COUNTY, TEXAS

LOCATION MAP
NTS

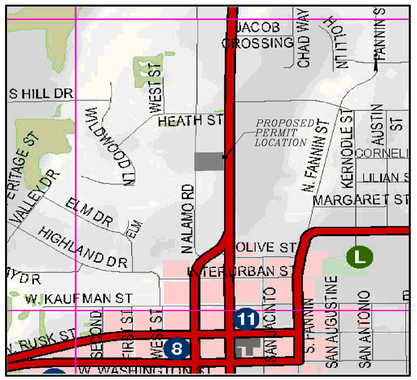

DOUPHRATE & ASSOCIATES, INC.
ENGINEERING PROJECT MANAGEMENT SURVEYING
2235 RIDGE RD., # 200
ROCKWALL, TEXAS 75087
PHONE: (972)771-9004 FAX: (972)771-9005

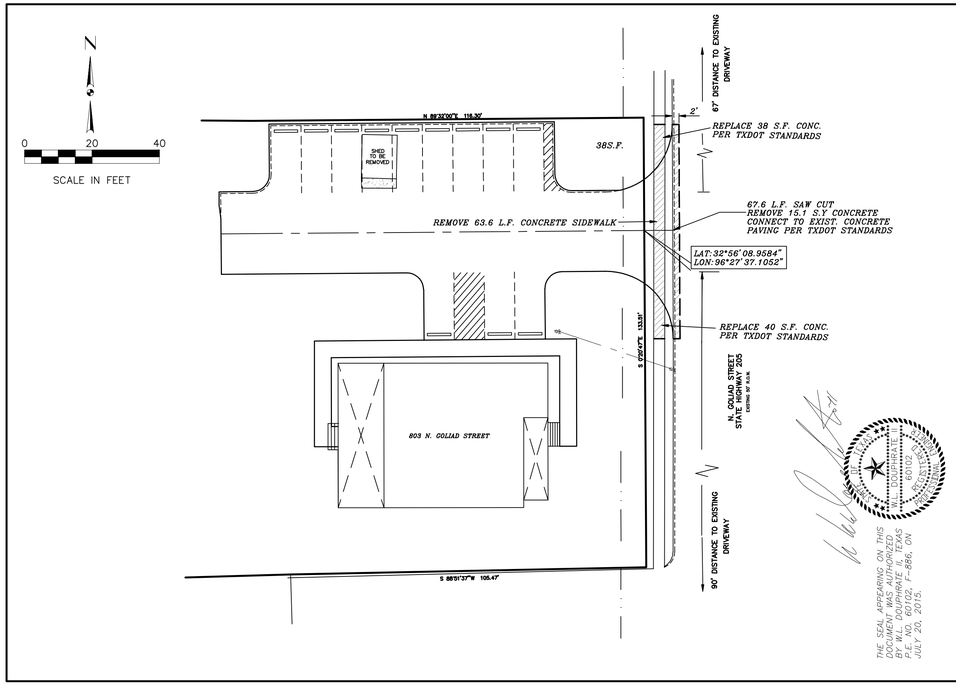

THE SEAL APPEARING ON THIS DOCUMENT WAS AUTHORIZED BY W.L. DOUPHRATE, JR. TEXAS P.E. NO. 61102, T-886, ON JULY 20, 2015.

HIGHWAY PERMIT
DRIVE ENTRANCE
803 N. GOLIAD ST.
CITY OF ROCKWALL
ROCKWALL COUNTY, TEXAS

DATE	7-20-15
DRAWN	G.C.W.
CHECKED	W.L.D.
SCALE	1" = 20'
JOB NO.	15016

DOUPHRATE & ASSOCIATES, INC.
ENGINEERING PROJECT MANAGEMENT SURVEYING
2235 RIDGE RD., # 200
ROCKWALL, TEXAS 75087
PHONE: (972)771-9004 FAX: (972)771-9005

THE SEAL APPEARING ON THIS DOCUMENT WAS AUTHORIZED BY W.L. DOUPHRATE II TEXAS P.E. NO. 61102, T-886, ON DATE: JULY 20, 2015

REVISED TO CONFORM TO CONSTRUCTION RECORDS.

DATE: 12-30-15

DOUPHRATE & ASSOCIATES, INC.
ENGINEERING • PROJECT MANAGEMENT • SURVEYING
2235 RIDGE RD., # 200 ROCKWALL, TEXAS 75087
PHONE: (972)771-9004 FAX: (972)771-9005

HIGHWAY PERMIT
DRIVE ENTRANCE
803 N. GOLIAD
CITY OF ROCKWALL
ROCKWALL COUNTY, TEXAS

REVISION	
CHECKED	W.L.D.
DRAWN	G.C.W.
SCALE	1"=20' H; 1"= V
DATE	AUG. 11, 2015
PROJECT	15016 GRD 2
	9/14

CITY CASE NO. SP2014-026