CAUTION: EXISTING UNDERGROUND UTILITIES. CONTRACTOR TO FIELD VERIFY THE LOCATION OF ALL EXISTING UTILITIES PRIOR TO EXCAVATION.

NOTES:
1. REFER TO NORTH CENTRAL TEXAS COUNCIL OF GOVERNMENTS (NCTCOG) FOR DETAILS OF THE DROP INLET OR AN APPROVED EQUAL.
2. REFER TO TXDOT DETAILS FOR HEADWALLS.
3. LOT 15 & POND B TOPO SURVEY BY PEISER & MANKIN SURVEYING, LLC DATED 3/21/2017.

GRAPHIC SCALE 1"=20'
20 0 20 40

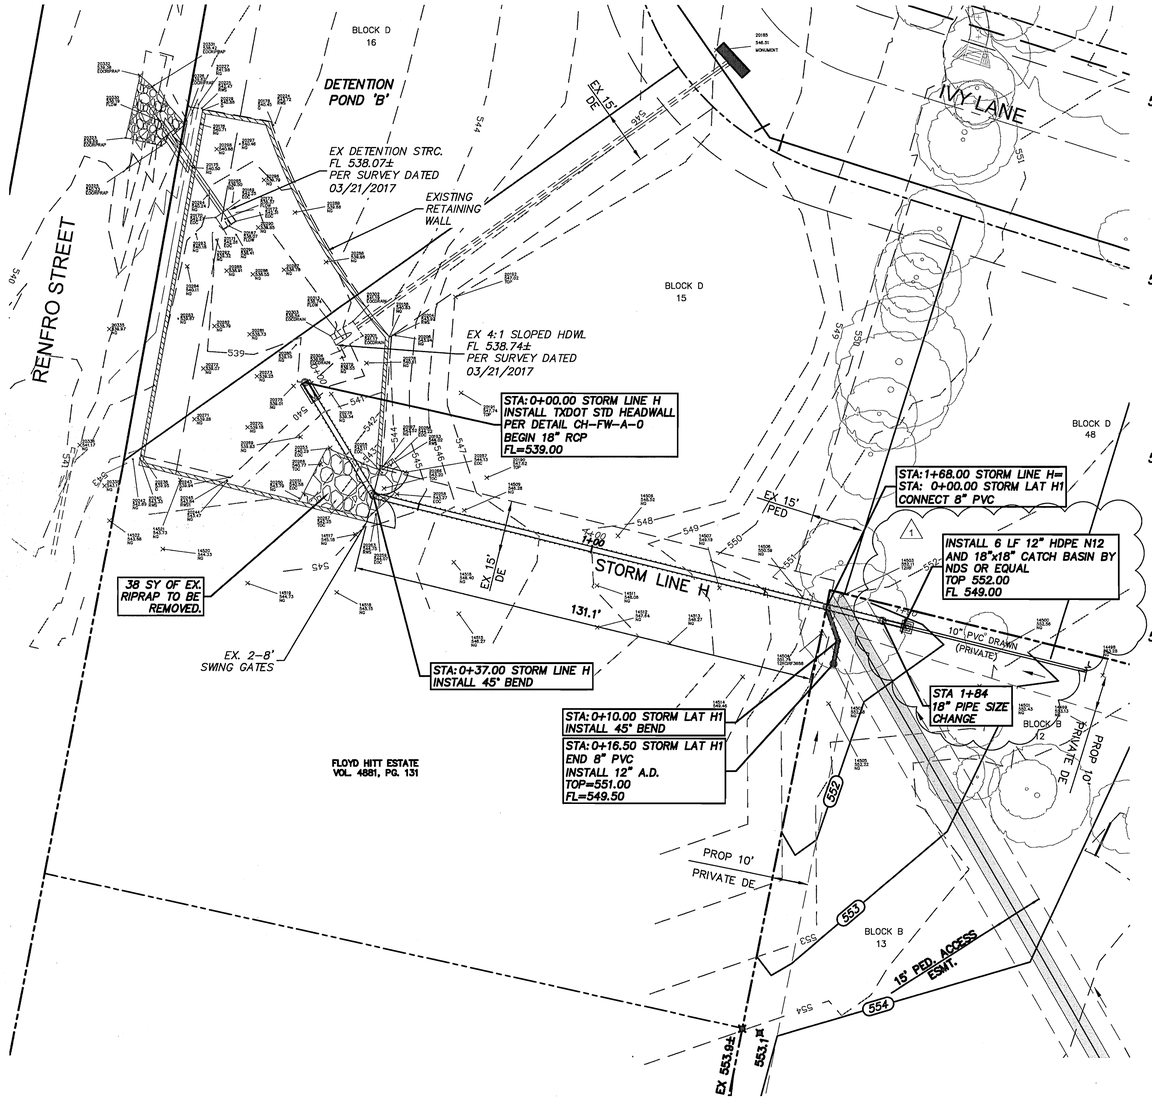

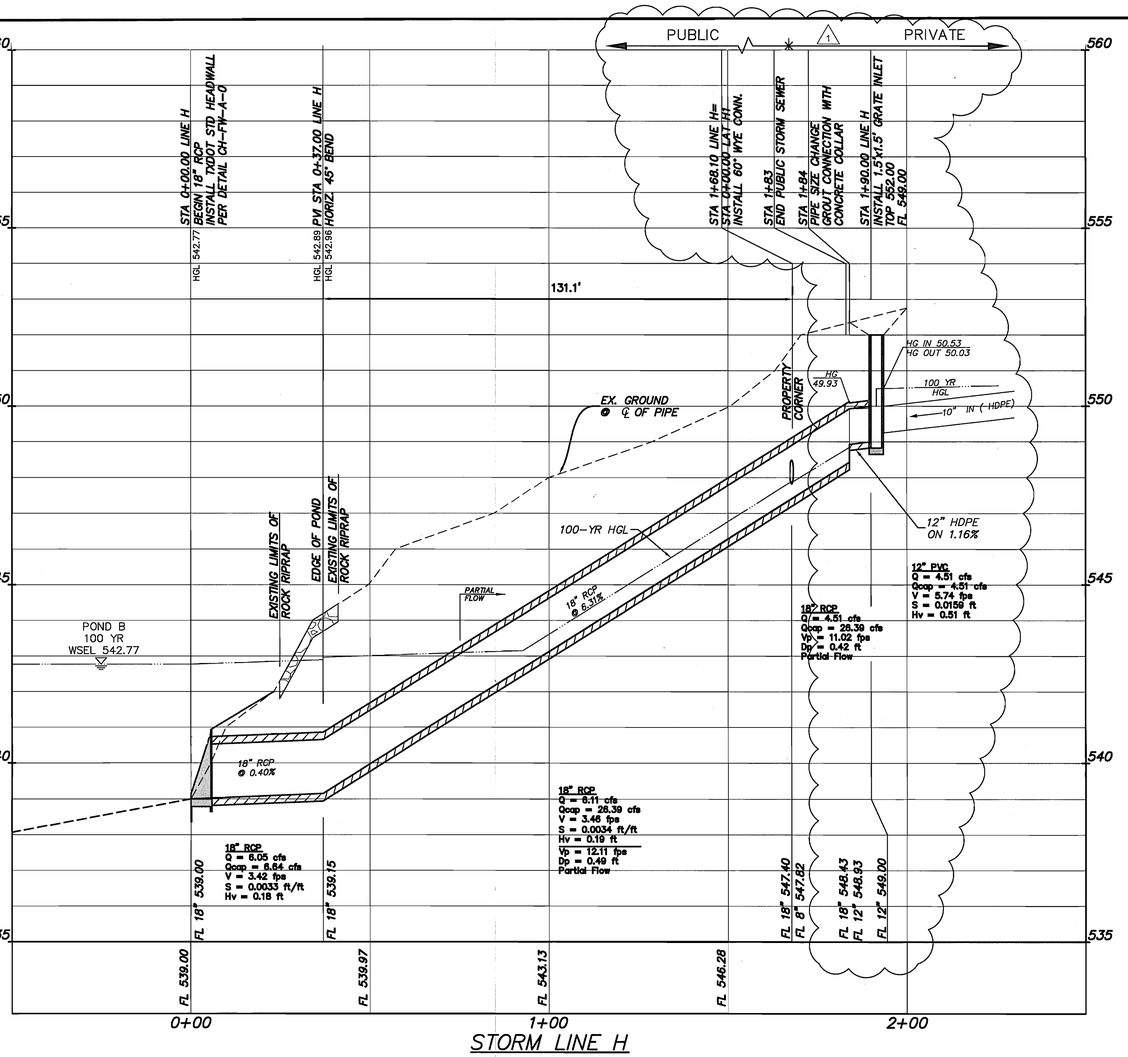

STORM LINE H
H : 1"=20'
V : 1"=4'

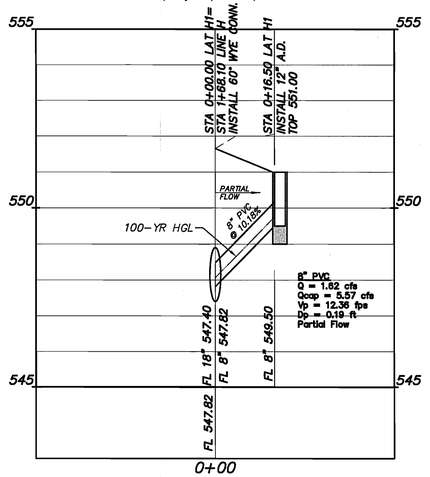

STORM LAT H1
H : 1"=20'
V : 1"=4'

CONSTRUCTION RECORDS
DATE: 10-10-2019 BY: TPJ
THIS DRAWING INDICATES THE WORK COMPLETED PER INFORMATION SUPPLIED BY THE CONTRACTOR. THE ACCURACY AND COMPLETENESS OF THIS INFORMATION HAS NOT BEEN VERIFIED. ACTUAL ON THE GROUND SURVEY VERIFICATION WAS NOT PERFORMED EXCEPT AS SPECIFICALLY NOTED. TOMDEN ENGINEERING, L.L.P. SHALL NOT BE RESPONSIBLE FOR ANY ERRORS OR OMISSIONS THAT MAY BE INCORPORATED AS A RESULT OF ERRONEOUS INFORMATION PROVIDED BY OTHERS.
TOMDEN ENGINEERING, L.L.P.

1 THIS SHEET SUPPLEMENTS ORIGINAL SHT C22 AND SHALL BE USED FOR THE CONSTRUCTION OF THE CLOUDED INFORMATION ONLY. BINKLEY BARFIELD SHALL BE RESPONSIBLE FOR ALL OTHER DESIGN INFORMATION SHOWN.

NO.	DATE	DESCRIPTION
1	04.08.2019	STORM LINE H STA 1+84 TO END

DESIGNED BY: TPJ
DRAWN BY: ADC
CHECKED BY: TPJ
JOB NO:
DATE: 04.08.2019
SCALE: AS SHOWN

TOMDEN ENGINEERING, L.L.P.
5815 MEADOWCREST
DALLAS, TX 75230
(214) 679 - 1679 tjones@tomden.com
FIRM No. 19244

PARK PLACE WEST - PHASE III
R. BALLARD SURVEY ABSTRACT NO. 29
ROCKWALL, ROCKWALL COUNTY, TEXAS
STORM SEWER PLAN & PROFILES
[LINE H & LAT H1]

Sheet No:
C22.1
OF 37