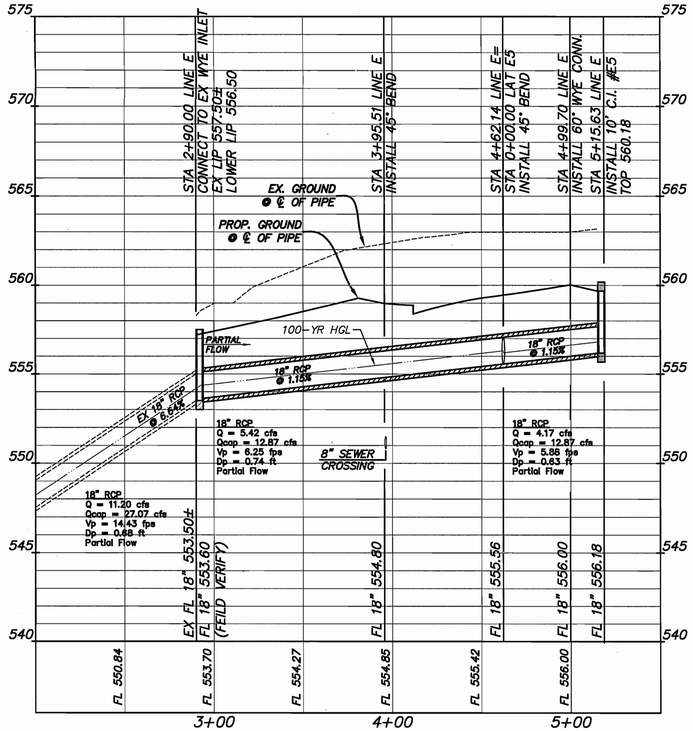

STORM LINE E

H : 1"=40'
V : 1"=4'

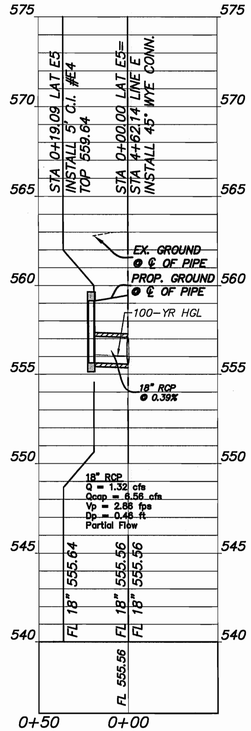

STORM LAT E5

H : 1"=40'
V : 1"=4'

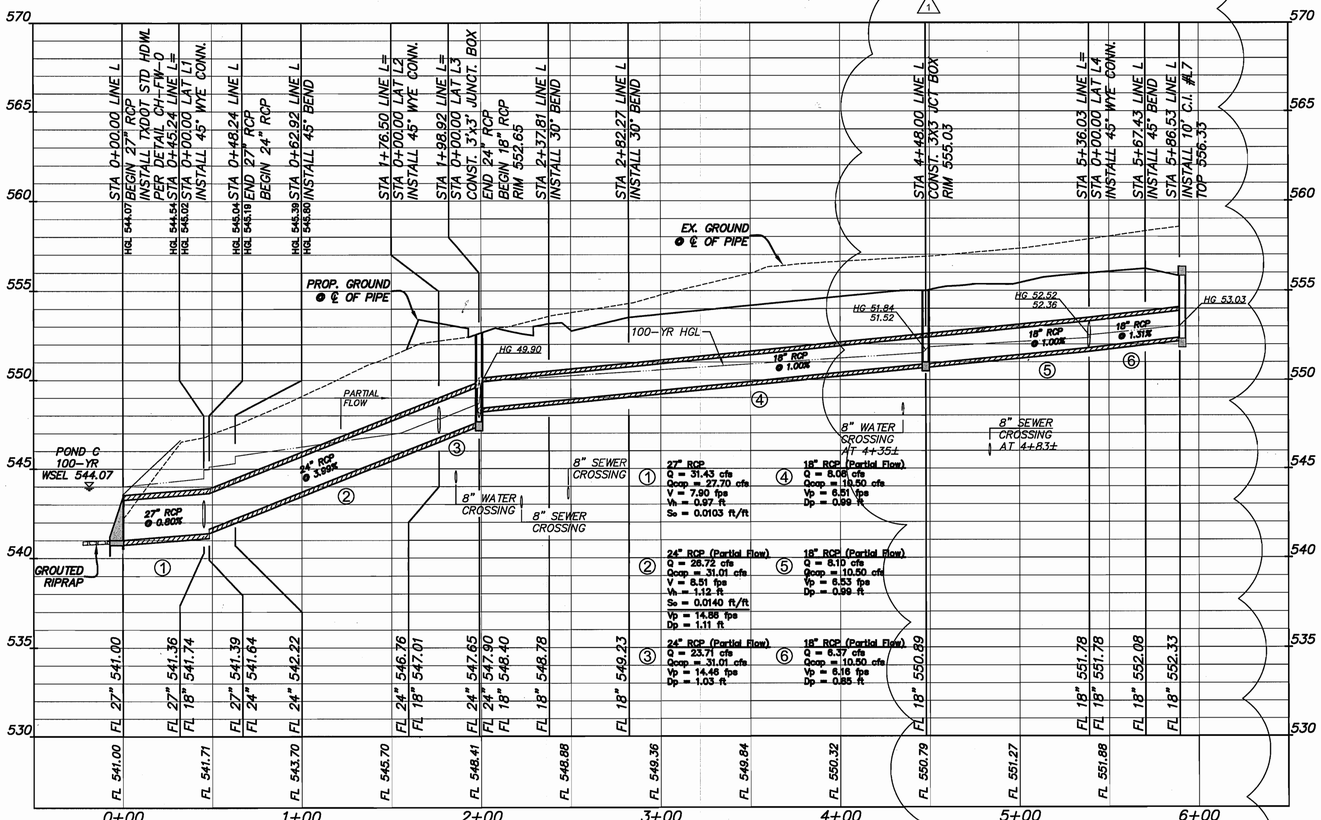

STORM LINE L

H : 1"=40'
V : 1"=4'

CONSTRUCTION RECORDS
DATE: 10·10·2019
BY: TJ
THIS DRAWING INDICATES THE WORK COMPLETED PER INFORMATION SUPPLIED BY THE CONTRACTOR. THE ACCURACY AND COMPLETENESS OF THIS INFORMATION HAS NOT BEEN VERIFIED. ACTUAL ON THE GROUND SURVEY VERIFICATION WAS NOT PERFORMED EXCEPT AS SPECIFICALLY NOTED. TOMDEN ENGINEERING, L.L.P. SHALL NOT BE RESPONSIBLE FOR ANY ERRORS OR OMISSIONS THAT MAY BE INCORPORATED AS A RESULT OF ERRONEOUS INFORMATION PROVIDED BY OTHERS.
TOMDEN ENGINEERING, L.L.P.

1 THIS SHEET SUPPLEMENTS ORIGINAL SHT C23 AND SHALL BE USED FOR THE CONSTRUCTION OF THE CLOUDED INFORMATION ONLY. BINKLEY BARFIELD SHALL BE RESPONSIBLE FOR ALL OTHER DESIGN INFORMATION SHOWN.

NO.	DATE	REVISION
1	10.16.2018	STORM LINE "L" STA 4+48 TO END

DESIGNED BY: TPJ
DRAWN BY: ADC
CHECKED BY: TPJ
JOB NO: 85387
DATE: 10.08.2018
SCALE: AS SHOWN

STATE OF TEXAS — THOMAS P. JONES — 85387 — REGISTERED PROFESSIONAL ENGINEER — 10.08.2018

TOMDEN ENGINEERING, L.L.P.
5815 MEADOWCREST
DALLAS, TX 75230
(214) 679 - 1679
tjones@tomden.com
FIRM No. 19244

PARK PLACE WEST - PHASE III
R. BALLARD SURVEY ABSTRACT NO. 29
ROCKWALL, ROCKWALL COUNTY, TEXAS

STORM SEWER PROFILES SHEET 1
[LINE E, LAT E5 & LINE L]

Sheet No:
C23.1
OF 37