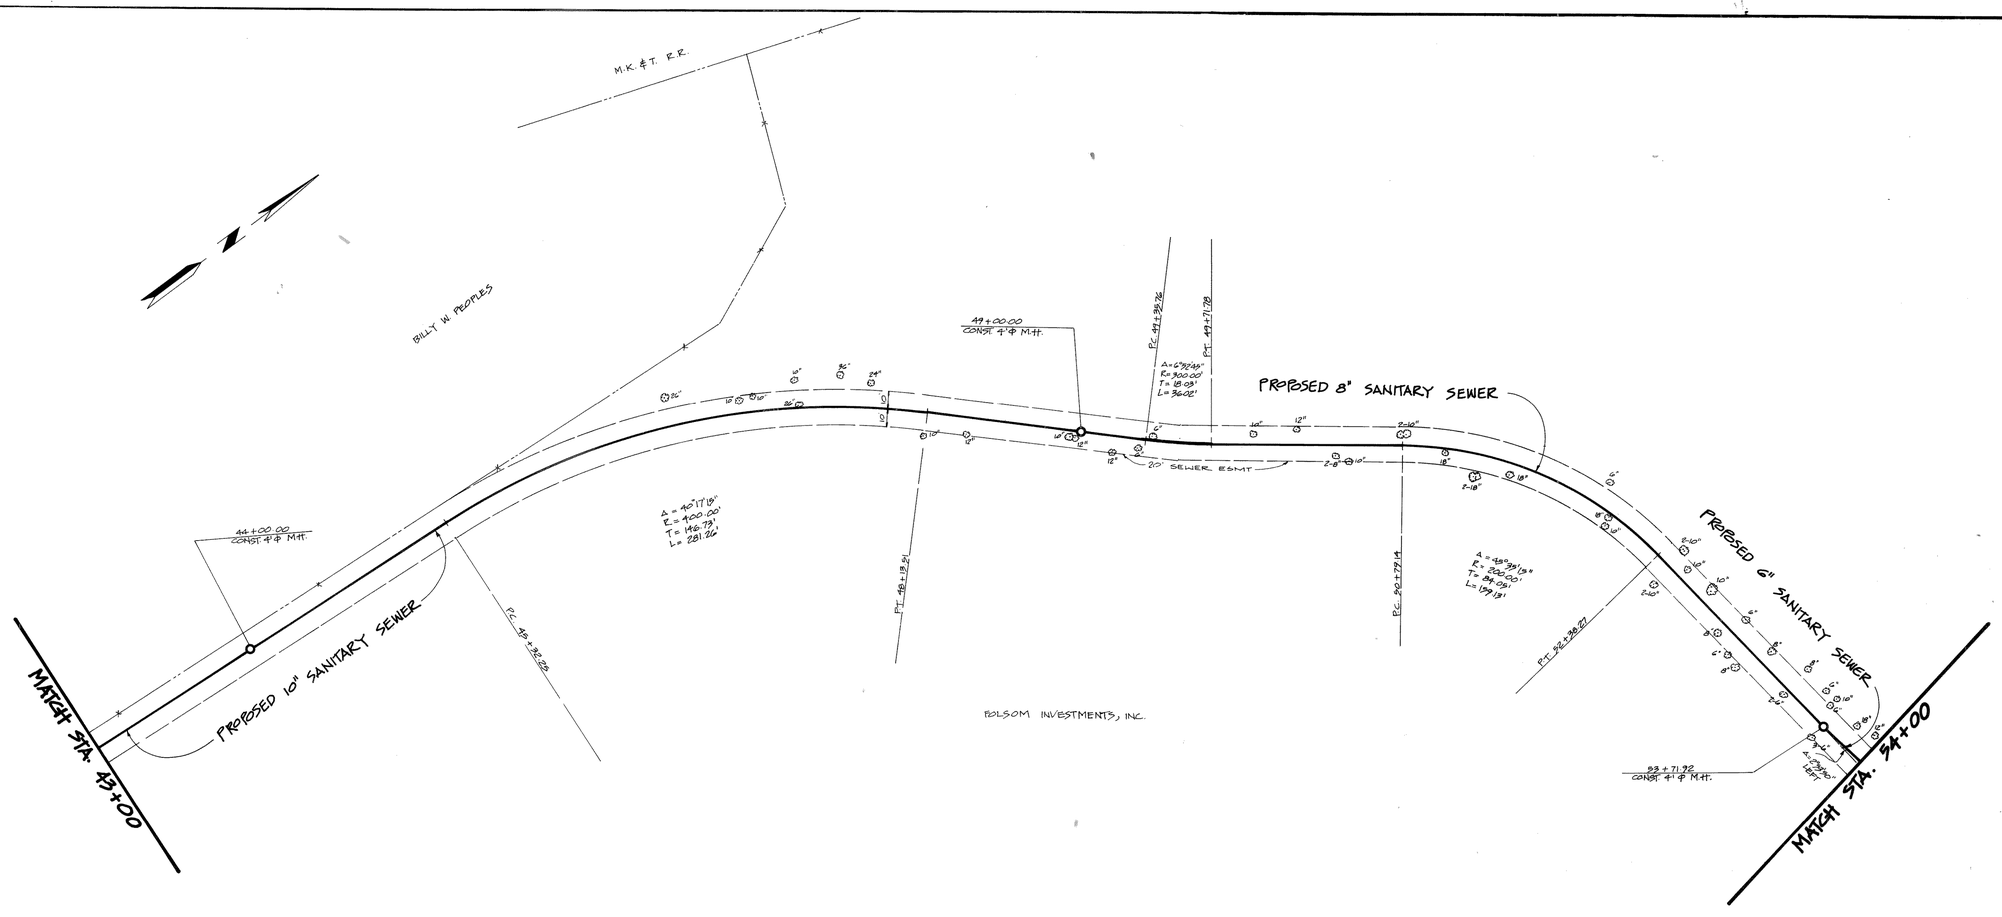

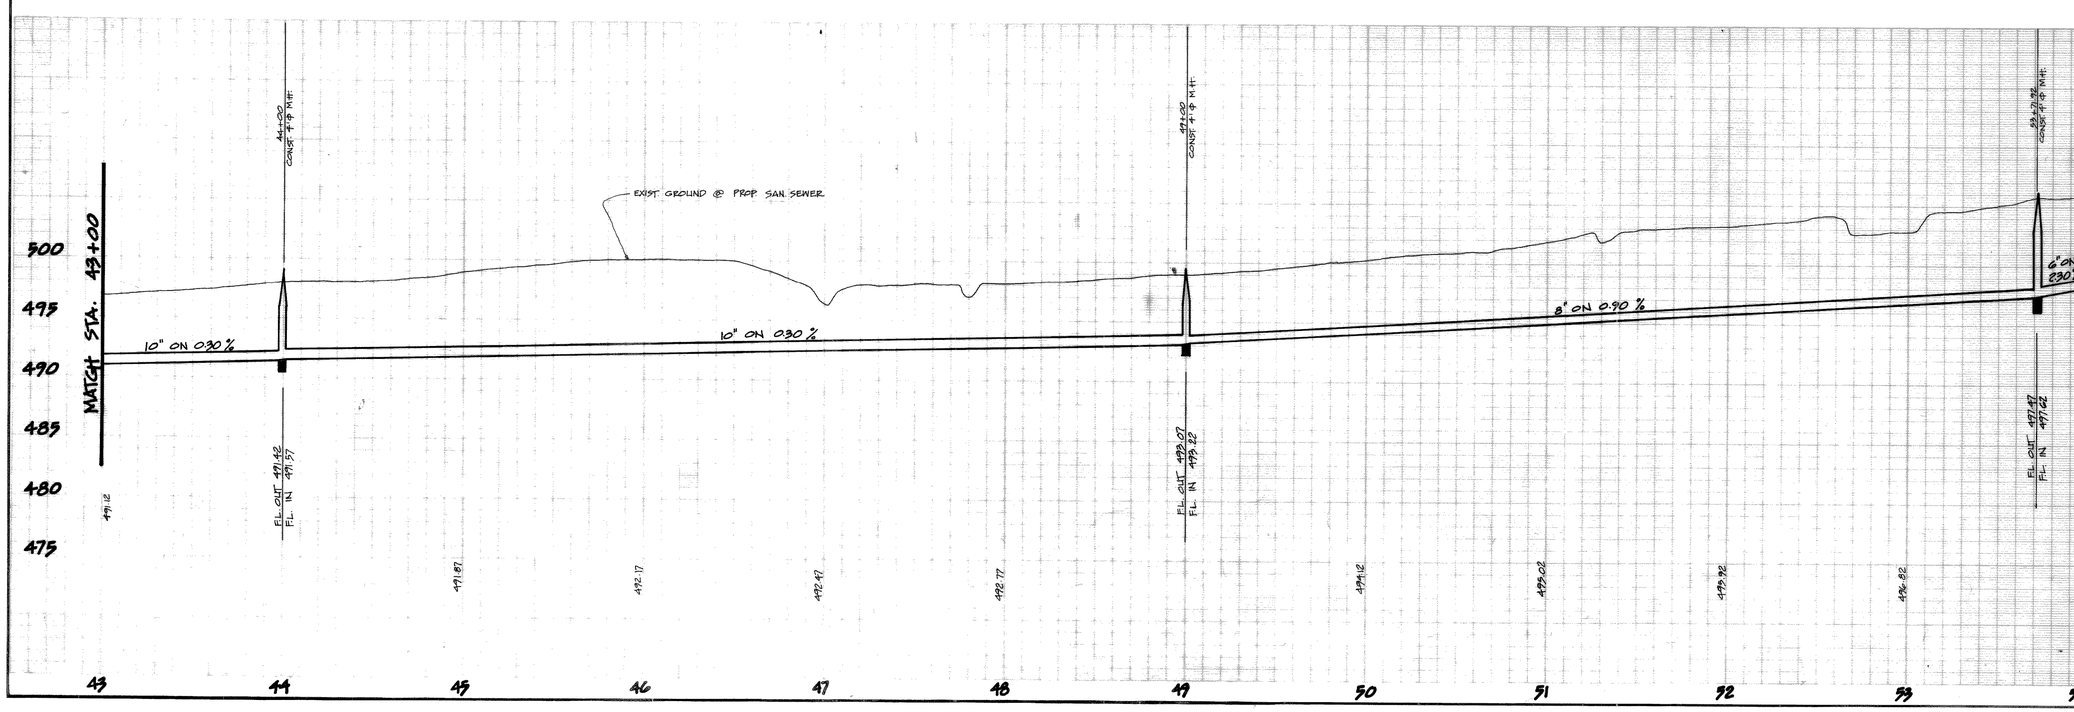

AS BUILT

PROPOSED SANITARY SEWER						
CITY OF ROCKWALL						
OFFSITE SANITARY SEWER LINE						
PEBBIEBROOK APTS.						
HAROLD L. EVANS & CONSULTING ENGINEER						
DESIGN	DRAWN	DATE	SCALE	NOTES	FILE	NO.
H.L.E.	D.M.A.	APRIL, 80	1"=40' H. 1"=5' V.		7924	