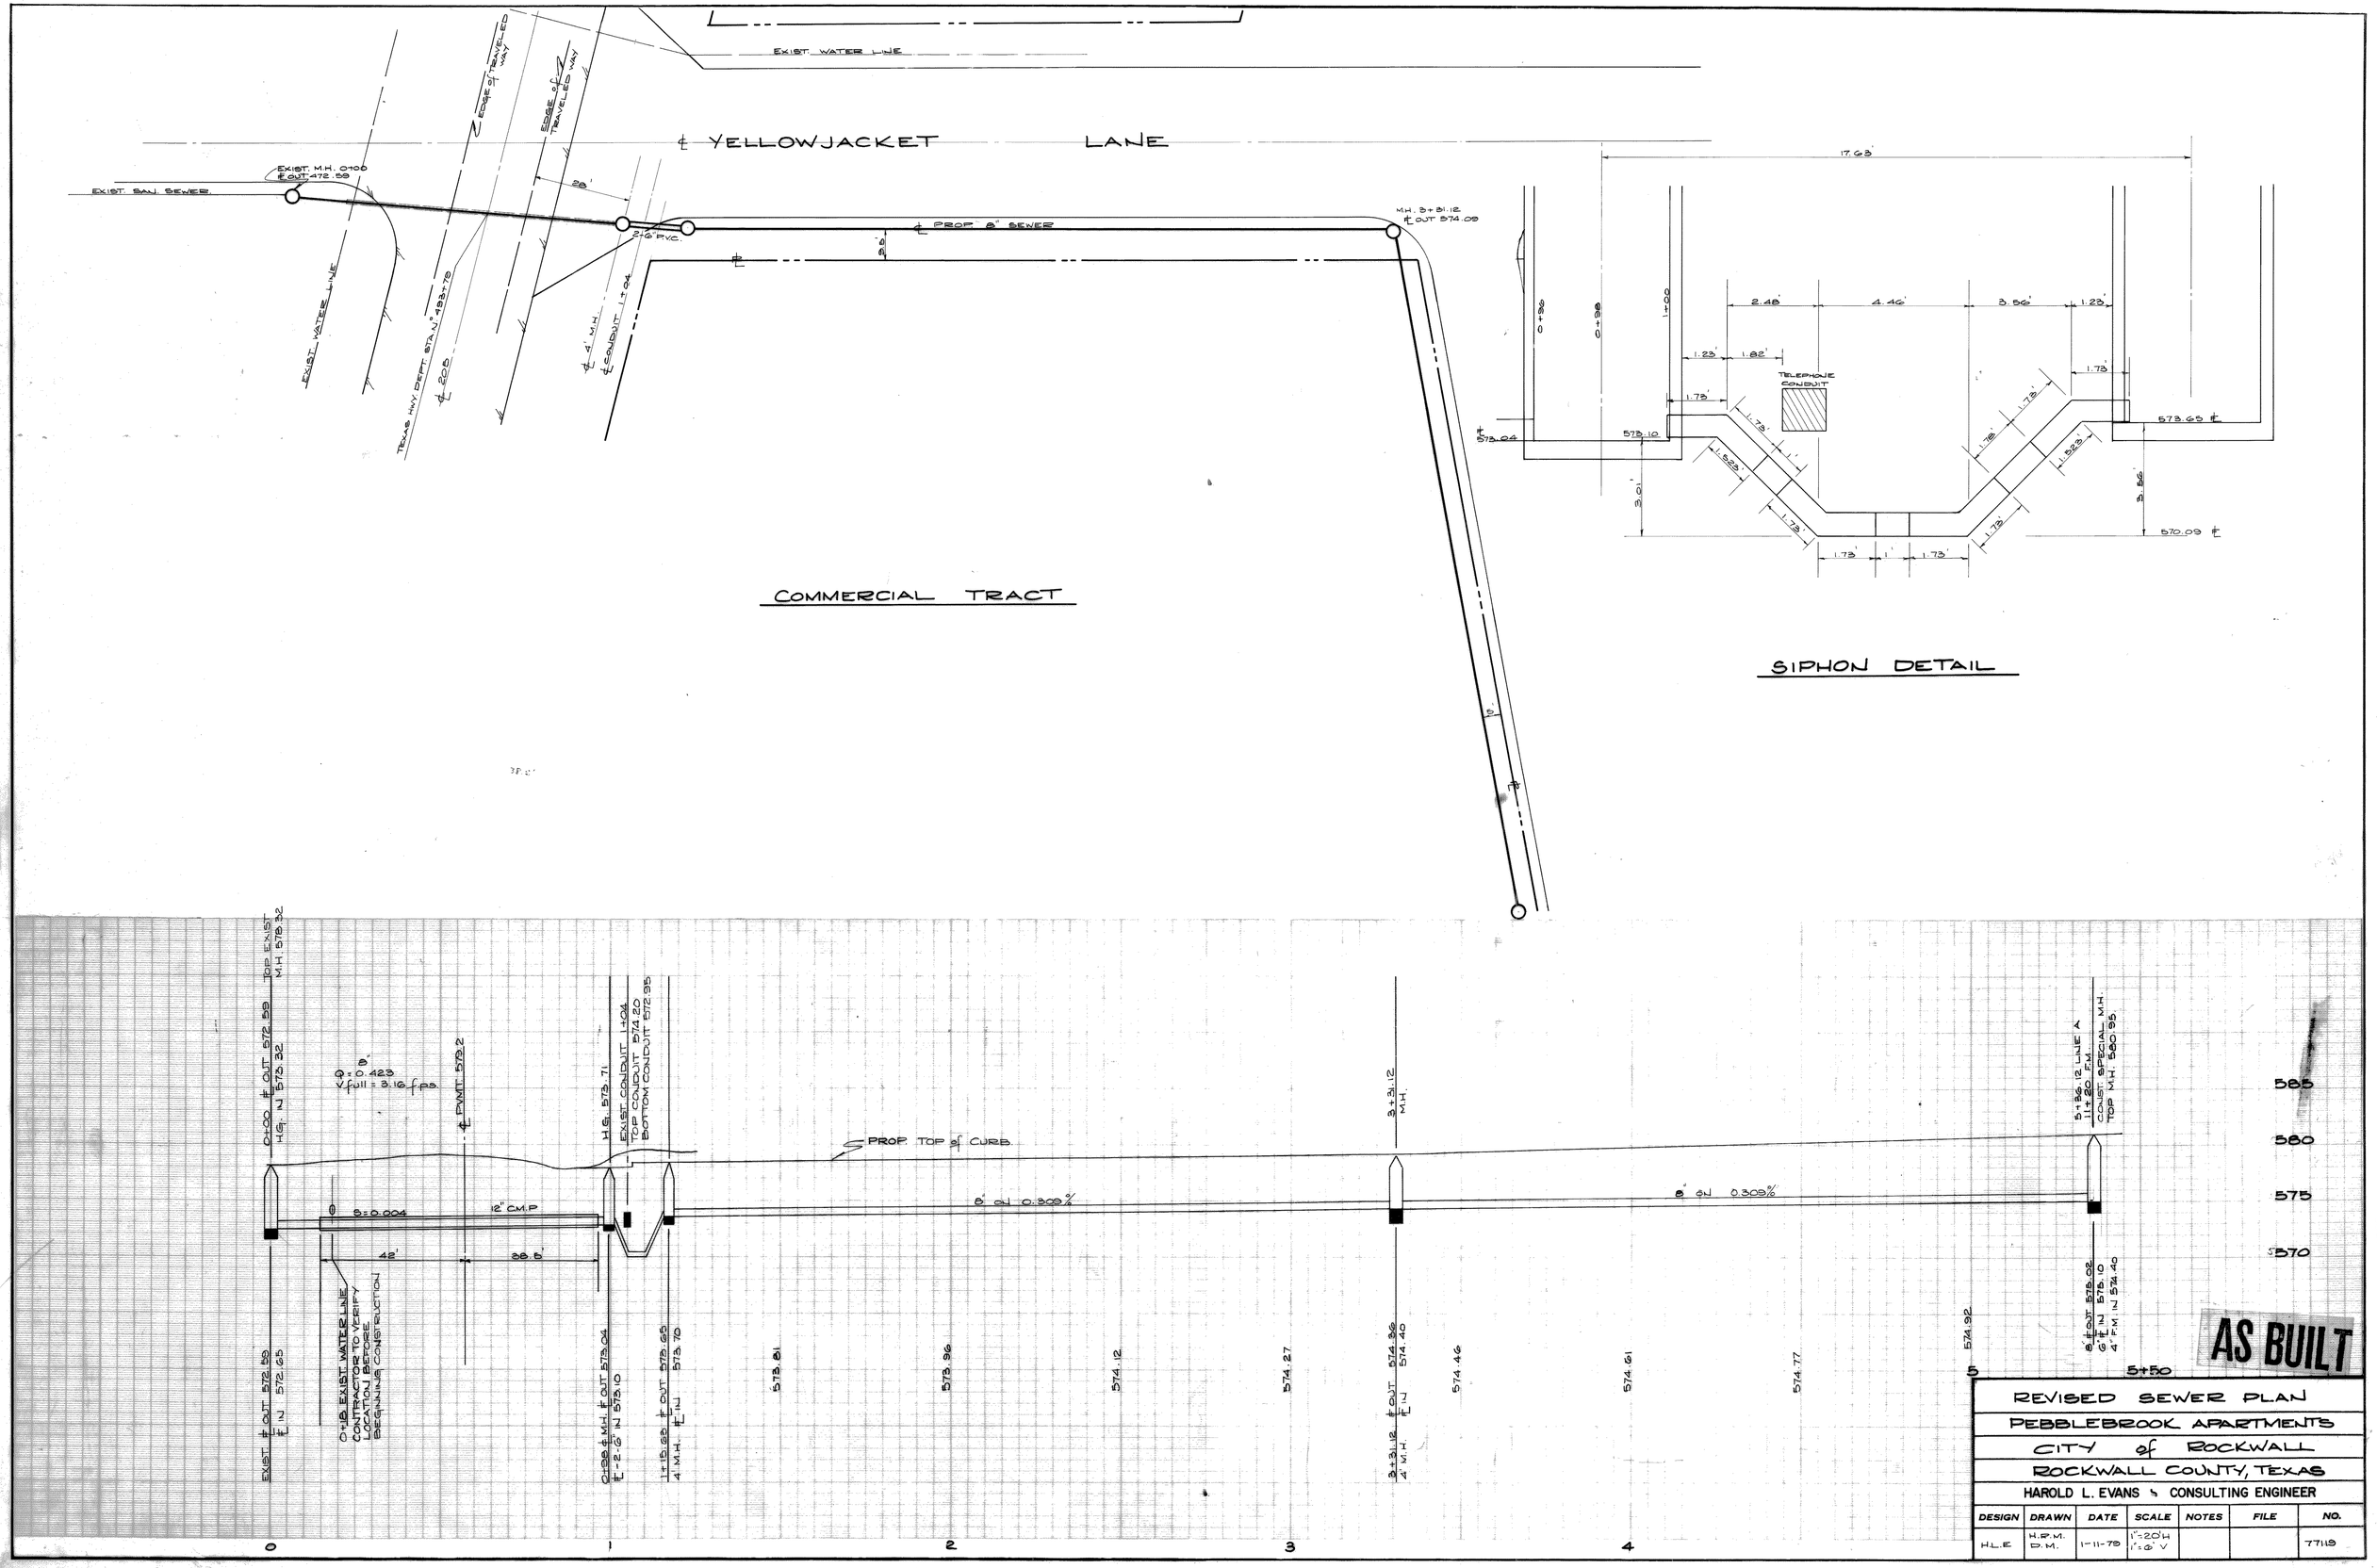

AS BUILT

REVISED SEWER PLAN

PEBBLEBROOK APARTMENTS

CITY of ROCKWALL

ROCKWALL COUNTY, TEXAS

HAROLD L. EVANS & CONSULTING ENGINEER

DESIGN	DRAWN	DATE	SCALE	NOTES	FILE	NO.
H.L.E.	H.R.M. D.M.	1-11-79	1"=20'H 1"=6' V			77119