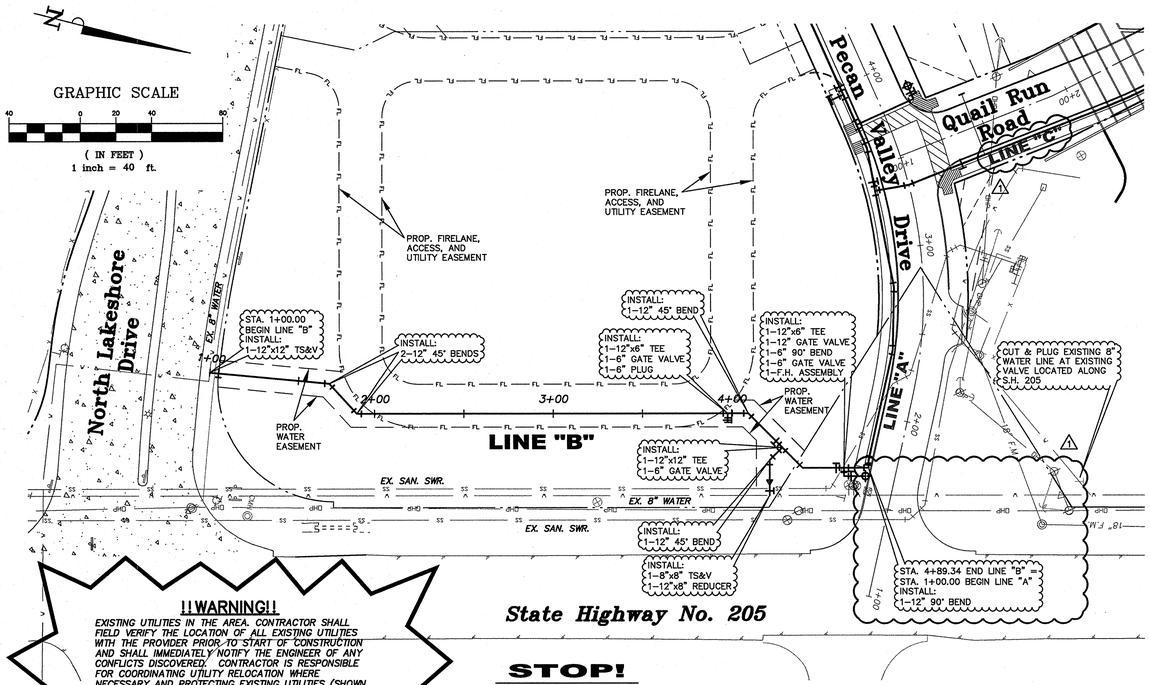

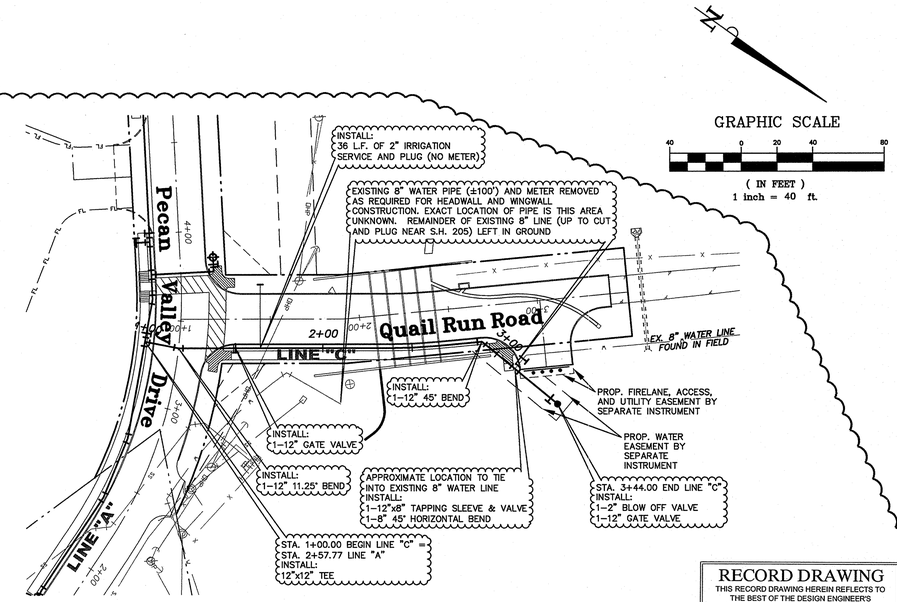

RECORD DRAWING
THIS RECORD DRAWING HEREIN REFLECTS TO THE BEST OF THE DESIGN ENGINEER'S KNOWLEDGE, THE APPROXIMATE LOCATION OF THE CONSTRUCTED WORK, USING INFORMATION AS PROVIDED BY THE CONTRACTORS AND SURVEYED GRADES.

BENCHMARKS

1. X-CUT IN CONCRETE LOCATED ON THE TOP OF CURB AT THE MID POINT OF A CURVE RETURN ON THE NORTH SIDE OF N. LAKESHORE DRIVE AT THE INTERSECTION WITH S.H. 205, 5' SOUTHEAST OF A POWER POLE. ELEVATION: 477.90'
2. ALUMINUM CAP FOUND IN CONCRETE LABELED, "FLOODWAY BOUNDARY" LOCATED ON THE SOUTHEAST SIDE OF N. LAKESHORE DRIVE, 72' SOUTHWEST FROM A PEDESTRIAN COLUMN ON SOUTHEAST END OF A BRIDGE, 23' EAST OF BACK OF CURB. ELEVATION: 470.08'
3. X-CUT IN CONCRETE LOCATED AT THE INTERSECTION OF THE EAST R.O.W. LINE OF RANDOM OAKS DRIVE AND THE NORTH R.O.W. LINE OF QUAIL RUN ROAD, 53' NORTHEAST OF A POWER POLE ON THE SOUTH SIDE OF QUAIL RUN ROAD. ELEVATION: 471.31'

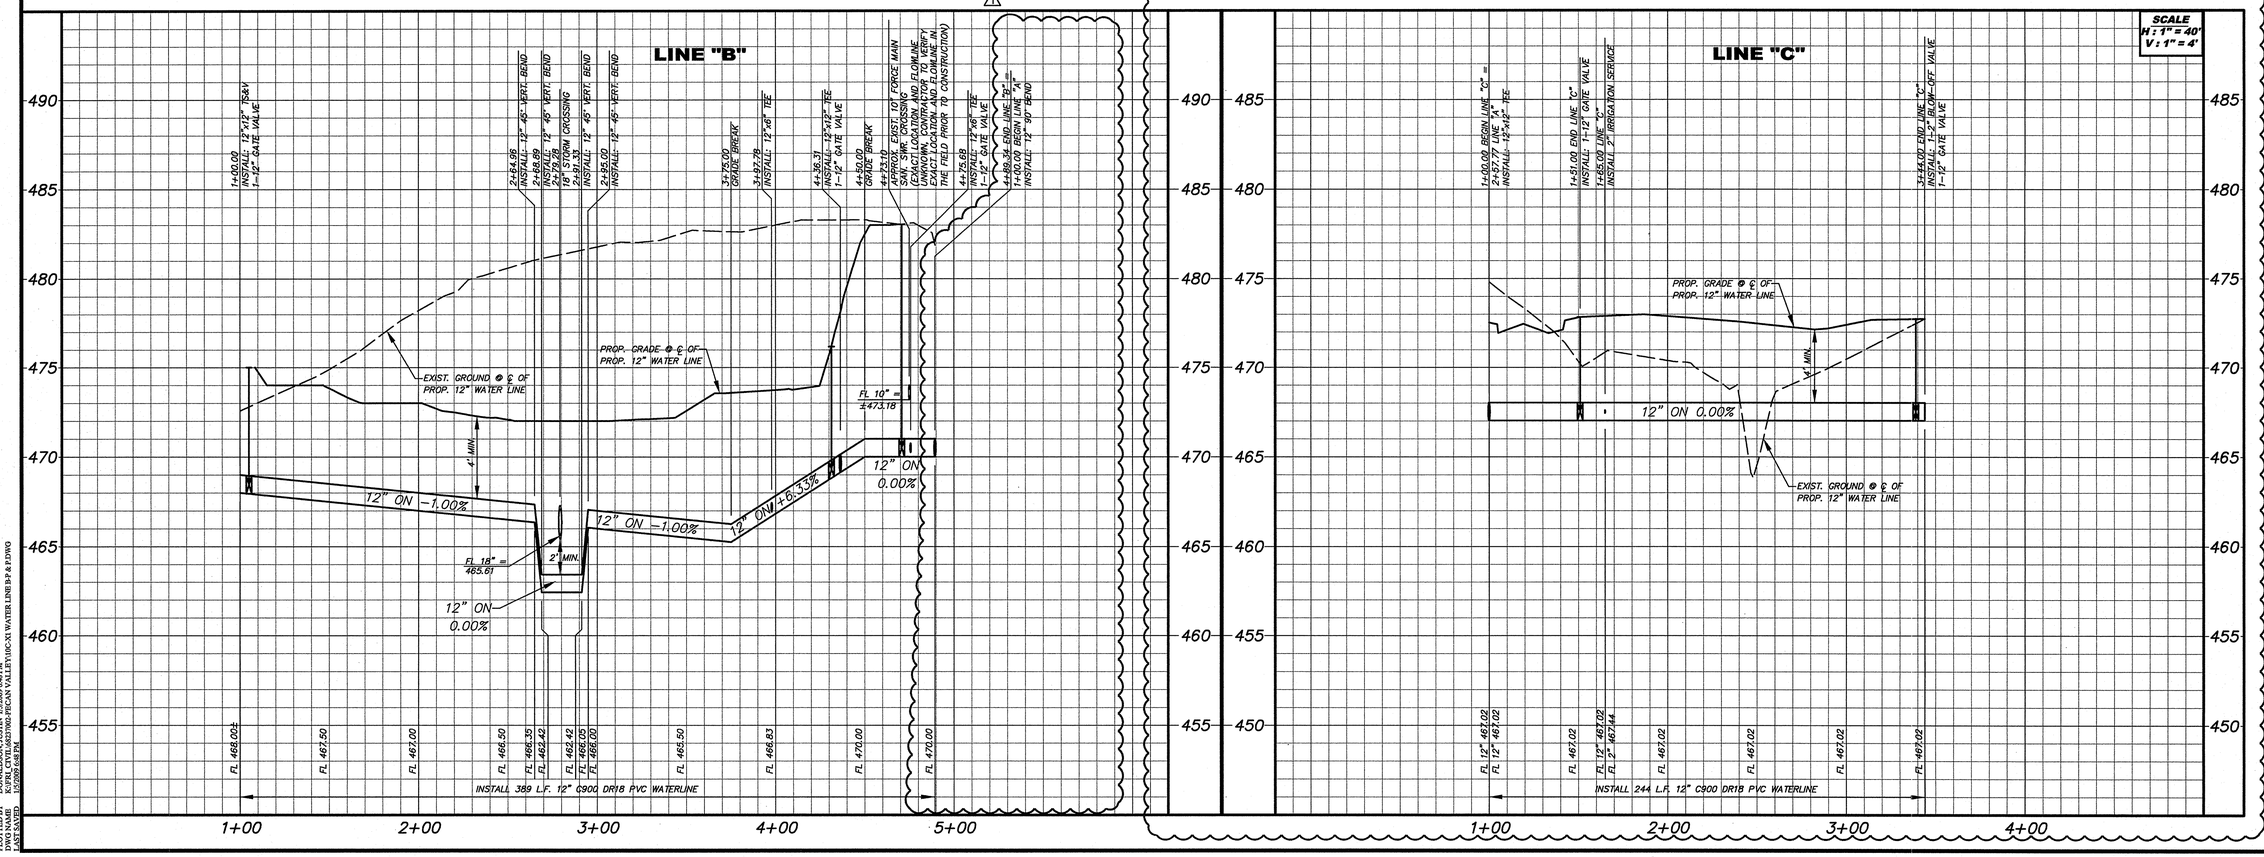

No.	Date	Revisions	App.
1	04/04/08	WATER LINE MODIFICATION	

Kimley-Horn and Associates, Inc.
5750 Genesis Court, Suite 200
Frisco, Texas 75034
Tel. No. (972) 335-3580
Fax No. (972) 335-3779

STATE OF TEXAS
PIETER D. KESSELS
87775
LICENSED PROFESSIONAL ENGINEER
01-06-2009

Pecan Valley Drive and Quail Run Road

City of Rockwall, Texas

WATER LINES "B" AND "C" PLAN AND PROFILE

Scale:	AS NOTED
Designed by:	T.B.B.
Drawn by:	J.J.D./B.B.P.
Checked by:	P.D.K.
Date:	April 04, 2008
Project No.	068237002

SHEET
C-23
OF 47

IMAGES
XREFS
XREF X-24x36-PVD - XREF XBOW-PVD - XREF XAs Built-PVD - XREF XEls Trns-PVD - XREF XEls SnaSwr-PVD - XREF XFlood-PVD - XREF XSnaSwr-PVD - XREF XUtility-PVD - XREF XUtility Profiles-PVD - XREF X-Grid (TALL)-PVD - XREF XEls Utility-PVD - XREF X-Utility-PVD
DWG NAME K:\FRI_CVTI\068237002-PECAN VALLEY\DC-X1 WATER LINE B-P & P.DWG
LAST SAVED 10/2009 6:48 PM