NOTES

1. CONTRACTOR TO REMOVE EXISTING STRIPING AS SHOWN ON THIS PLAN BY LIGHTLY GRINDING ASPHALT WHILE TAKING CAUTION NOT TO BREAK THE SEAL ON THE ASPHALT. CONTRACTOR SHALL THEN MICRO-SEAL GROUND AREAS AND ENSURE A SMOOTH FINISH WITH SURROUNDING EXISTING PAVEMENT TO THE SATISFACTION OF TxDOT.

GRAPHIC SCALE

30 0 15 30 60

(IN FEET)
1 inch = 30 ft.

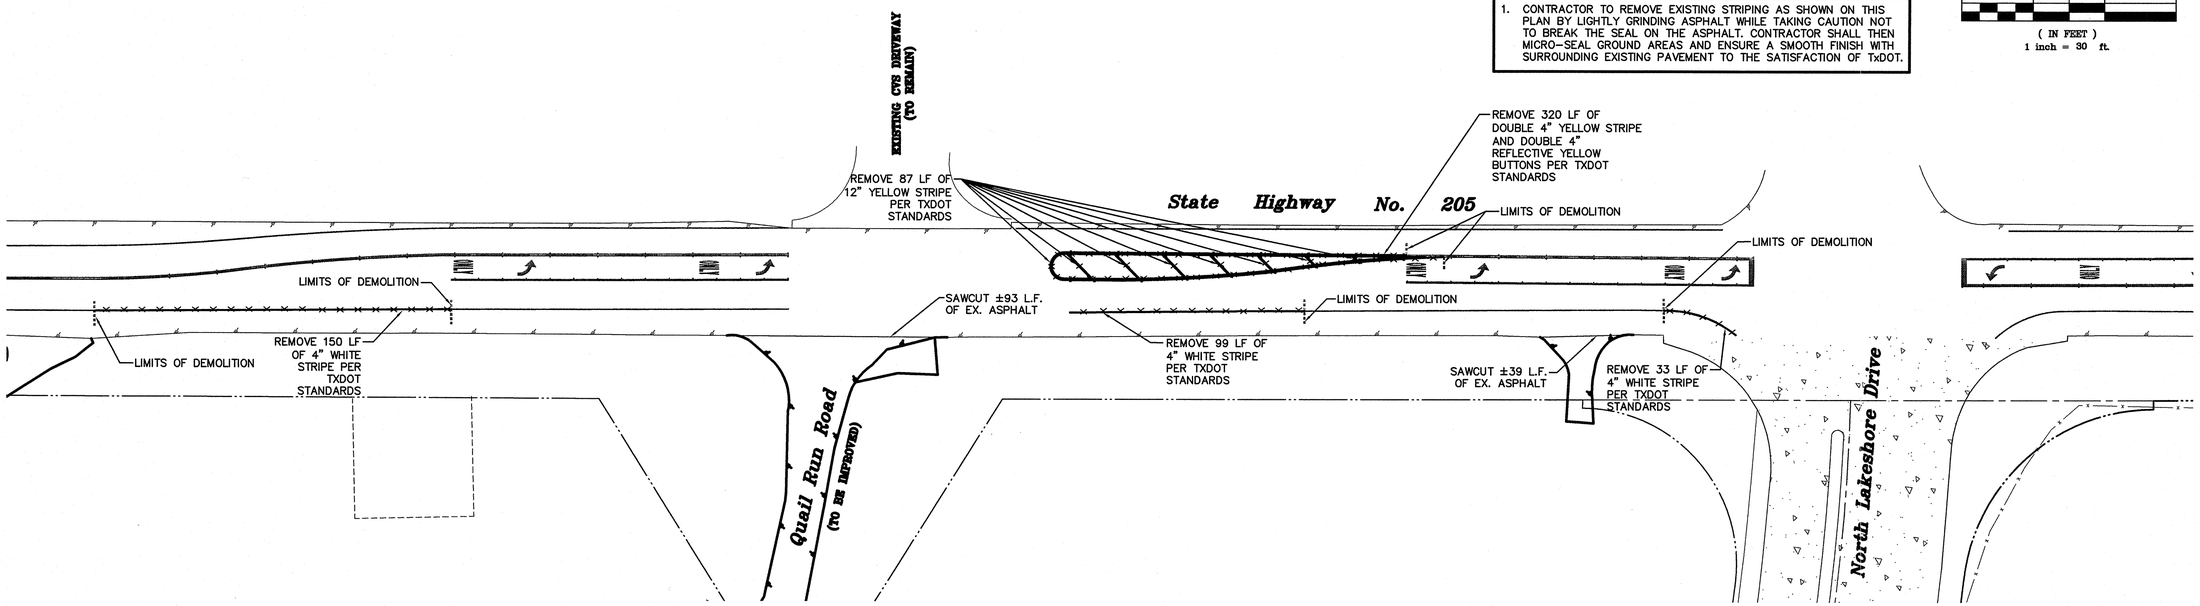

PAVEMENT MARKING REMOVAL PLAN

NOTES

1. REFER TO SHEETS C-45 AND C-46 FOR DETAILS OF REFLECTIVE BUTTONS
2. REFER TO SHEET C-47 FOR PAVEMENT ARROW AND LETTERING DETAILS

GRAPHIC SCALE

30 0 15 30 60

(IN FEET)
1 inch = 30 ft.

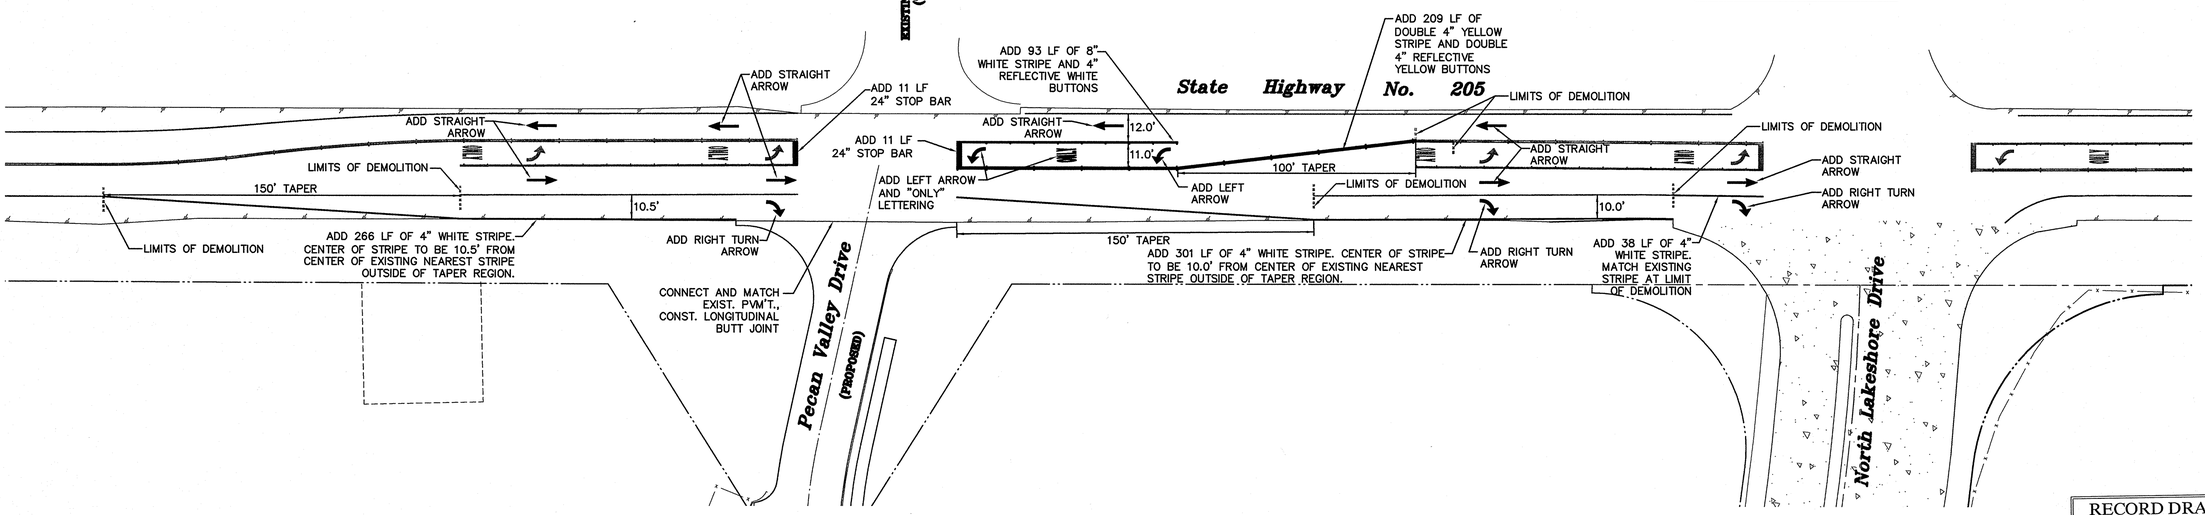

PAVEMENT MARKING RE-STRIPING PLAN

RECORD DRAWING
THIS RECORD DRAWING HEREIN REFLECTS TO THE BEST OF THE DESIGN ENGINEER'S KNOWLEDGE, THE APPROXIMATE LOCATION OF THE CONSTRUCTED WORK, USING INFORMATION AS PROVIDED BY THE CONTRACTORS AND SURVEYED GRADES.

No.	Date	Revisions	App.

Kimley-Horn and Associates, Inc.
5750 Genesis Court, Suite 200
Frisco, Texas 75034
Tel. No. (972) 335-3580
Fax No. (972) 335-3779

STATE OF TEXAS
PIETER D. KESSELS
87775
LICENSED PROFESSIONAL ENGINEER
02-27-2008

Pecan Valley Drive and Quail Run Road
City of Rockwall, Texas

S.H. 205 PAVEMENT MARKING REMOVAL & RE-STRIPING PLAN

Scale:	AS NOTED
Designed by:	T.B.B.
Drawn by:	J.J.D./B.B.P.
Checked by:	P.D.K.
Date:	Feb. 5, 2008
Project No.	068237002

SHEET C-27 OF 47

IMAGES:
XREFS: X-Ch-Sh-PVD , XREF XROW-PVD , XREF X-As Built-PVD , XREF XRoad-PVD , XREF XEx-striping SH 205 , XREF X-ReStriping SH 205 , XREF XHatch-PVD
PLOTTED BY: DONALDSON, JUSTIN 2/28/2008 5:40 PM
PLOT SCALE: 1:1 PAGE SETUP: ANSI E LANDSCAPE
LAST SAVED: 2/11/2008 5:37 PM