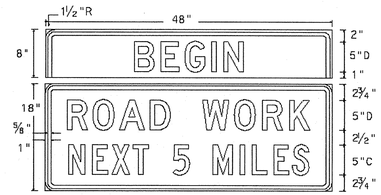

SG20-1 w/plaque
48" X 26"

Letters - Black
Numbers - Black
Border - Black
Background - Orange Refl.

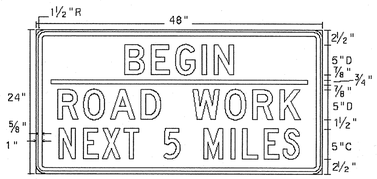

SG20-5T
48" X 24"

Letters - Black
Numbers - Black
Border - Black
Background - Orange Refl.

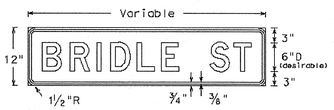

M4-9N
Variable X 12"

Letters - Black
Border - Black
Background - Orange Refl.

The M4-9R, L or S sign is to be used to detour local streets or roads that are not a State or Federal numbered highway; however, it should not be used in lieu of the M4-10 sign at the beginning of the detour or to detour State or Federal numbered routes.

Also, when the M4-9R, L or S sign is used, a sign (M4-9N) with the name of the street being detoured may be mounted above it.

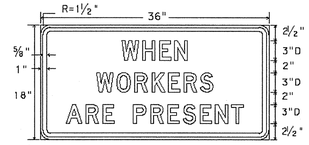

ER20-5
Plaque
36" X 18"

Letters - Black
Border - Black
Background - White Refl.

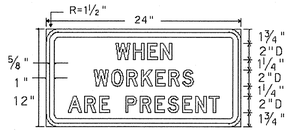

R20-5
Plaque
24" X 12"

Letters - Black
Border - Black
Background - White Refl.

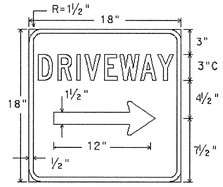

D-70a
18" X 18"

Letters - White Refl.
Symbol - White Refl.
Border - White Refl.
Background - Blue Refl.

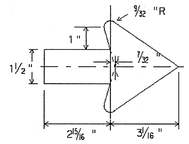

D-70S
42" X 14"

Letters - White Refl.
Symbol - White Refl.
Border - White Refl.
Background - Blue Refl.

* Alternate first line legend for D-70S

RESTAURANT | D70R 4"C
BUSINESS | D70B 4"C
MOTEL | D70M 4"C
GAS | D70G 4"C

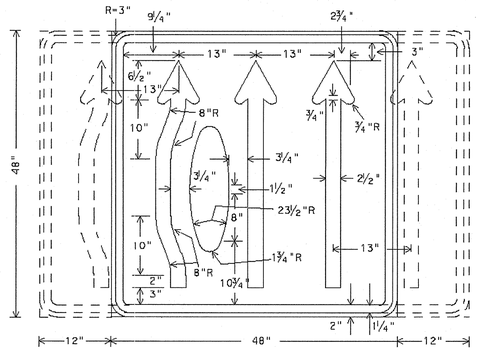

CW24-2
Var. X 48"

A mirror image may be used to show proper lane alignment.

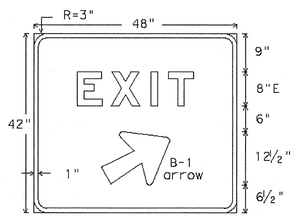

E5-1a
48" X 42"

Letters - White Refl.
Arrow - White Refl.
Border - White Refl.
Background - Green Refl.

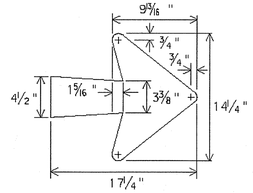

B-1 Arrow Detail

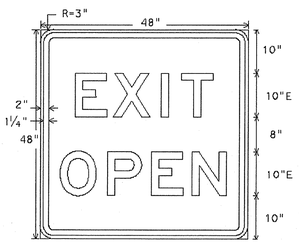

E5-2
48" X 48"

Letters - Black
Border - Black
Background - Orange Refl.

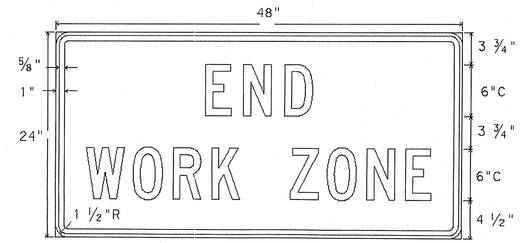

G20-2b
48" X 24"

Letters - Black
Border - Black
Background - Orange Refl.

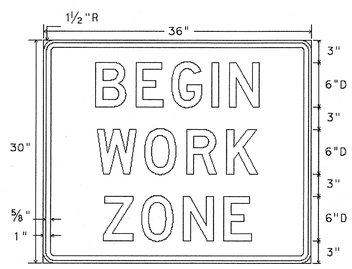

EG20-9T
36" X 30"

Letters - Black
Border - Black
Background - Orange Refl.

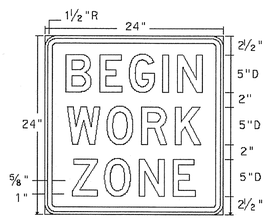

G20-9T
24" X 24"

Letters - Black
Border - Black
Background - Orange Refl.

DISCLAIMER
The use of this standard is governed by the "Texas Engineering Practice Act". No warranty of any kind is made by TxDOT for any purpose whatsoever. TxDOT assumes no responsibility for the conversion of this standard to other formats or for incorrect results or damages resulting from its use.

Only pre-qualified products shall be used. A copy of the "Compliant Work Zone Traffic Control Devices List" (CWZTCD) describes pre-qualified products and their sources and may be obtained by contacting:

Standards Engineer
Traffic Operations Division - TE
Texas Department of Transportation
125 East 11th Street
Austin, Texas 78701-2483
Phone (512) 416-3120
Fax (512) 416-3299

Instructions to locate the "CWZTCD" on TxDOT website are:

Start at website - www.dot.state.tx.us
Click on "About TxDOT",
Click on "Organizational Chart",
Click on Traffic Operations Box,
Click on "Compliant Work Zone Traffic Control Devices",
Click on "View PDF".
This site is printable.

DEPARTMENT MATERIAL SPECIFICATIONS

PLYWOOD SIGN BLANKS	DMS-7100
ALUMINUM SIGN BLANKS	DMS-7110
FLAT SURFACE REFLECTIVE SHEETING	DMS-8300
VINYL NON-REFLECTIVE DECAL SHEETING	DMS-8320

COLOR	USAGE	REFLECTIVE SHEETING OR OTHER MATERIAL
BLUE	BACKGROUND	TYPE C (HIGH SPECIFIC INTENSITY)
RED	BACKGROUND	TYPE C (HIGH SPECIFIC INTENSITY)
GREEN	BACKGROUND	TYPE C (HIGH SPECIFIC INTENSITY)
ORANGE	BACKGROUND	TYPE E (FLUORESCENT PRISMATIC)
WHITE	BACKGROUND	TYPE C (HIGH SPECIFIC INTENSITY)
YELLOW	BACKGROUND	TYPE C (HIGH SPECIFIC INTENSITY)
BLACK	LEGEND & BORDERS	VINYL NON-REFLECTIVE DECAL SHEETING
WHITE	LEGEND & BORDERS	TYPE C (HIGH SPECIFIC INTENSITY)

STANDARD PLANS
Texas Department of Transportation
Traffic Operations Division

BARRICADE AND CONSTRUCTION REGULATORY & GUIDE SIGNS STANDARDS

12 of 12 BC(12)-03

©TxDOT February 1998 DN- GRB CK- BAS DW- FDN CK- CAL

REVISIONS	STATE DISTRICT	FEDERAL REGION	FEDERAL AID PROJECT	SHEET
10-99				
11-02		6		

COUNTY	CONTROL	SECTION	JOB	HIGHWAY

109C

RECORD DRAWING
THIS RECORD DRAWING HEREIN REFLECTS TO THE BEST OF THE DESIGN ENGINEER'S KNOWLEDGE, THE APPROXIMATE LOCATION OF THE CONSTRUCTED WORK, USING INFORMATION AS PROVIDED BY THE CONTRACTORS AND SURVEYED GRADES.

LEVELS DISPLAYED
1 2 3 4 5 6 7 8 9 10 11 12 13 14 15 16
17 18 19 20 21 22 23 24 25 26 27 28 29 30 31 32
33 34 35 36 37 38 39 40 41 42 43 44 45 46 47 48
49 50 51 52 53 54 55 56 57 58 59 60 61 62 63

ACC:

IMAGES:
XREFS:
PLOTTED BY: DONALDSON, JUSTIN 2/25/2008-5:51 PM
FILENAME: BARRICADE1-12 (Page-12(1)-DONALDSON, JUSTIN 2/25/2008-5:51 PM
LAST SAVED: 11/4/2008-5:18 PM

Kimley-Horn and Associates, Inc.
5750 Genesis Court, Suite 200
Frisco, Texas 75034
Tel. No. (972) 335-3580
Fax No. (972) 335-3779

STATE OF TEXAS
PIETER D. KESSELS
87775
LICENSED
PROFESSIONAL ENGINEER
02-27-2008

Pecan Valley Drive and Quail Run Road
City of Rockwall, Texas

TxDOT BARRICADE AND CONSTRUCTION REGULATORY & GUIDE SIGNS STANDARDS BC(12)-03

Scale: Not To Scale
Designed by: TxDOT
Drawn by: TxDOT
Checked by: P.D.K.
Date: Feb. 27, 2008
Project No. 068237002

SHEET
C-44
OF 47