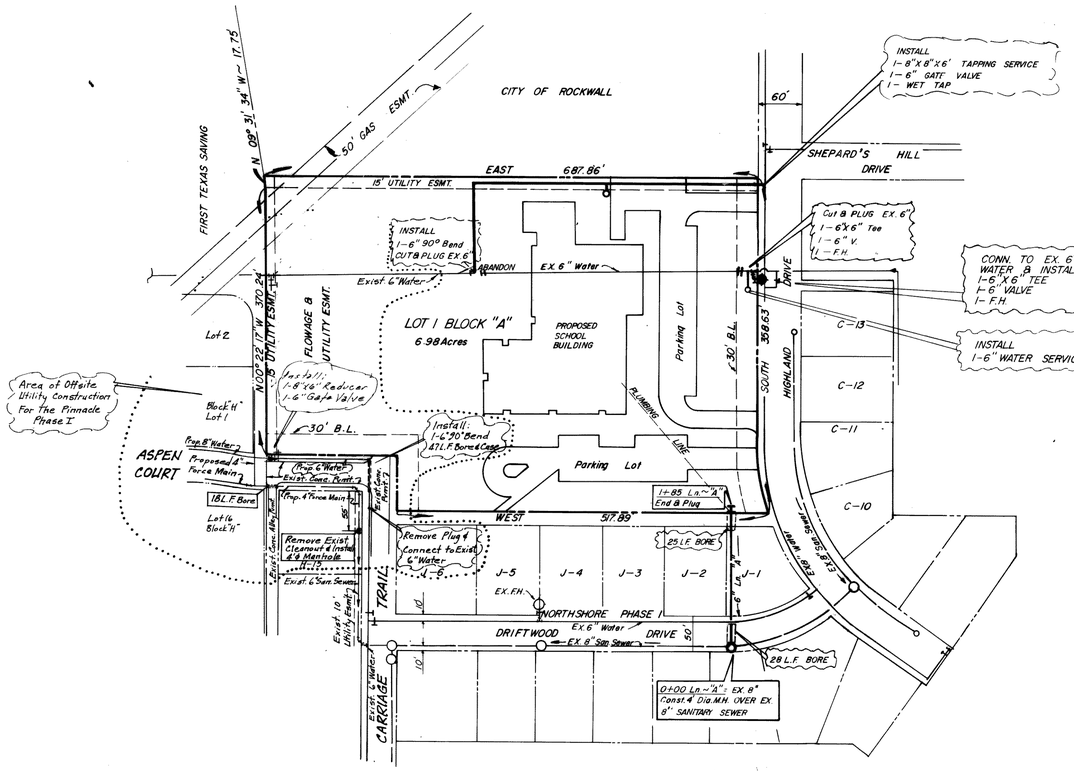

STATE OF TEXAS
HAROLD L. EVANS
23155
REGISTERED PROFESSIONAL ENGINEER

Rev. 5-14-91

AS-BUILT

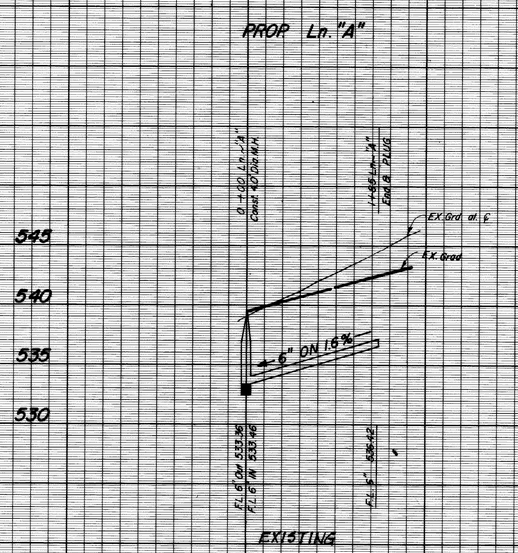

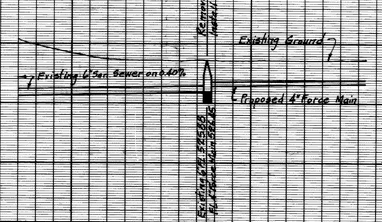

EXTENSION OF PROPOSED 4" FORCE MAIN-CONTINUED FROM SHEET NO. 8
PHASE I

8A
13

OFF-SITE UTILITY PLAN						
THE PINNACLE - PHASE I						
CITY OF ROCKWALL						
ROCKWALL COUNTY, TEXAS						
HAROLD L. EVANS ..... CONSULTING ENGINEER						
DESIGN	DRAWN	DATE	SCALE	NOTES	FILE	NO.
D.H.	D.H.	NOV. 83	1"=100' 1"=2' V			83227

Rev. 3-14-91

90115